


14-00-151-000-002  
14-00-151-000-012  
14-00-151-000-013  
14-E

PPN 14-00-151-000-002  
012  
013

MAP 14-E 43982

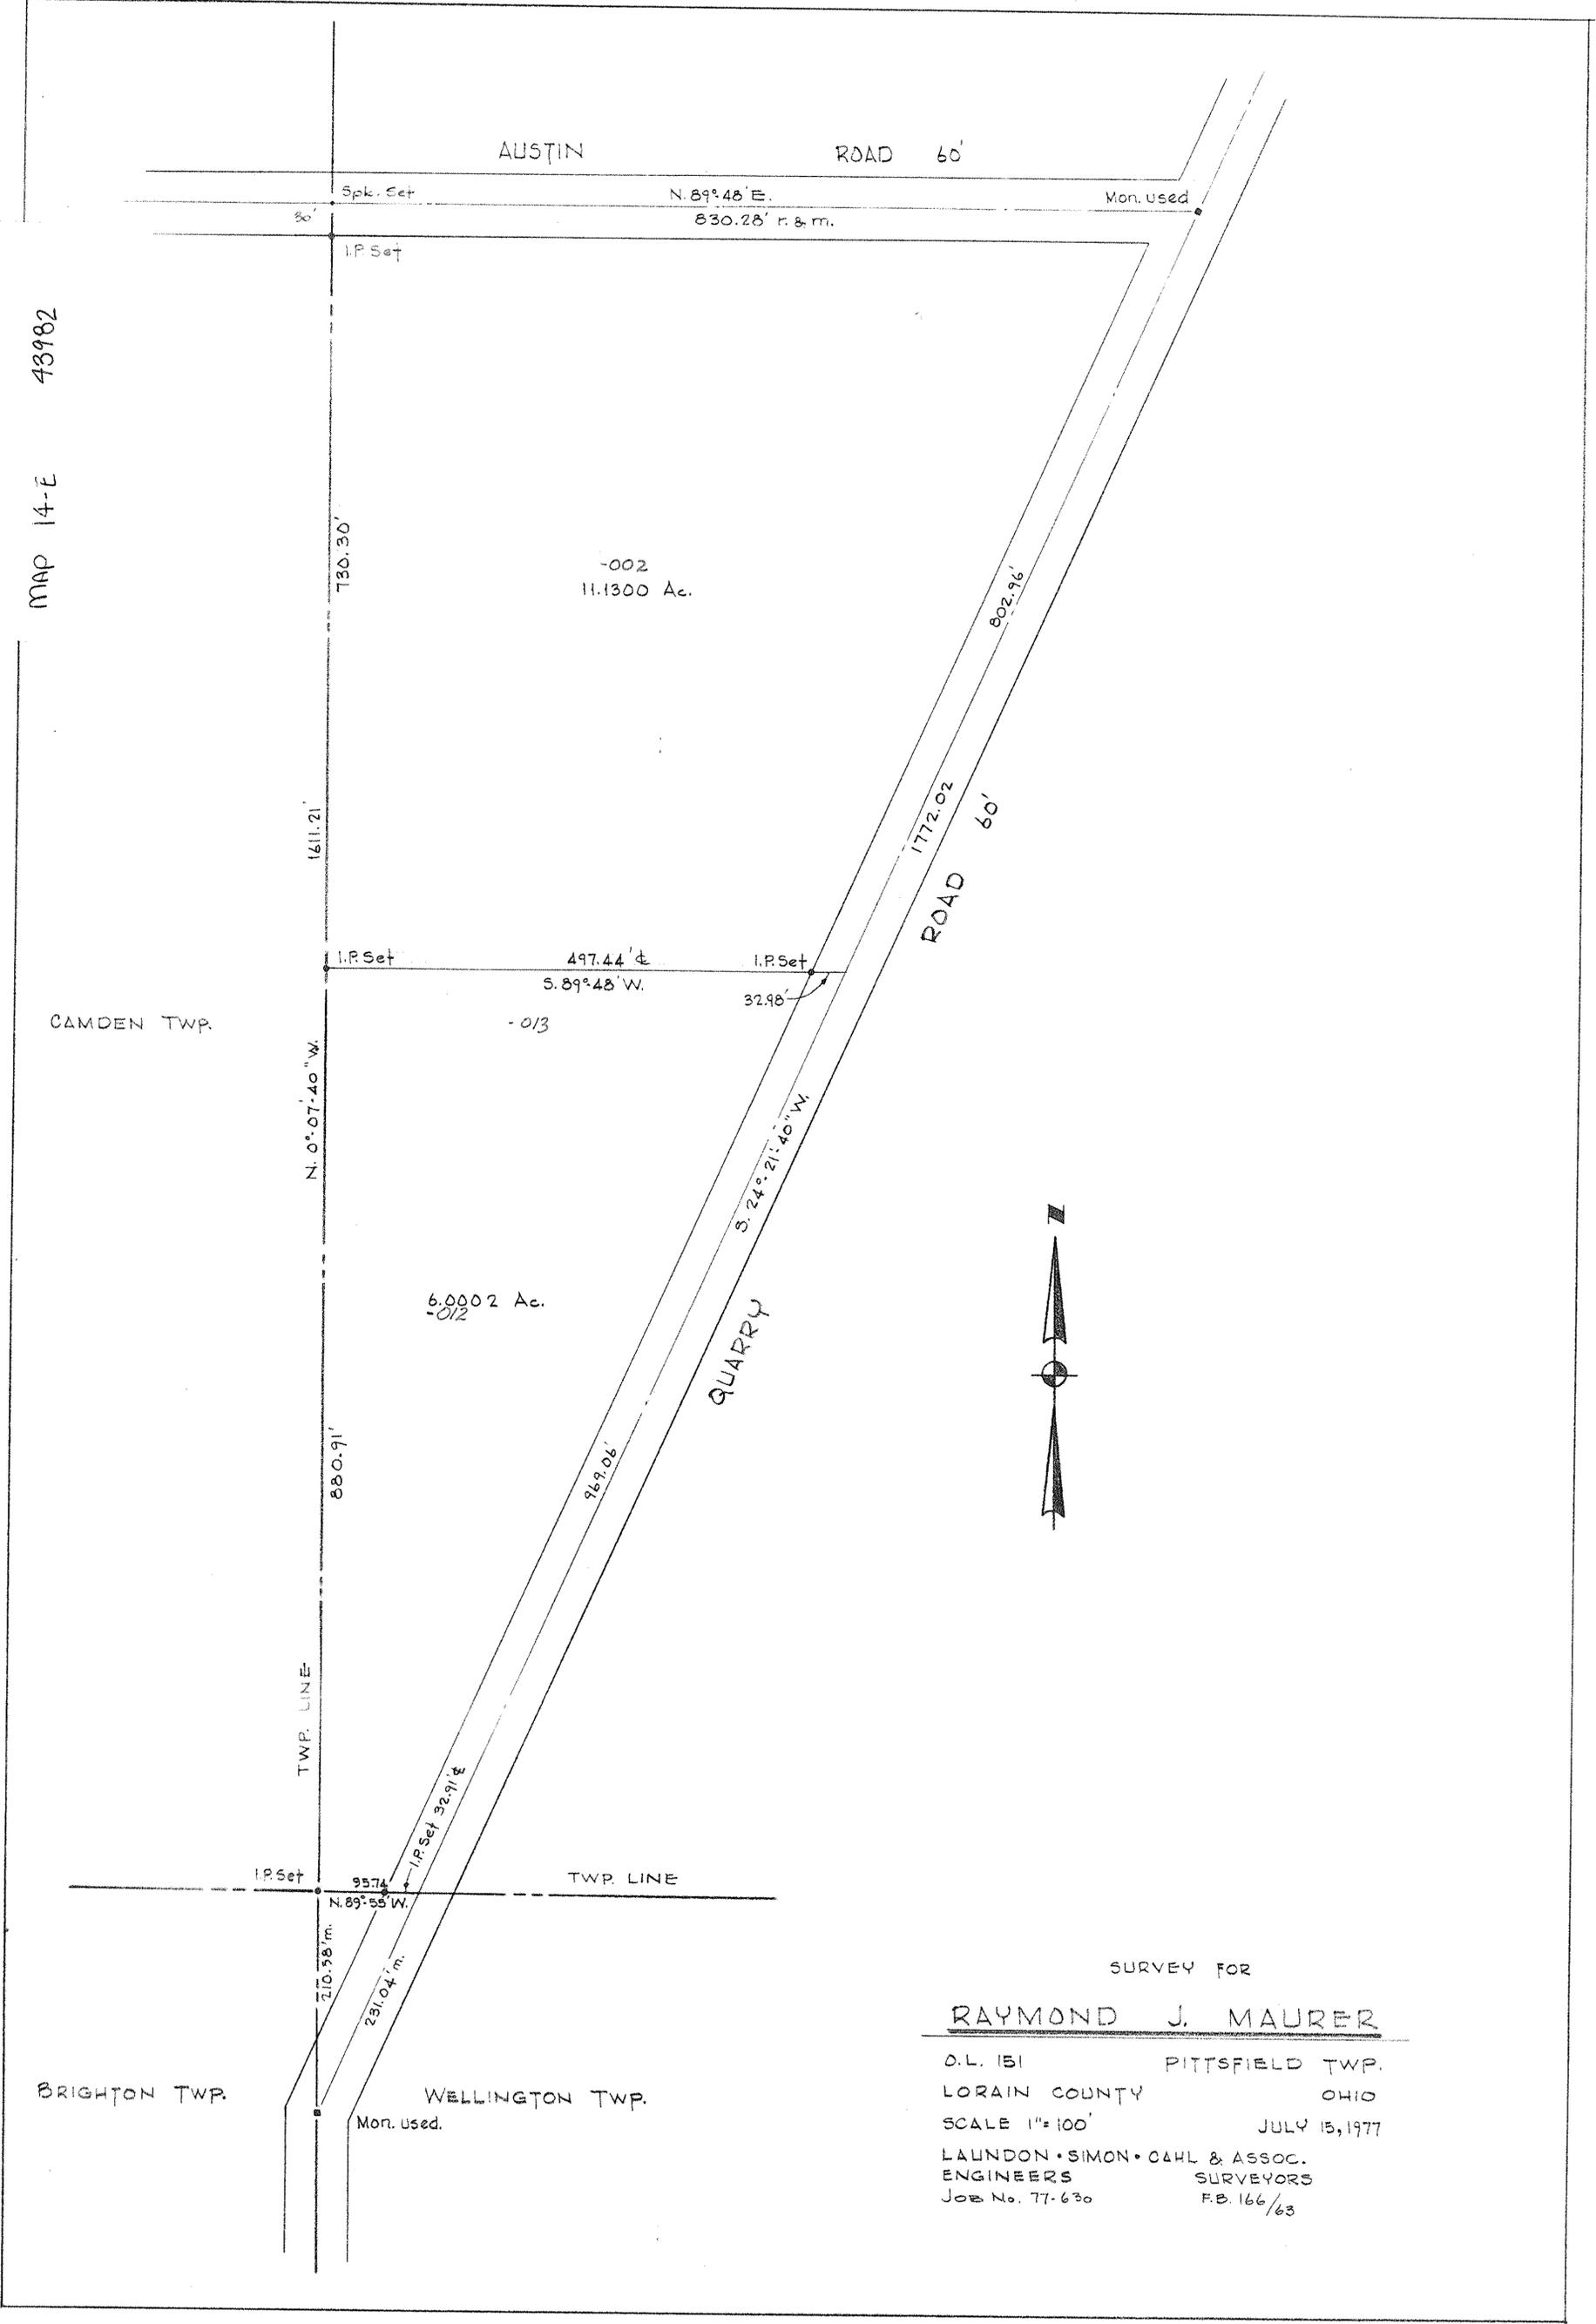

SURVEY FOR  
RAYMOND J. MAURER  
 O.L. 151                      PITTSFIELD TWP.  
 LORAIN COUNTY                      OHIO  
 SCALE 1"=100'                      JULY 15, 1977  
 LAUNDON • SIMON • CAHL & ASSOC.  
 ENGINEERS                      SURVEYORS  
 JOB No. 77-630                      F.B. 166/63