

07-00-039-000-028
07-00-039-000-027
7-E
7-00-039-B

Cleveland Road 60'

213.85 rec. N. 88° 23' E. 229.27

I.P. Fd. I.P. Fd. 2.33' S.

3007 I.P. Fd. 5.2° 26' 30" W 124.72
I.P. set 100.50' N. 88° 23' E. L 31.80'
I.P. set

3rd. School District
12-19-1828 Vol. B Pg. 300

R. W. Beckett Corp'n.
8-11-47 D.V. 419 Pg 215

N. 3° 21' 27" E.
1076.46

10.0208 Acres


981.58
S. 2° 26' 30" W

Geo. and Hazel Kline & Robt. W and Mildred L. Poller
2-24-64 D.V. 867 Pg. 606

I.P. Fd. 23.74 N of &

N. 83° 23' W 320.00'
& exist. ditch

97.31
S. 79° 40' 10" W.
I.P. Fd. 20' N. of &

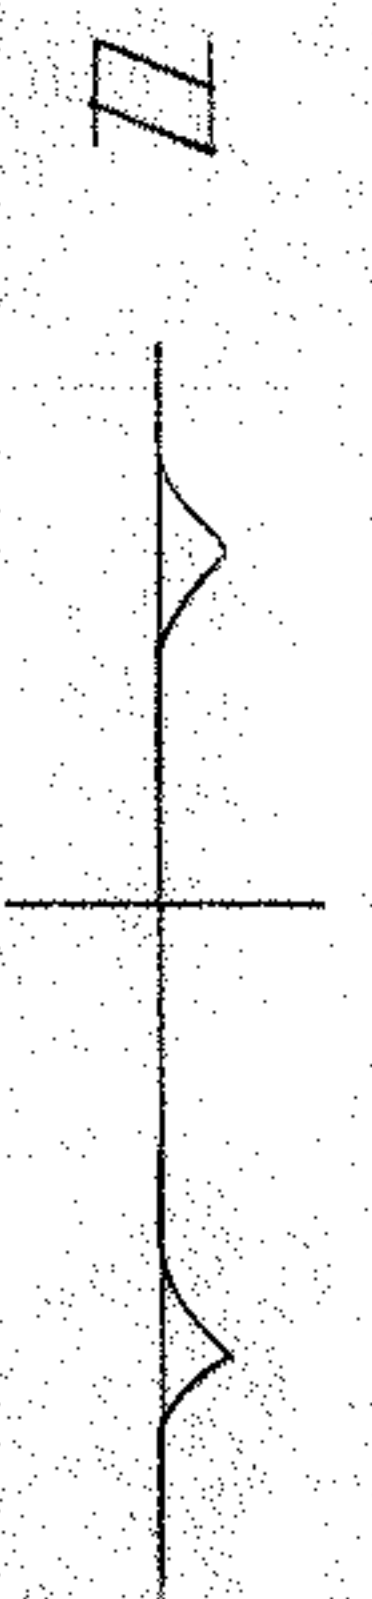

Survey for Vincent Bado
O. L. 39 Ridgeville Twp. - City of North Ridgeville
Lorain County Ohio
Scale 1" = 100' September, 1972
Laundon, Huffman & Simon Reg. Surveyors