


PPN 07-00-021-118-033

MAP P5 07-00-021-D  
44119

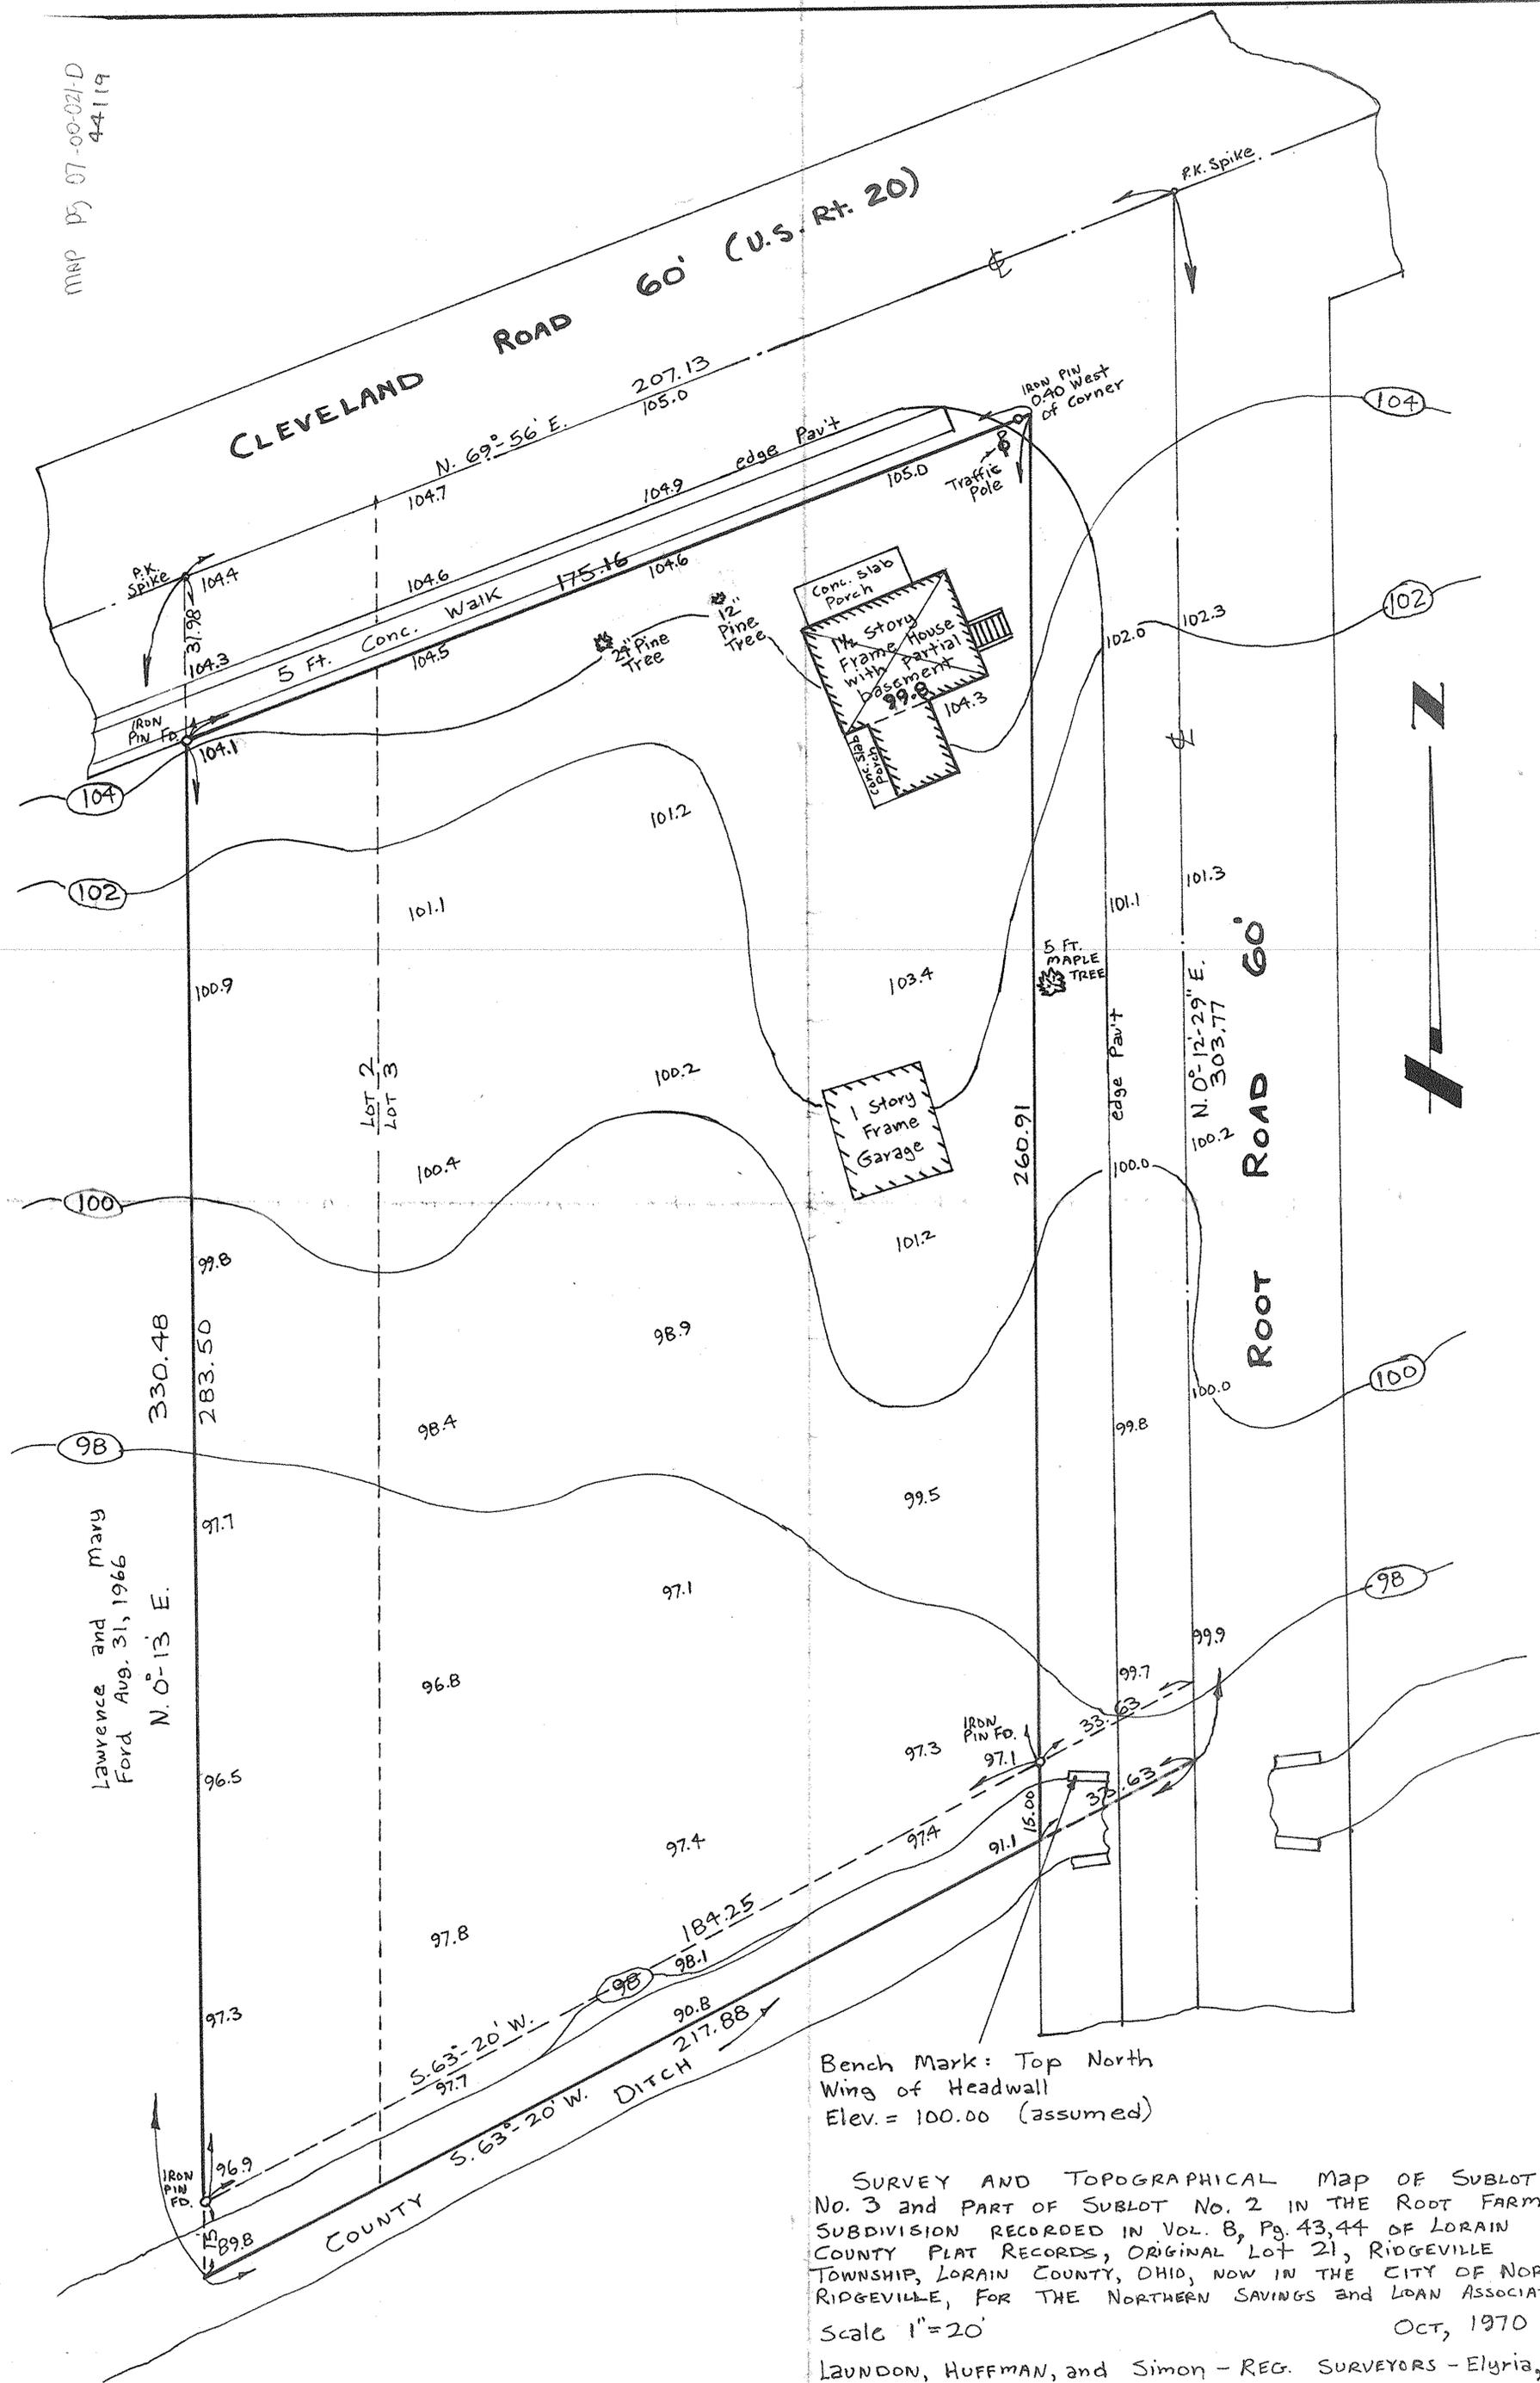

Lawrence and Mary  
Ford Aug. 31, 1966  
N. 0°-13' E.

Bench Mark: Top North  
Wing of Headwall  
Elev. = 100.00 (assumed)

SURVEY AND TOPOGRAPHICAL Map OF SUBLot  
No. 3 and PART OF SUBLot No. 2 IN THE ROOT FARMS  
SUBDIVISION RECORDED IN Vol. 8, Pg. 43,44 OF LORAIN  
COUNTY PLAT RECORDS, ORIGINAL Lot 21, RIDGEVILLE  
TOWNSHIP, LORAIN COUNTY, OHIO, NOW IN THE CITY OF NORTH  
RIDGEVILLE, FOR THE NORTHERN SAVINGS and LOAN ASSOCIATION.  
Scale 1"=20'  
OCT, 1970  
LAUNDON, HUFFMAN, and SIMON - REG. SURVEYORS - Elyria, Ohio