




EMPIRE SPRING CO.
 1/26/61 V. 789 P. 737

OLIVE ST. 60'

EDGEWOOD ST. 50'

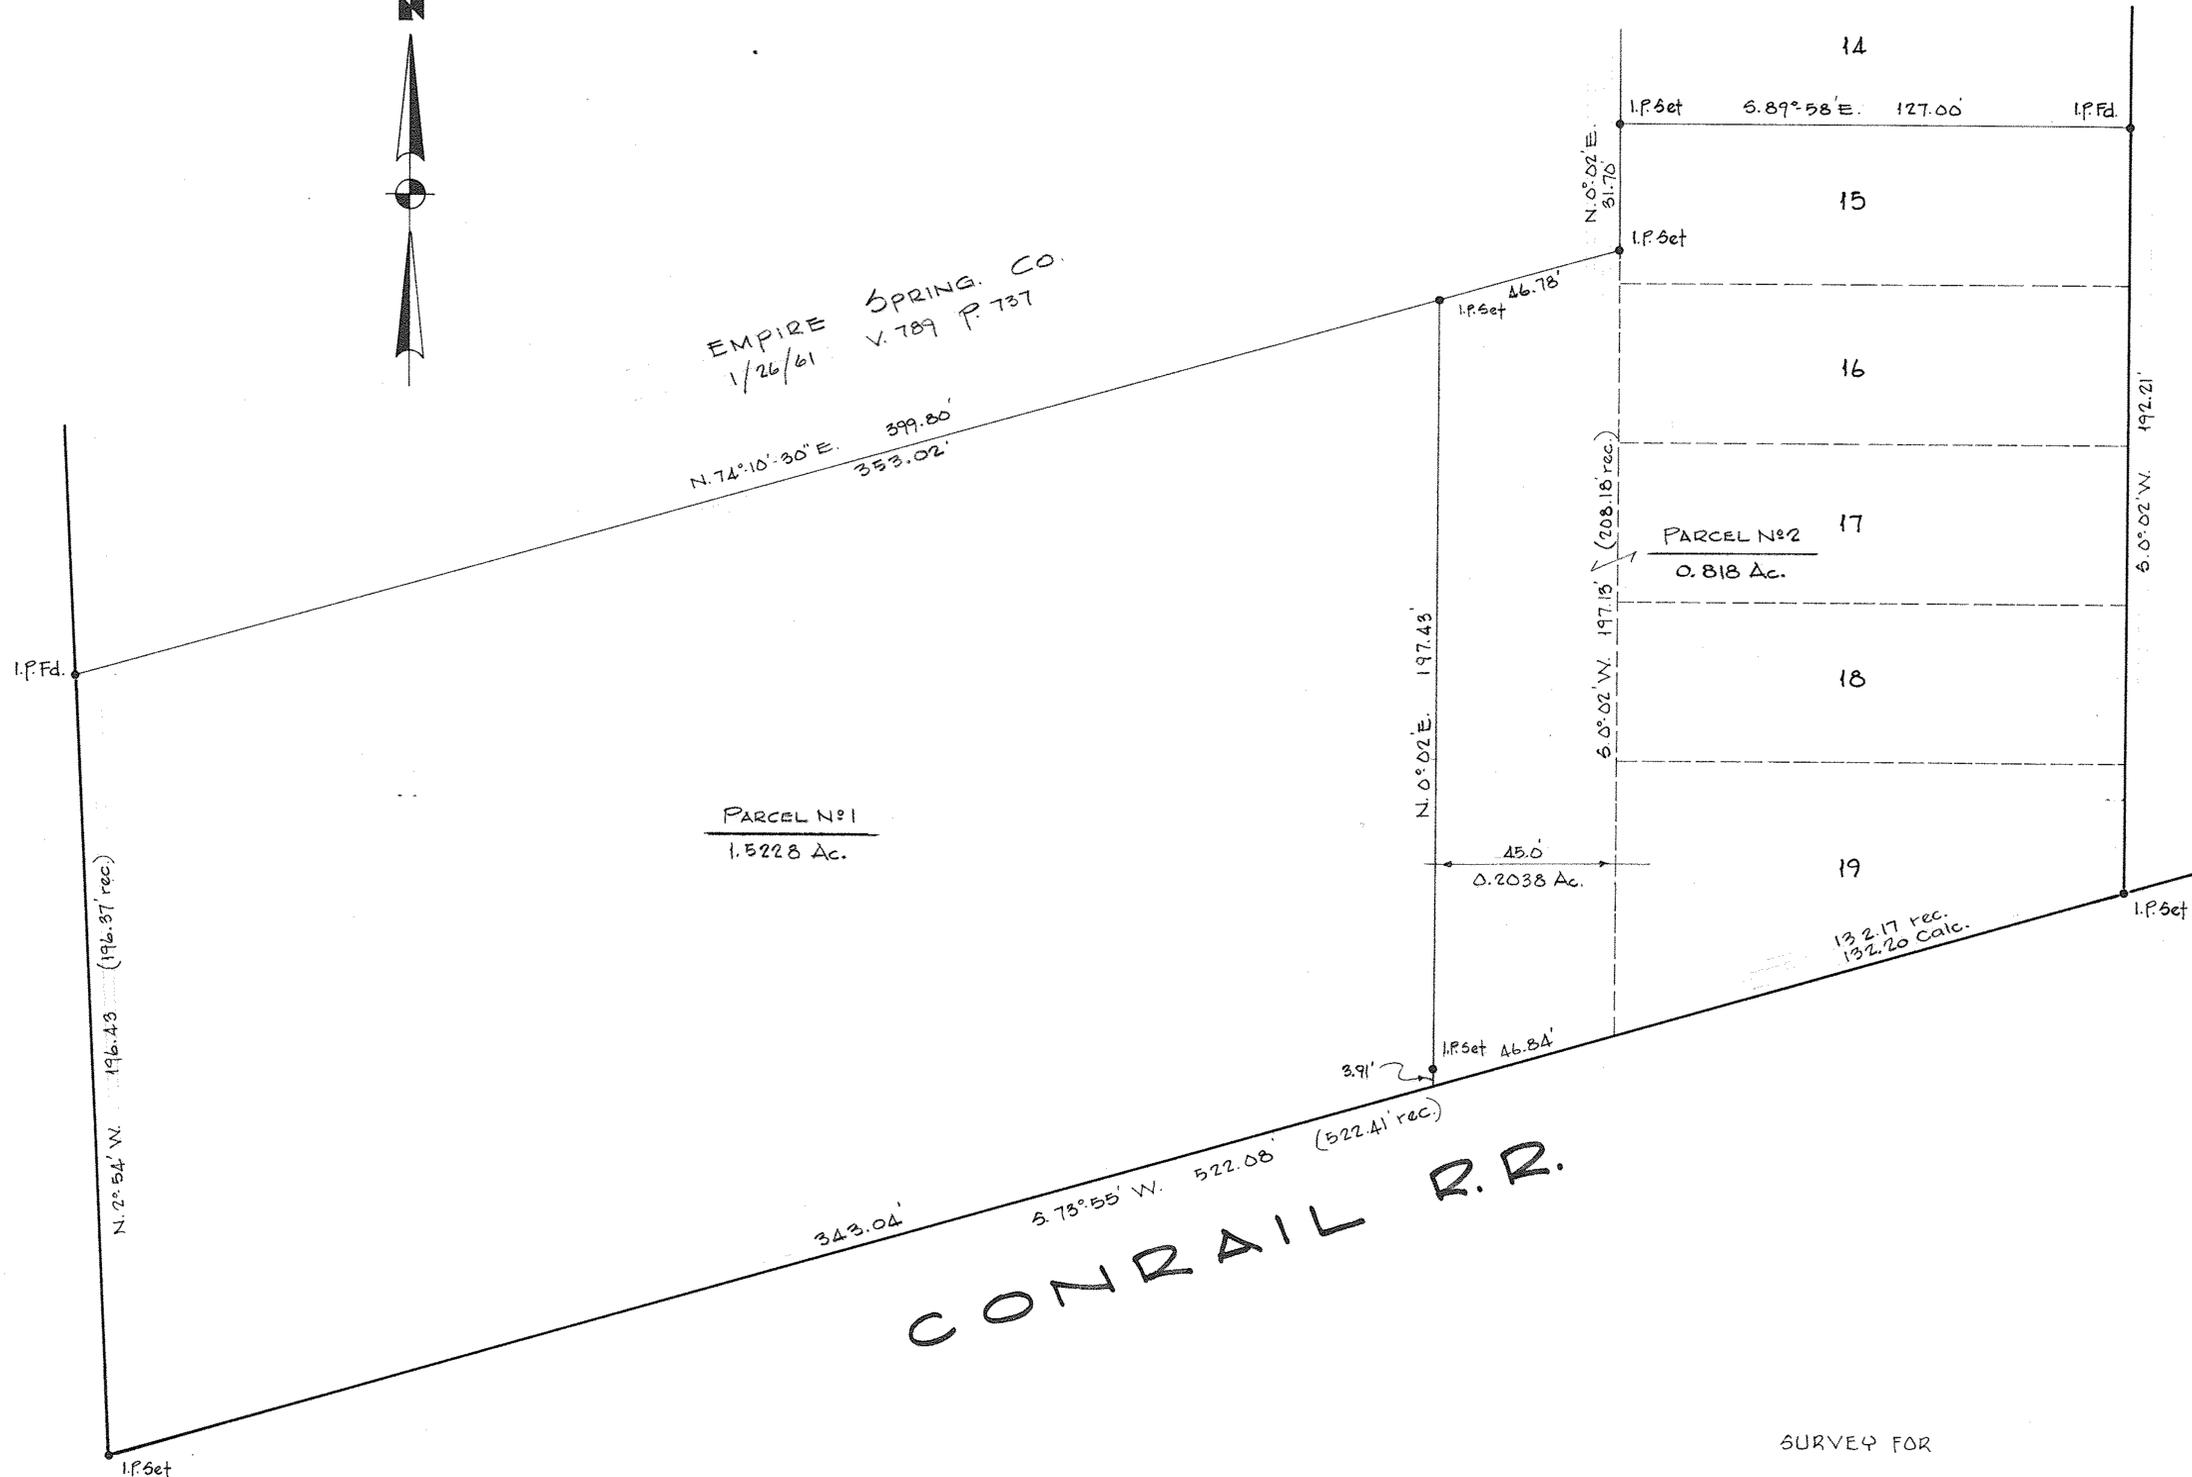

PARCEL No 1
 1.5228 Ac.

PARCEL No 2
 0.818 Ac.

CONRAIL R.R.

SURVEY FOR
TED HAURY

PART OF O.L.'s 14 & 15 ELYRIA TOWNSHIP - 5/L's 15, 16, 17, 18 & 19 OF BEEBE'S SUBD. No 3 RV. 9 PG. 32
 CITY OF ELYRIA COUNTY OF LORAIN STATE OF OHIO

SCALE 1" = 30' APRIL, 1980
 LAUNDON • SIMON • CAHL & ASSOCIATES
 ENGINEERS SURVEYORS
 JOB No 80-960 F.B. 162/13