

WM. A. & EDITH L. FLURY
3-31-71 DV.1021 P.228

I.P. Set

N. 89° 42' 40" E. 510.03'

I.P. Pd.

MARLENE R. KELLER
7-20-71 DV. 1028 P.423

N. 32° 13' 42" W.
509.79'

4.0207 Ac.


GEORGE & MARION JURCO
V. 1130 P. 304

S. 0° 40' 40" W. 449.63'

LANCELOT L. HOLLIDAY
1-19-79 DV. 1226 P. 167

MITCHELL ROAD

O.L. 82 3.70 Ac.
O.L. 83 0.32 Ac.
TOTAL 4.0207 Ac.

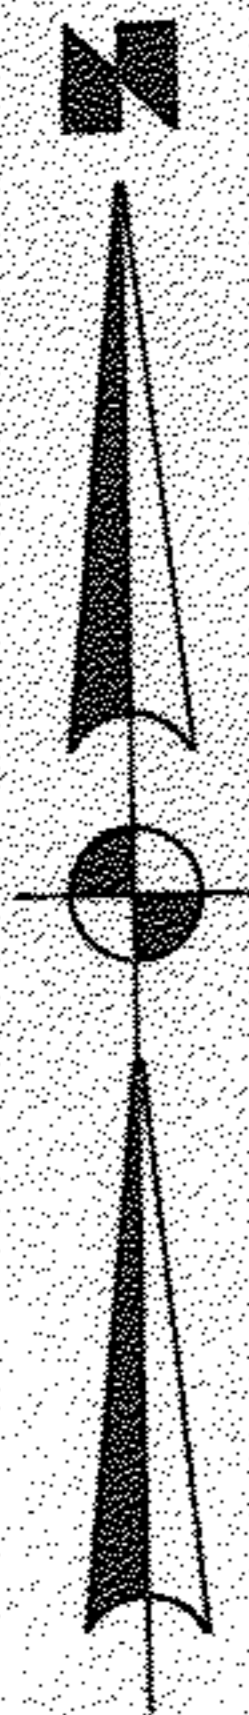

O.L. 82

O.L. 83

I.P. Set

DUE WEST

232.99'

DUE NORTH
106.82'

-040

250.00'
S. 68° 38' 40" W.

I.P. Pd.
0.685

15.10'

40.70'

I.P. Pd.

284.60'
DUE WEST

M.B.

OSBORNE ROAD

60'
SURVEY FOR
JOHN W. KELLY

PART OF O.L.s 82 & 83 COLUMBIA TWP.
LORAIN COUNTY OHIO
SCALE 1"=60' AUG. 15, 1980
LAUNDON · SIMON · CAHL & ASSOC.
ENGINEERS 80-996 SURVEYORS

COX