


MAP P9 12-00-076-B
44219

PPN 12-00-076-103-177

12-00-076-103
12-00-076-B

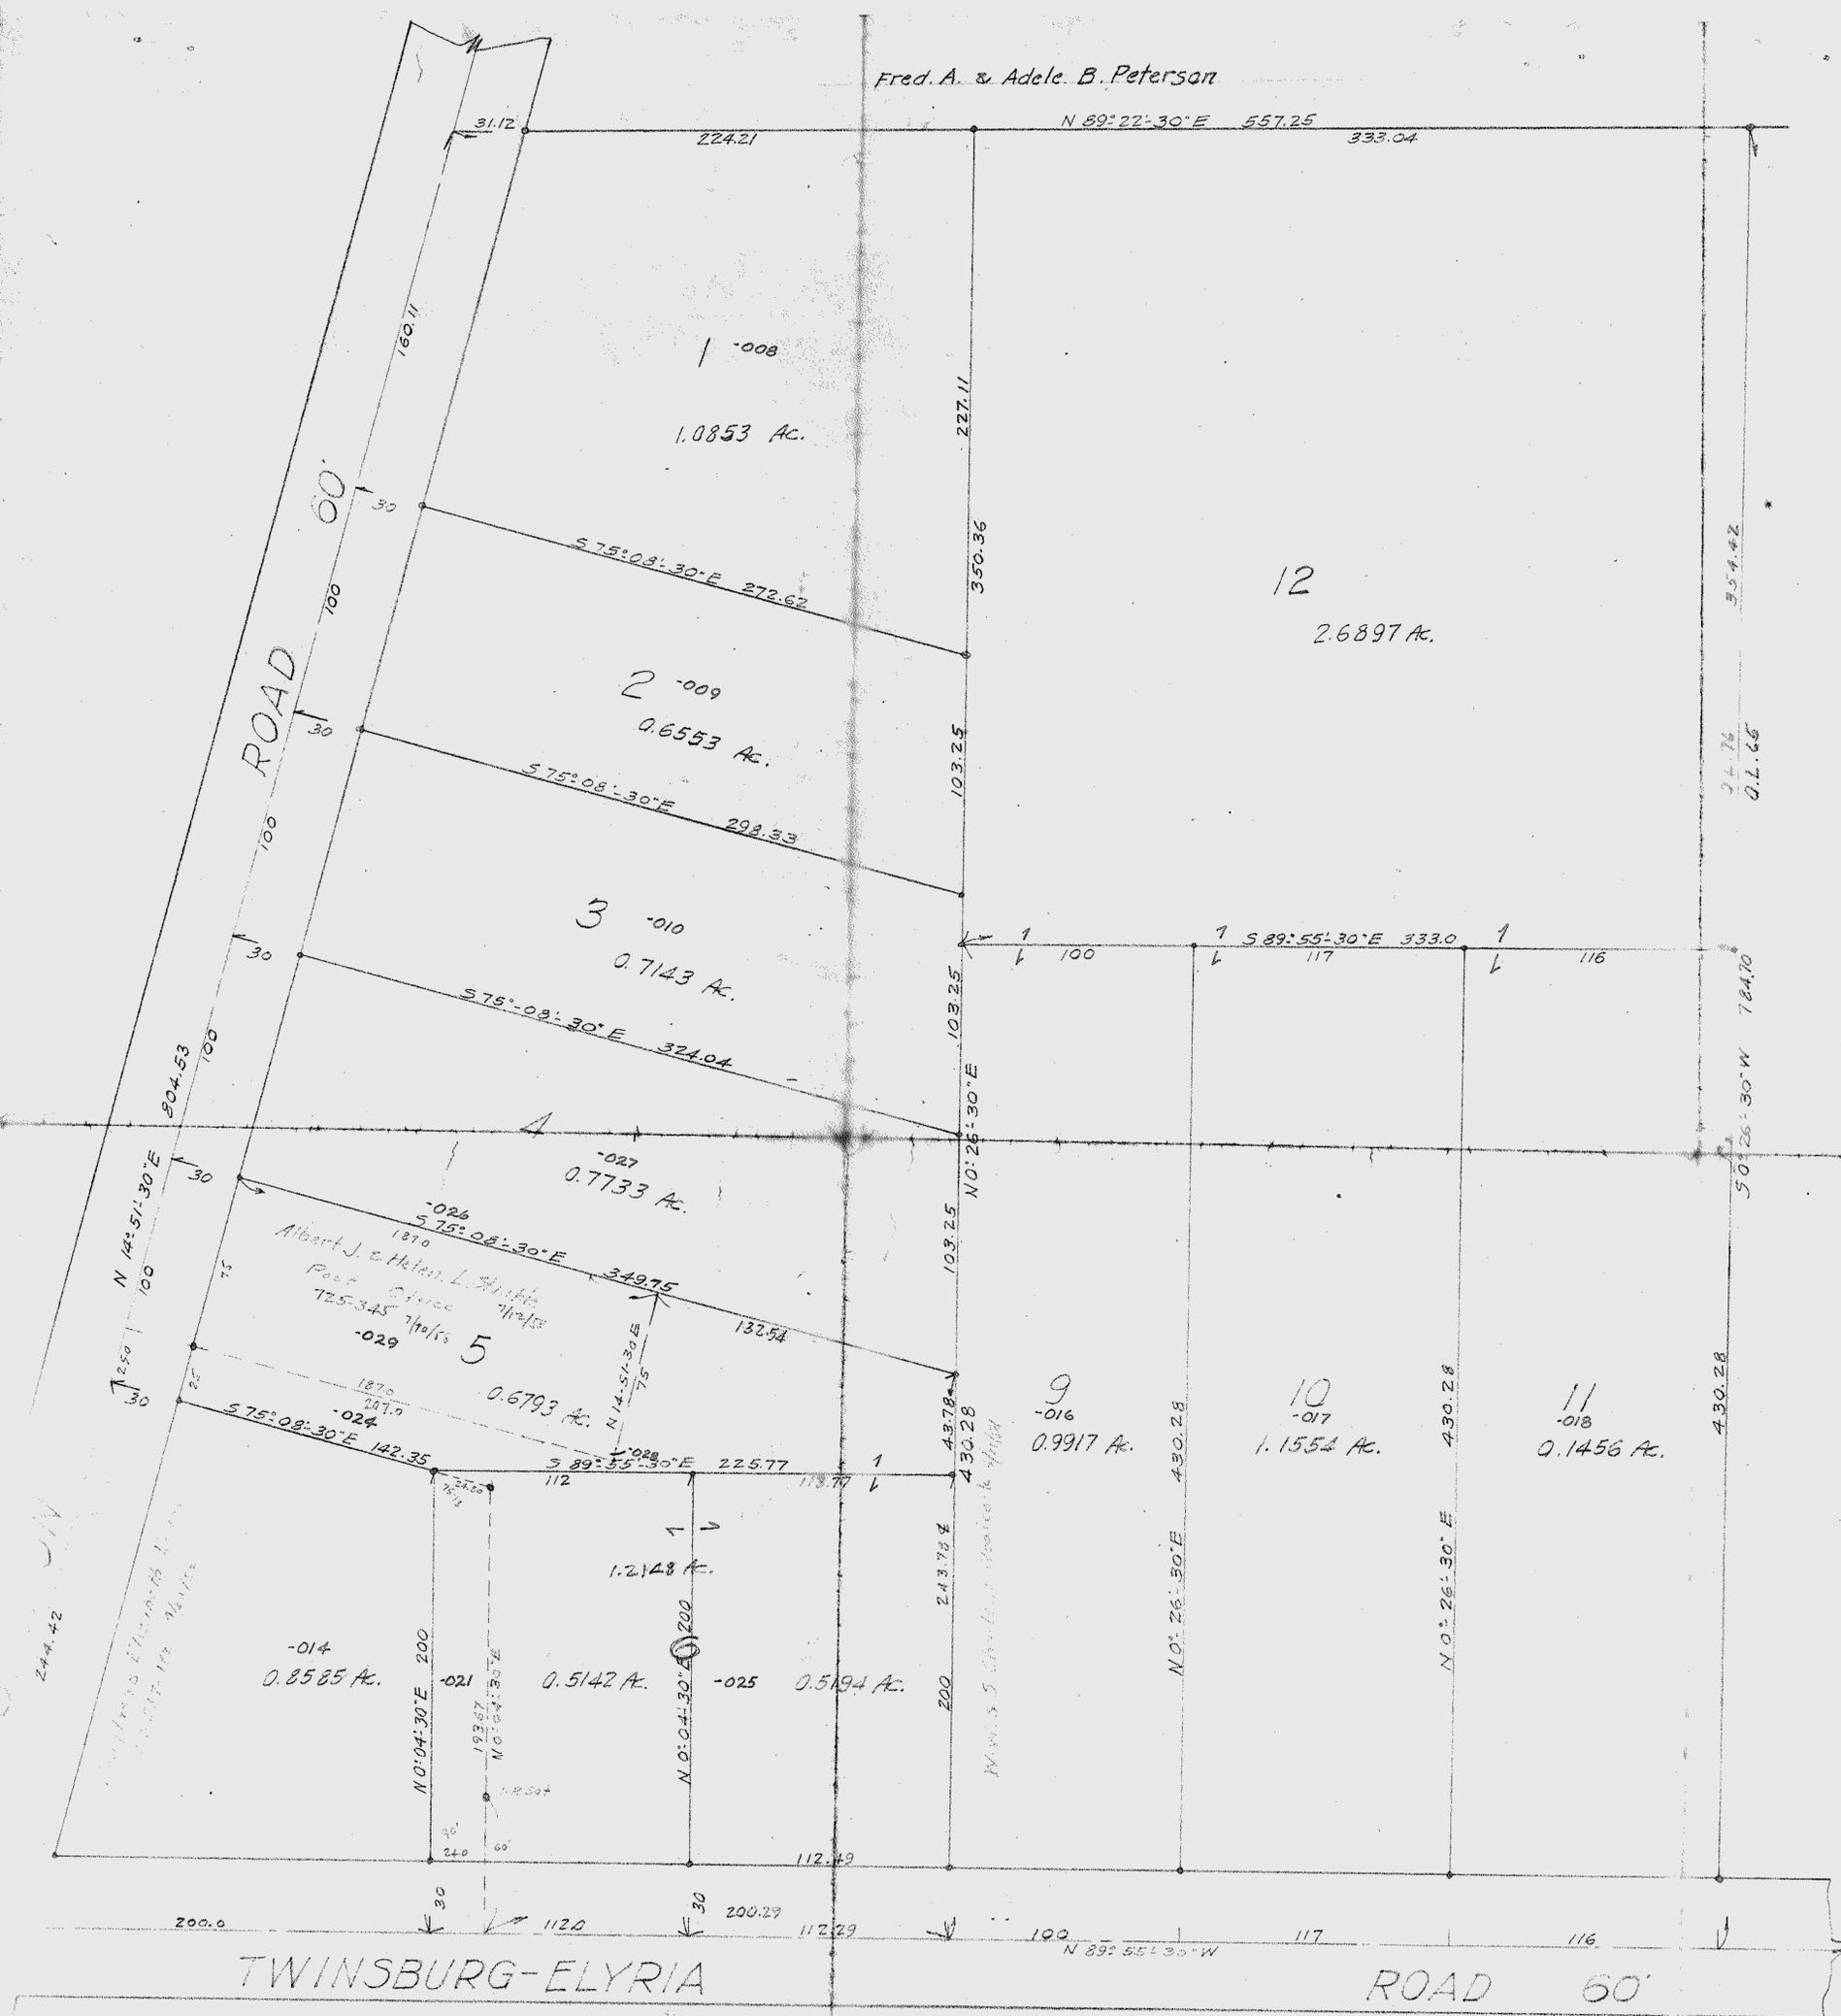

Fred. A. & Adele B. Peterson

12
2.6897 Ac.

2-009
0.6553 Ac.

3-010
0.7143 Ac.

4-027
0.7733 Ac.

5-024
0.6793 Ac.

9-016
0.9917 Ac.

10-017
1.1554 Ac.

11-018
0.1456 Ac.


-014
0.8585 Ac.

-021
0.5142 Ac.

-025
0.5194 Ac.

TWINSBURG-ELYRIA

ROAD 60'

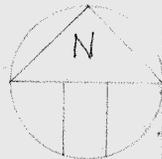

SURVEY FOR DALE HUMMON
 PART OF ORIG. LOT 76, COLUMBIA TWP.
 LORAIN CO., OHIO. SCALE 1"=50'
 SEPT. 30, 1952. T.W. LAUNDON, REG. SURVEYOR 689