

AGNES E. CHRISTENSON  
7-8-54 D.V. 603-251

10-00-015-114  
10-00-015-F

I.P. Set  
22.82



292.43  
I.P. Set  
N. 86° 43' E. 965.09

510.0

PPN 10-00-015-114-???

MAP P<sub>3</sub> 10-00-015-F 44245

SURVEY FOR ROBSON  
PT. OF SEC. 15 CARLISLE TWP.  
LORAIN CO. OHIO  
SCALE 1"=50' NOV. 1960  
LAUNDON & HUFFMAN  
REG. SURVEYORS

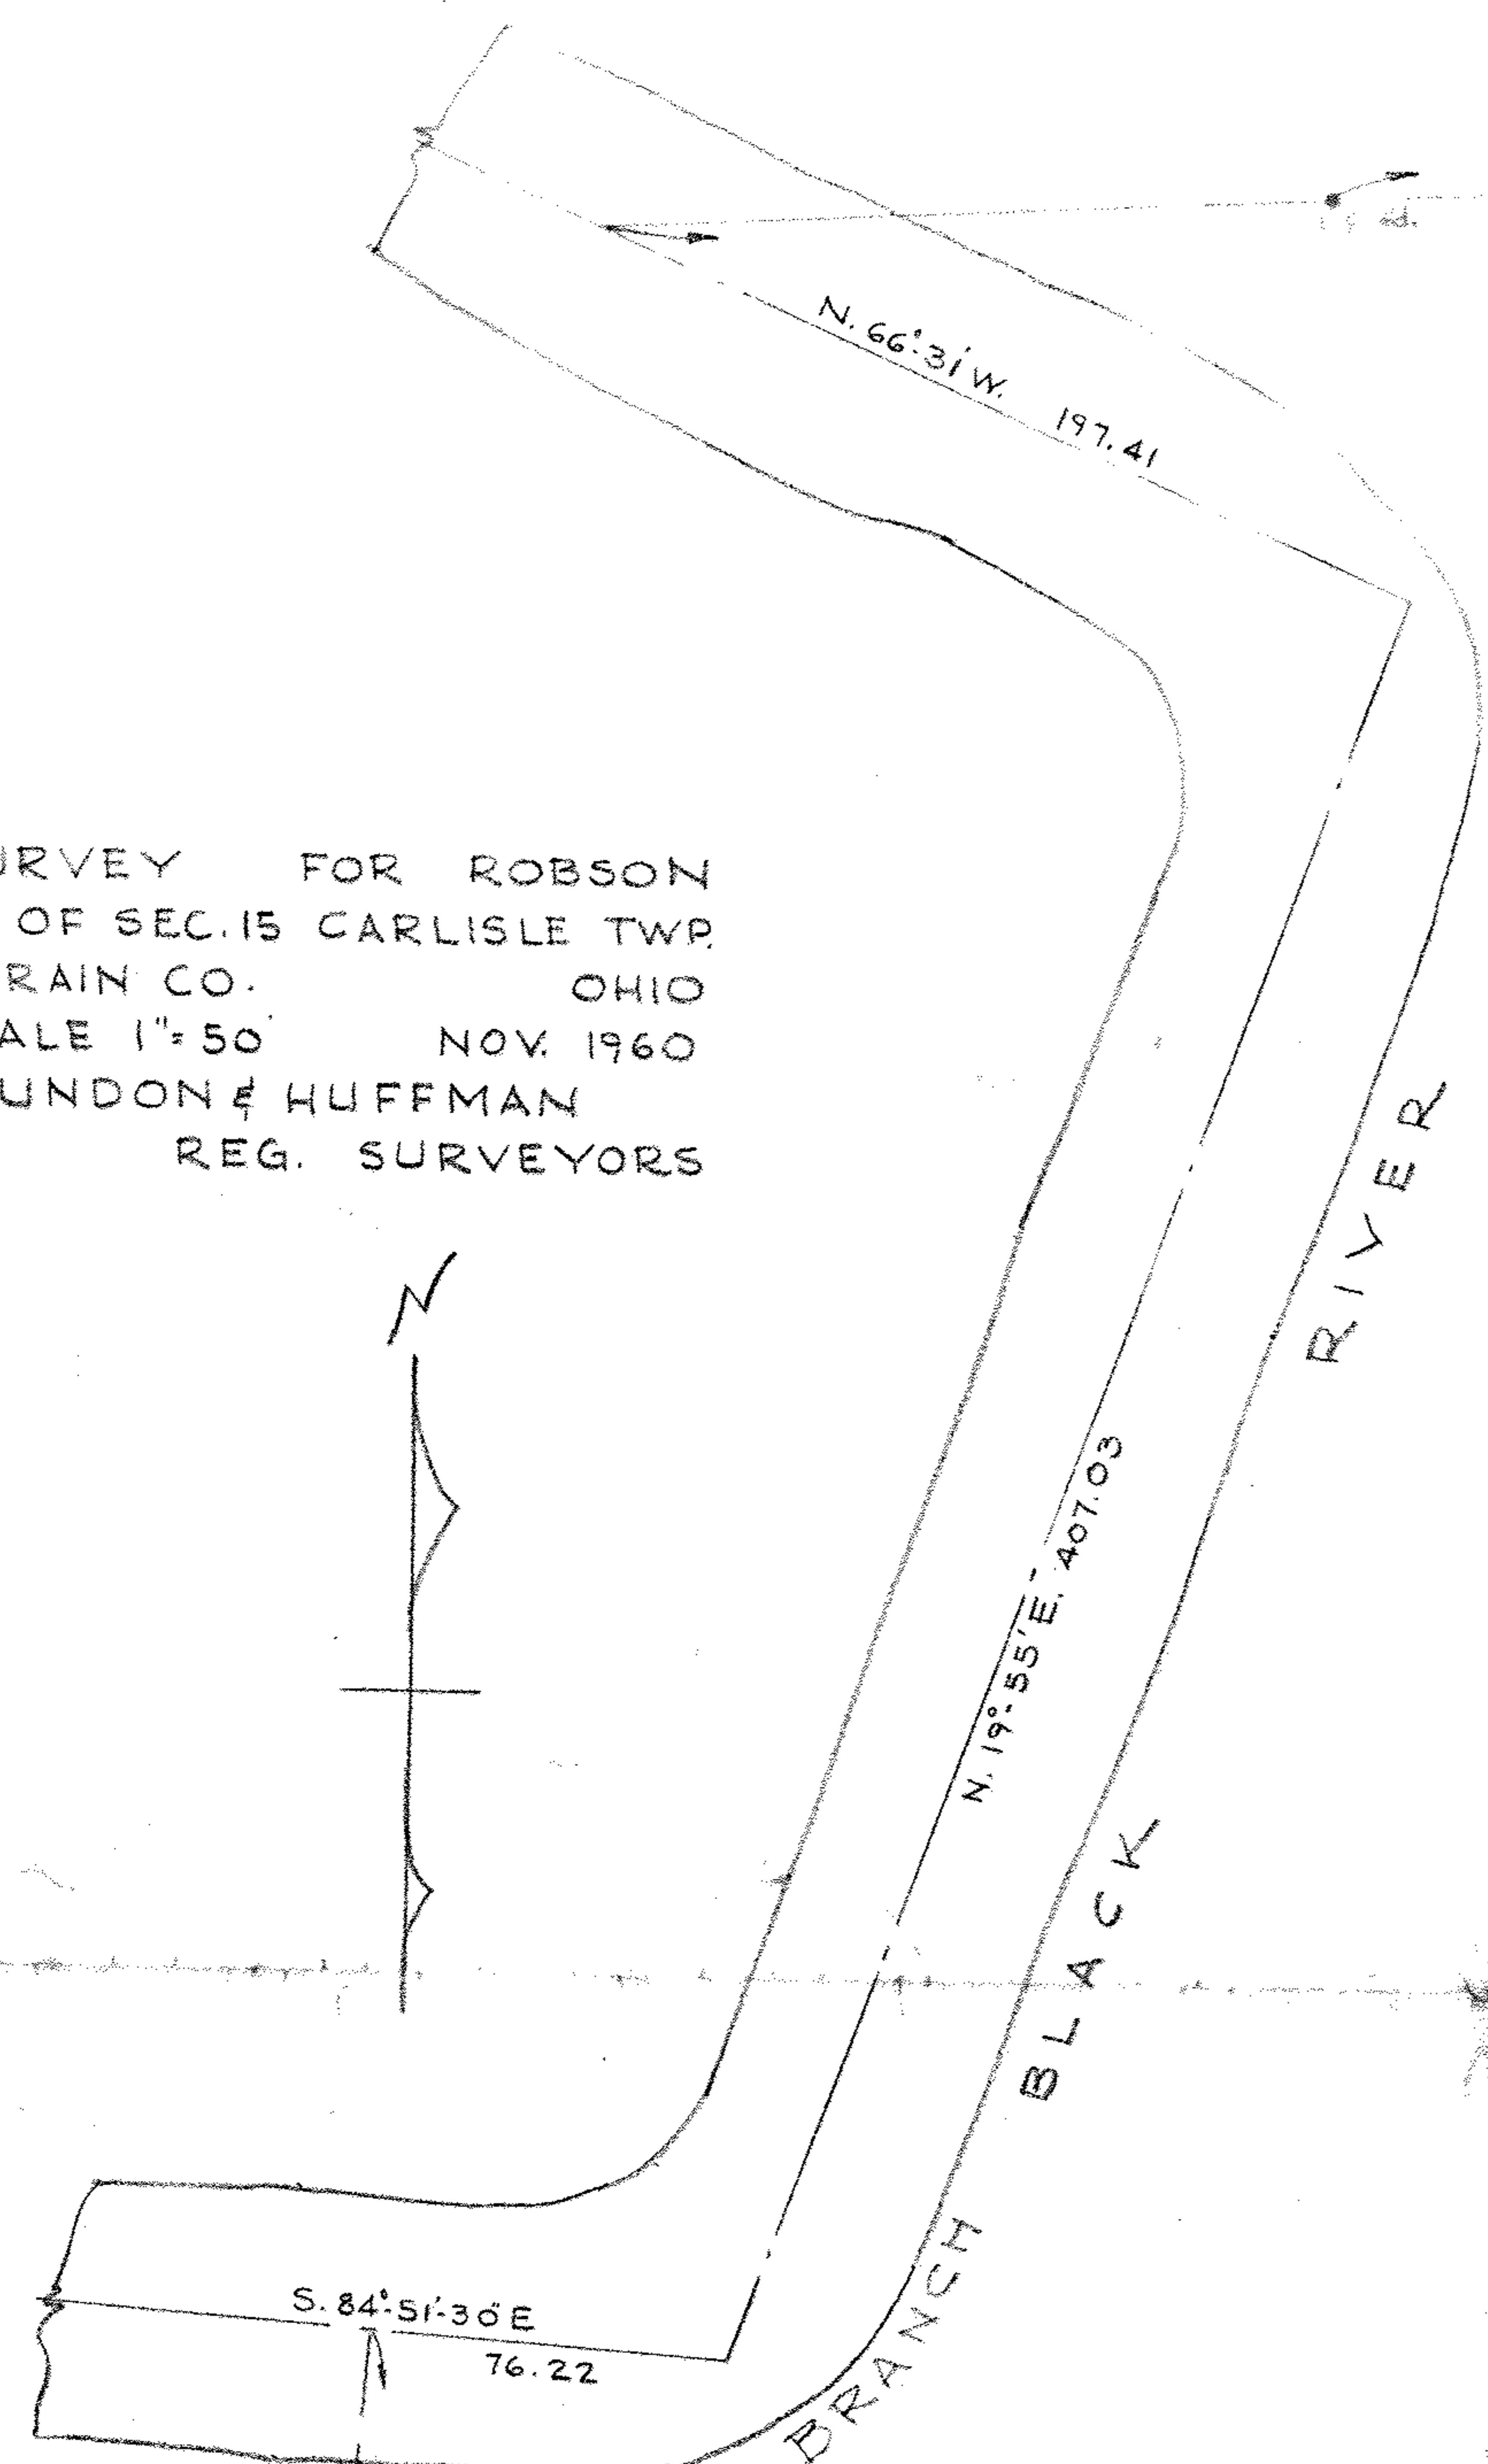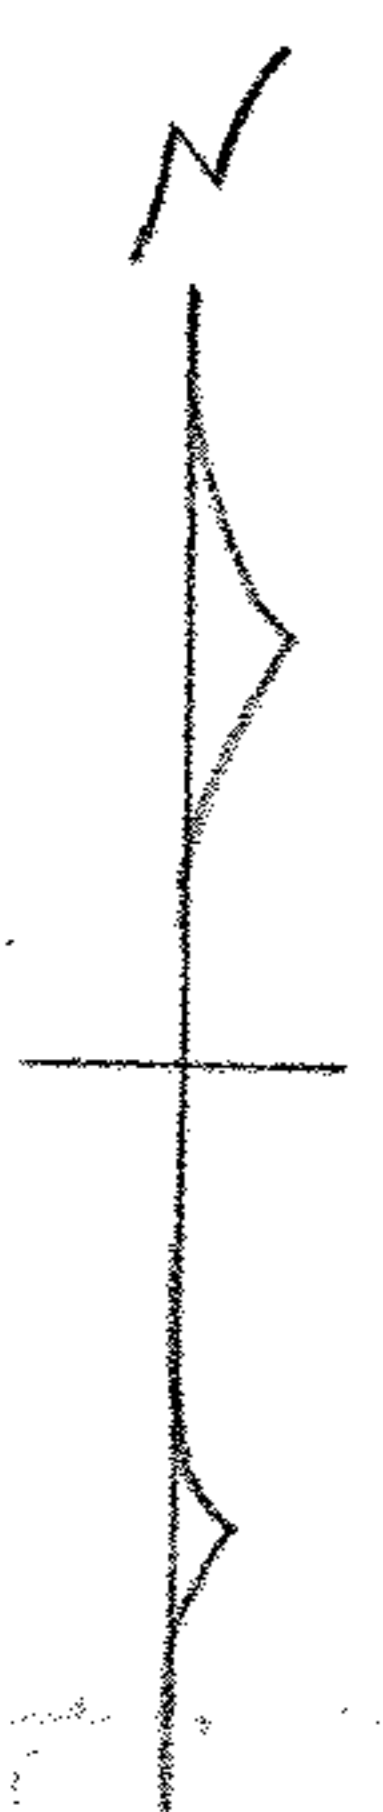

14.9117 Acres  $\phi$  River -  $\phi$  Road

N. 81° 09' 18" W. 878.86

