


PPN 10-00-003-102-040

10-00-003-102-040
ELYRIA-HIGH-SCHOOL
RUNNING TRACK

MAP P3 10-00-003-D
44285

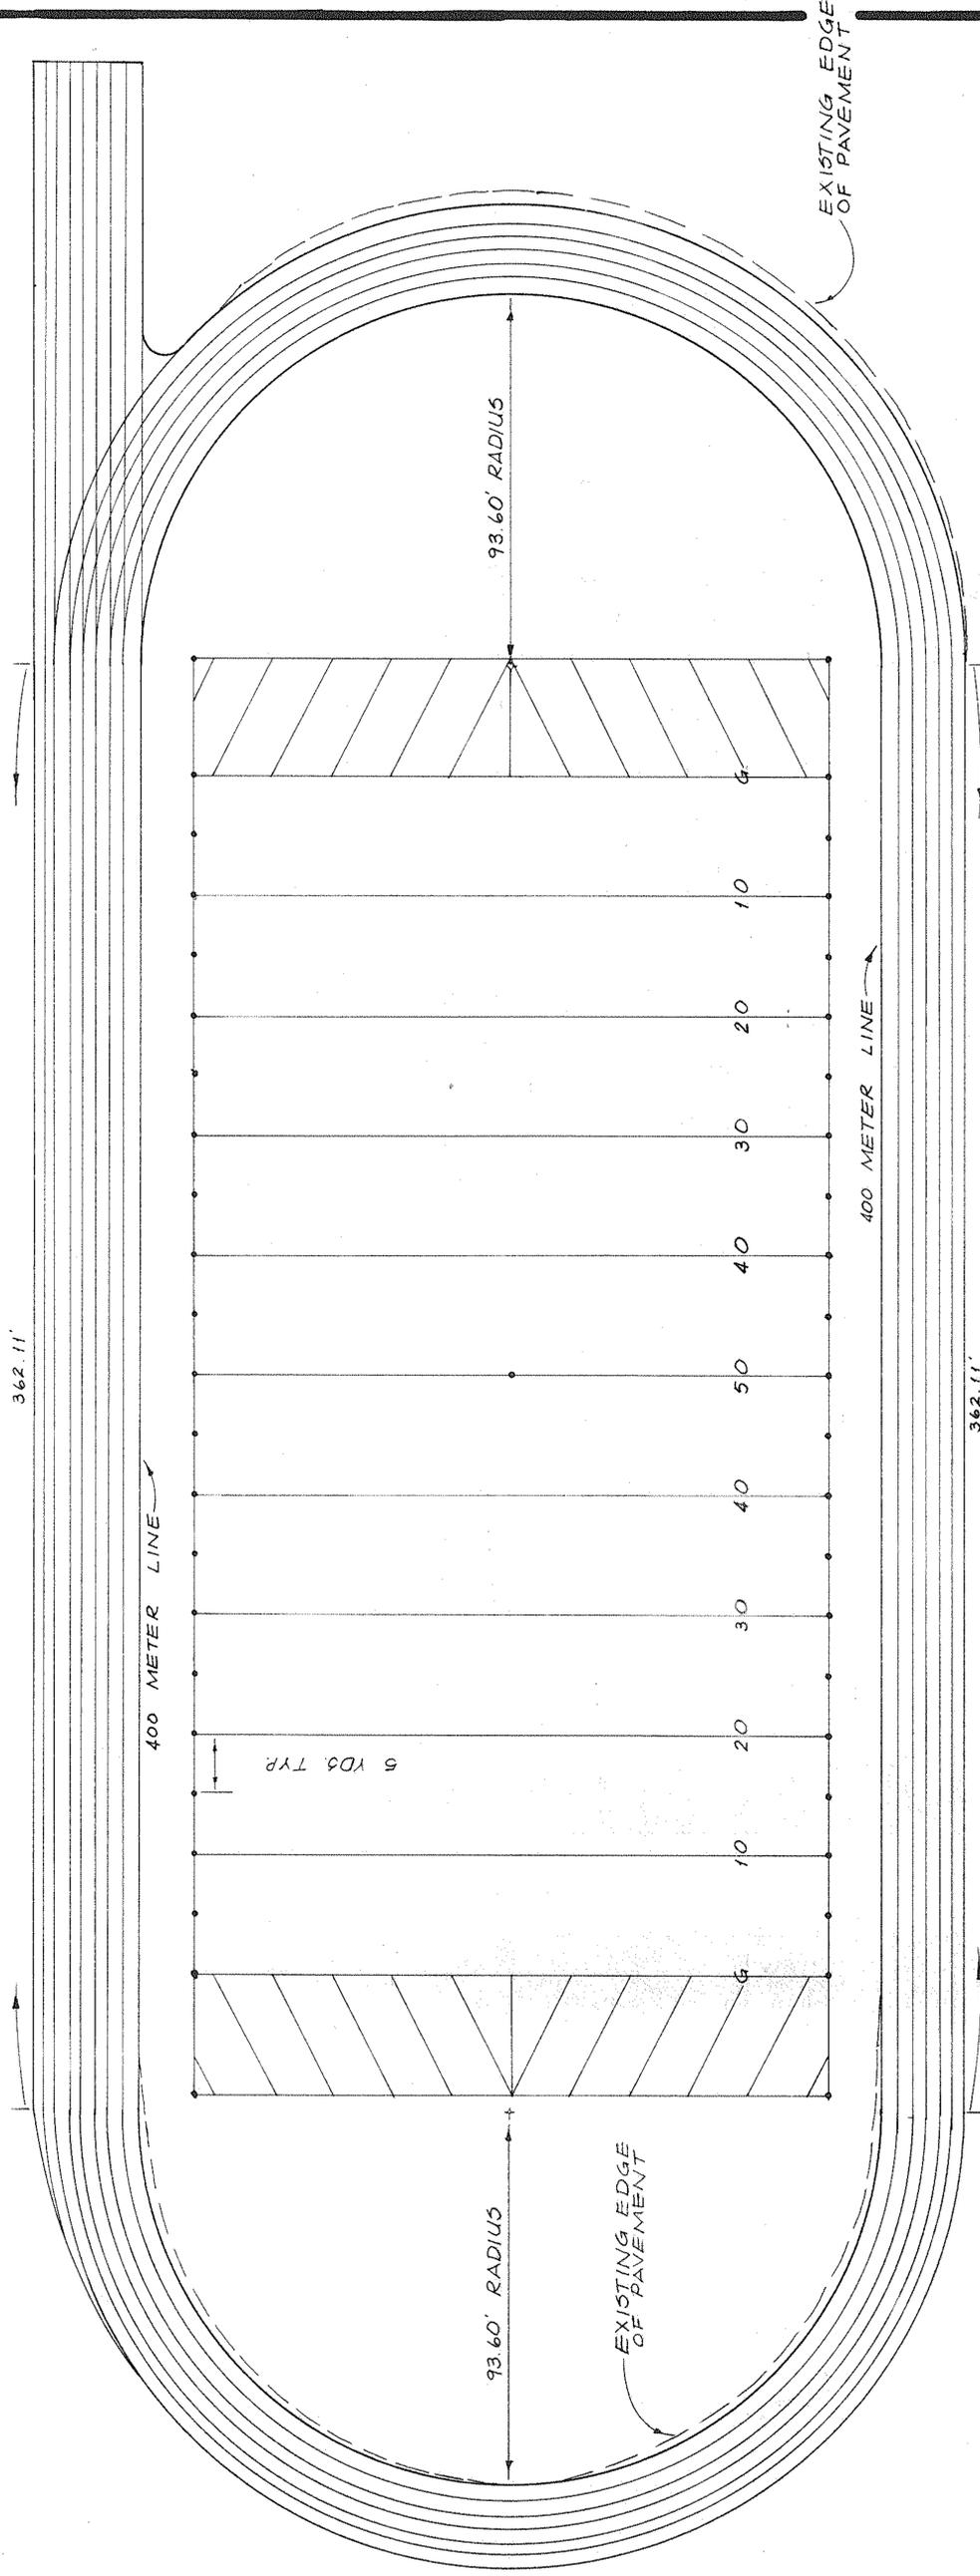

• DENOTES IRON PIN SET

AS-BUILT DRAWING
FOR
ELYRIA HIGH SCHOOL RUNNING TRACK
CONVERSION TO METERS
JULY, 1980
1" = 30'
LAUNDON·SIMON·CAHL & ASSOC. INC.
504 MIDDLE AVE. ELYRIA, OHIO

JOB NO. 80-988