
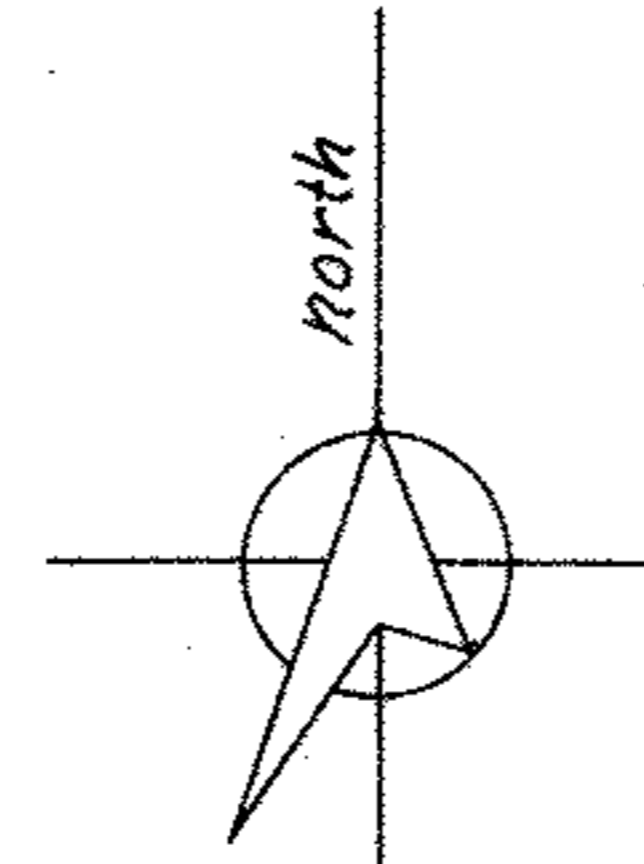


9-00-097-000-016
 9-00-097-000-052
 9-00-097-000-053
 9-00-097-A

PPN 09-00-097-000-016
 052
 053

MAP PG 9-00-097A 44290

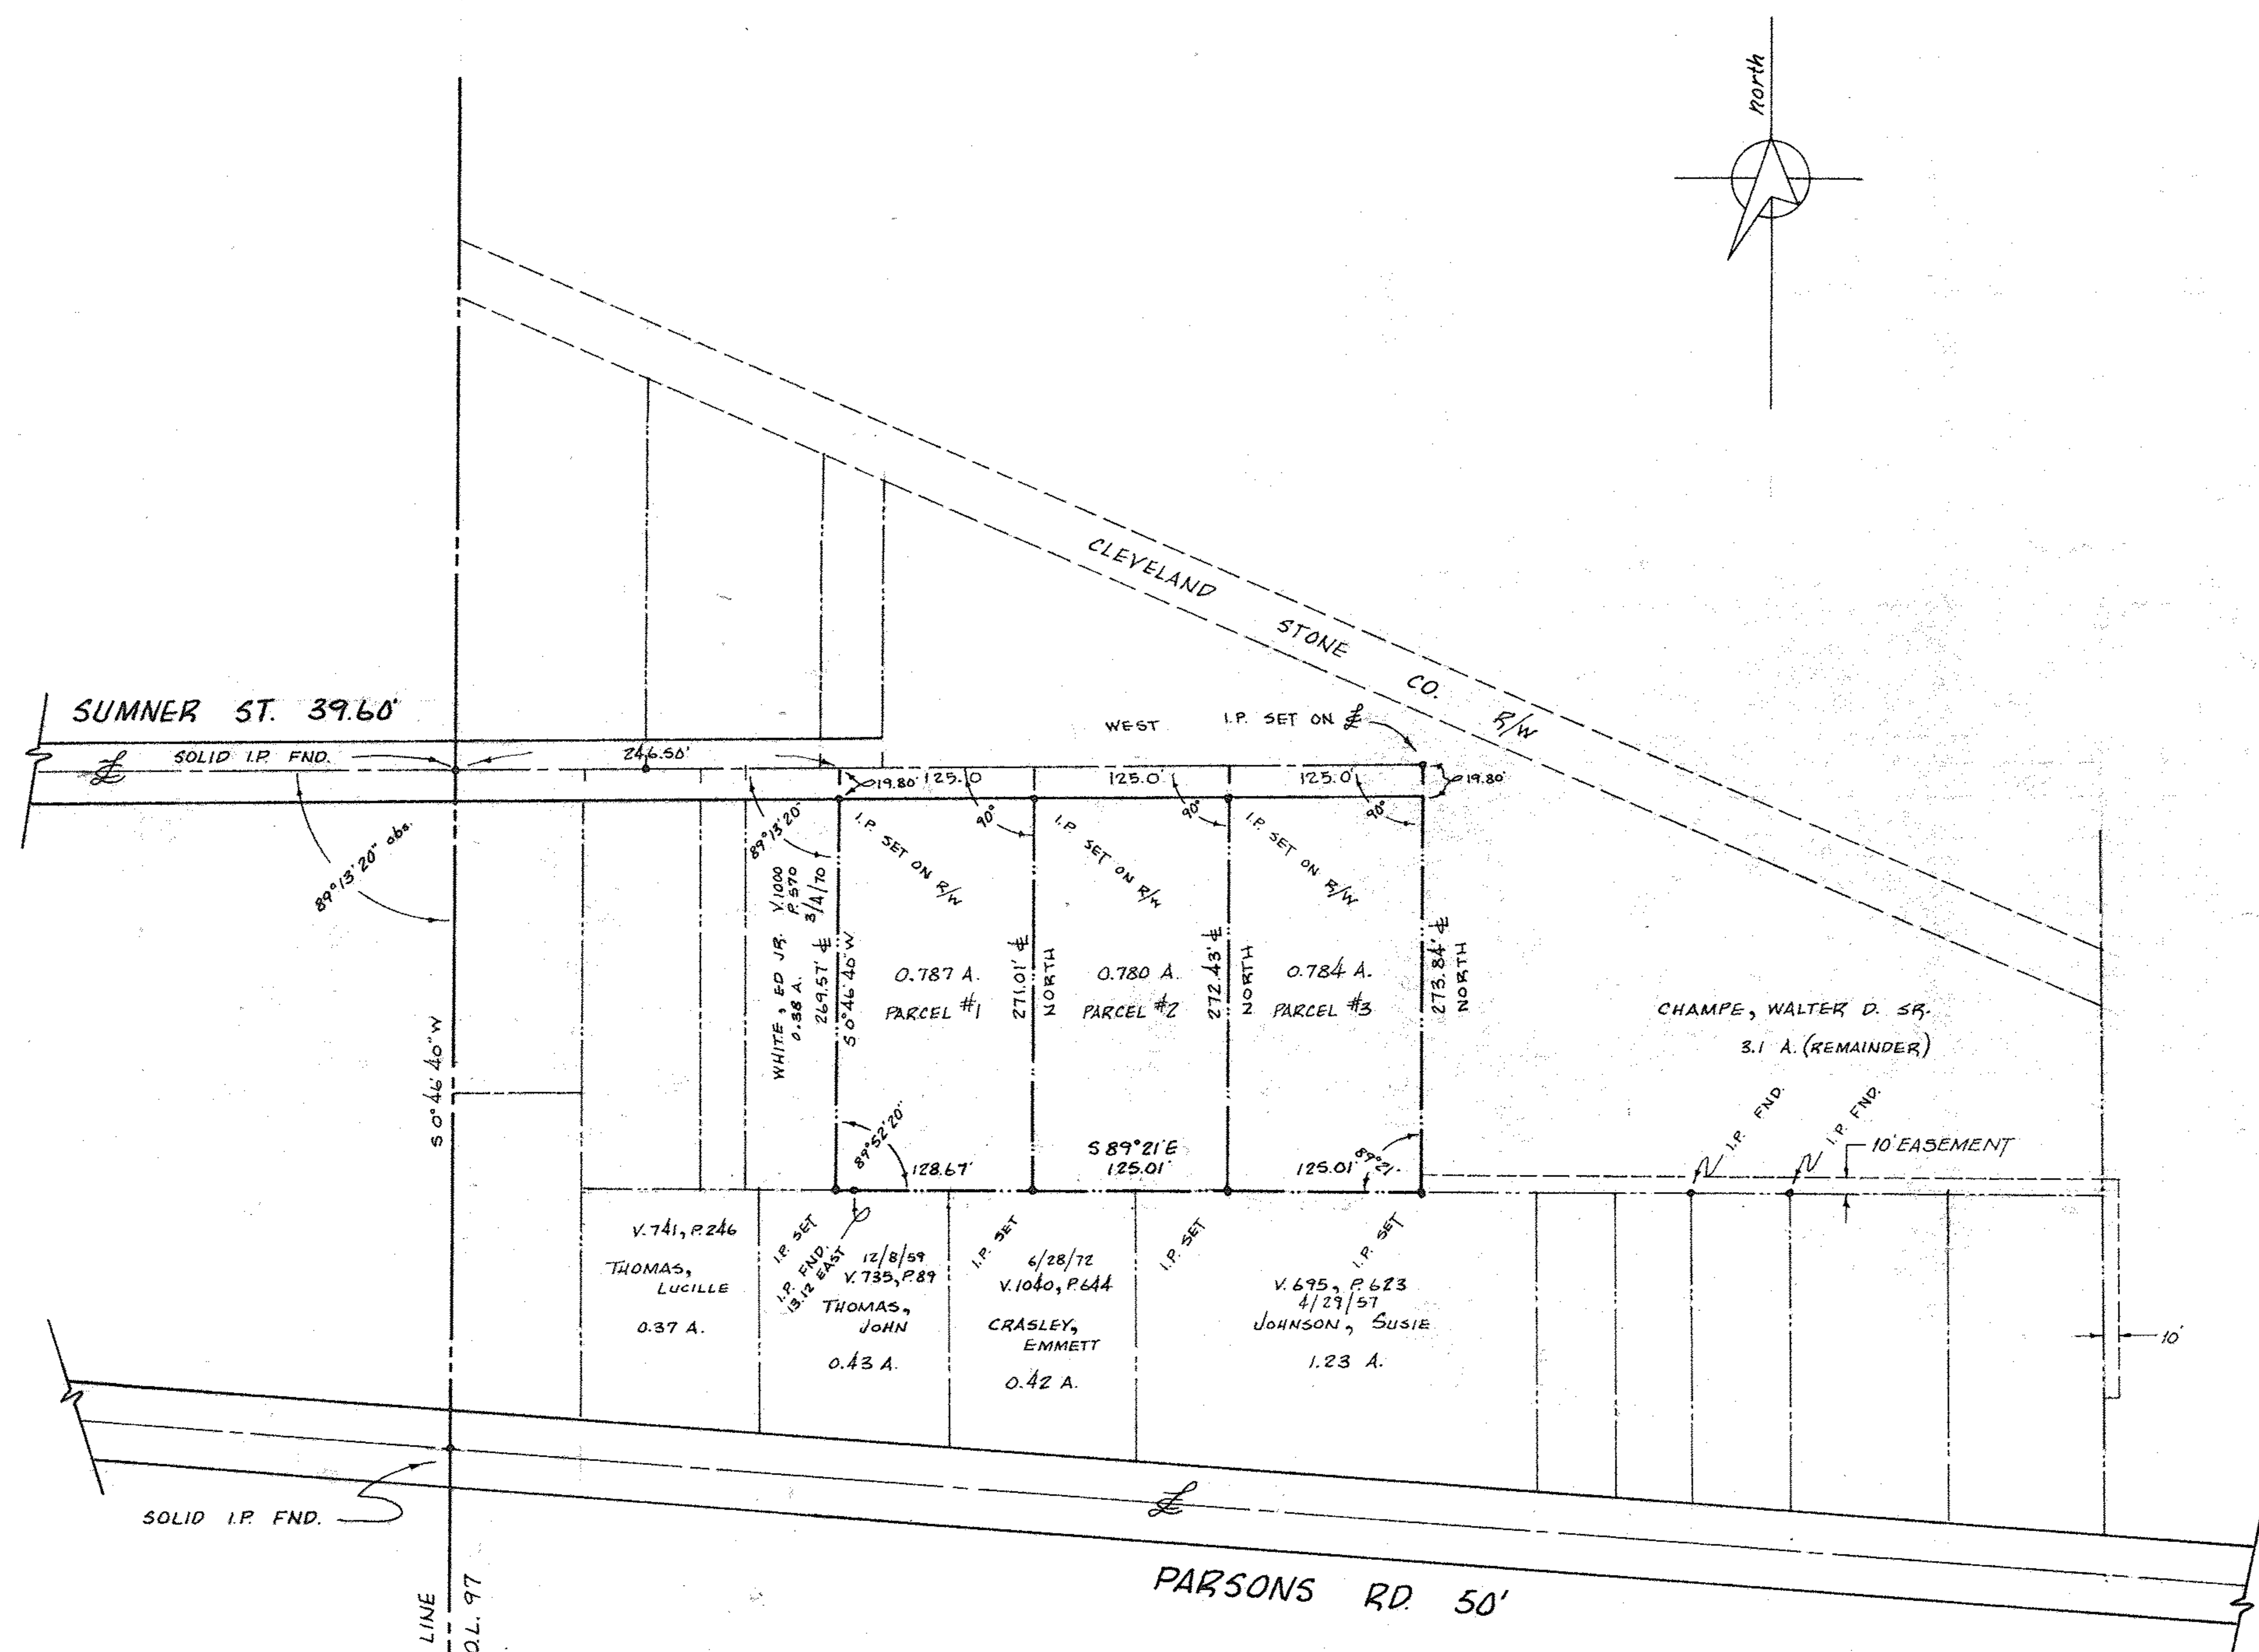

SURVEY FOR JAMES JOHNSON
 PART OF ORIGINAL LOT 97, RUSSIA TWP.
 LORAIN COUNTY, OHIO
 SCALE: 1" = 100' APRIL 1975
 LAUNDON · SIMON · CAHL & ASSOCIATES
 ENGINEERS & SURVEYORS ELYRIA, OHIO