


SOUTH MAIN ST.

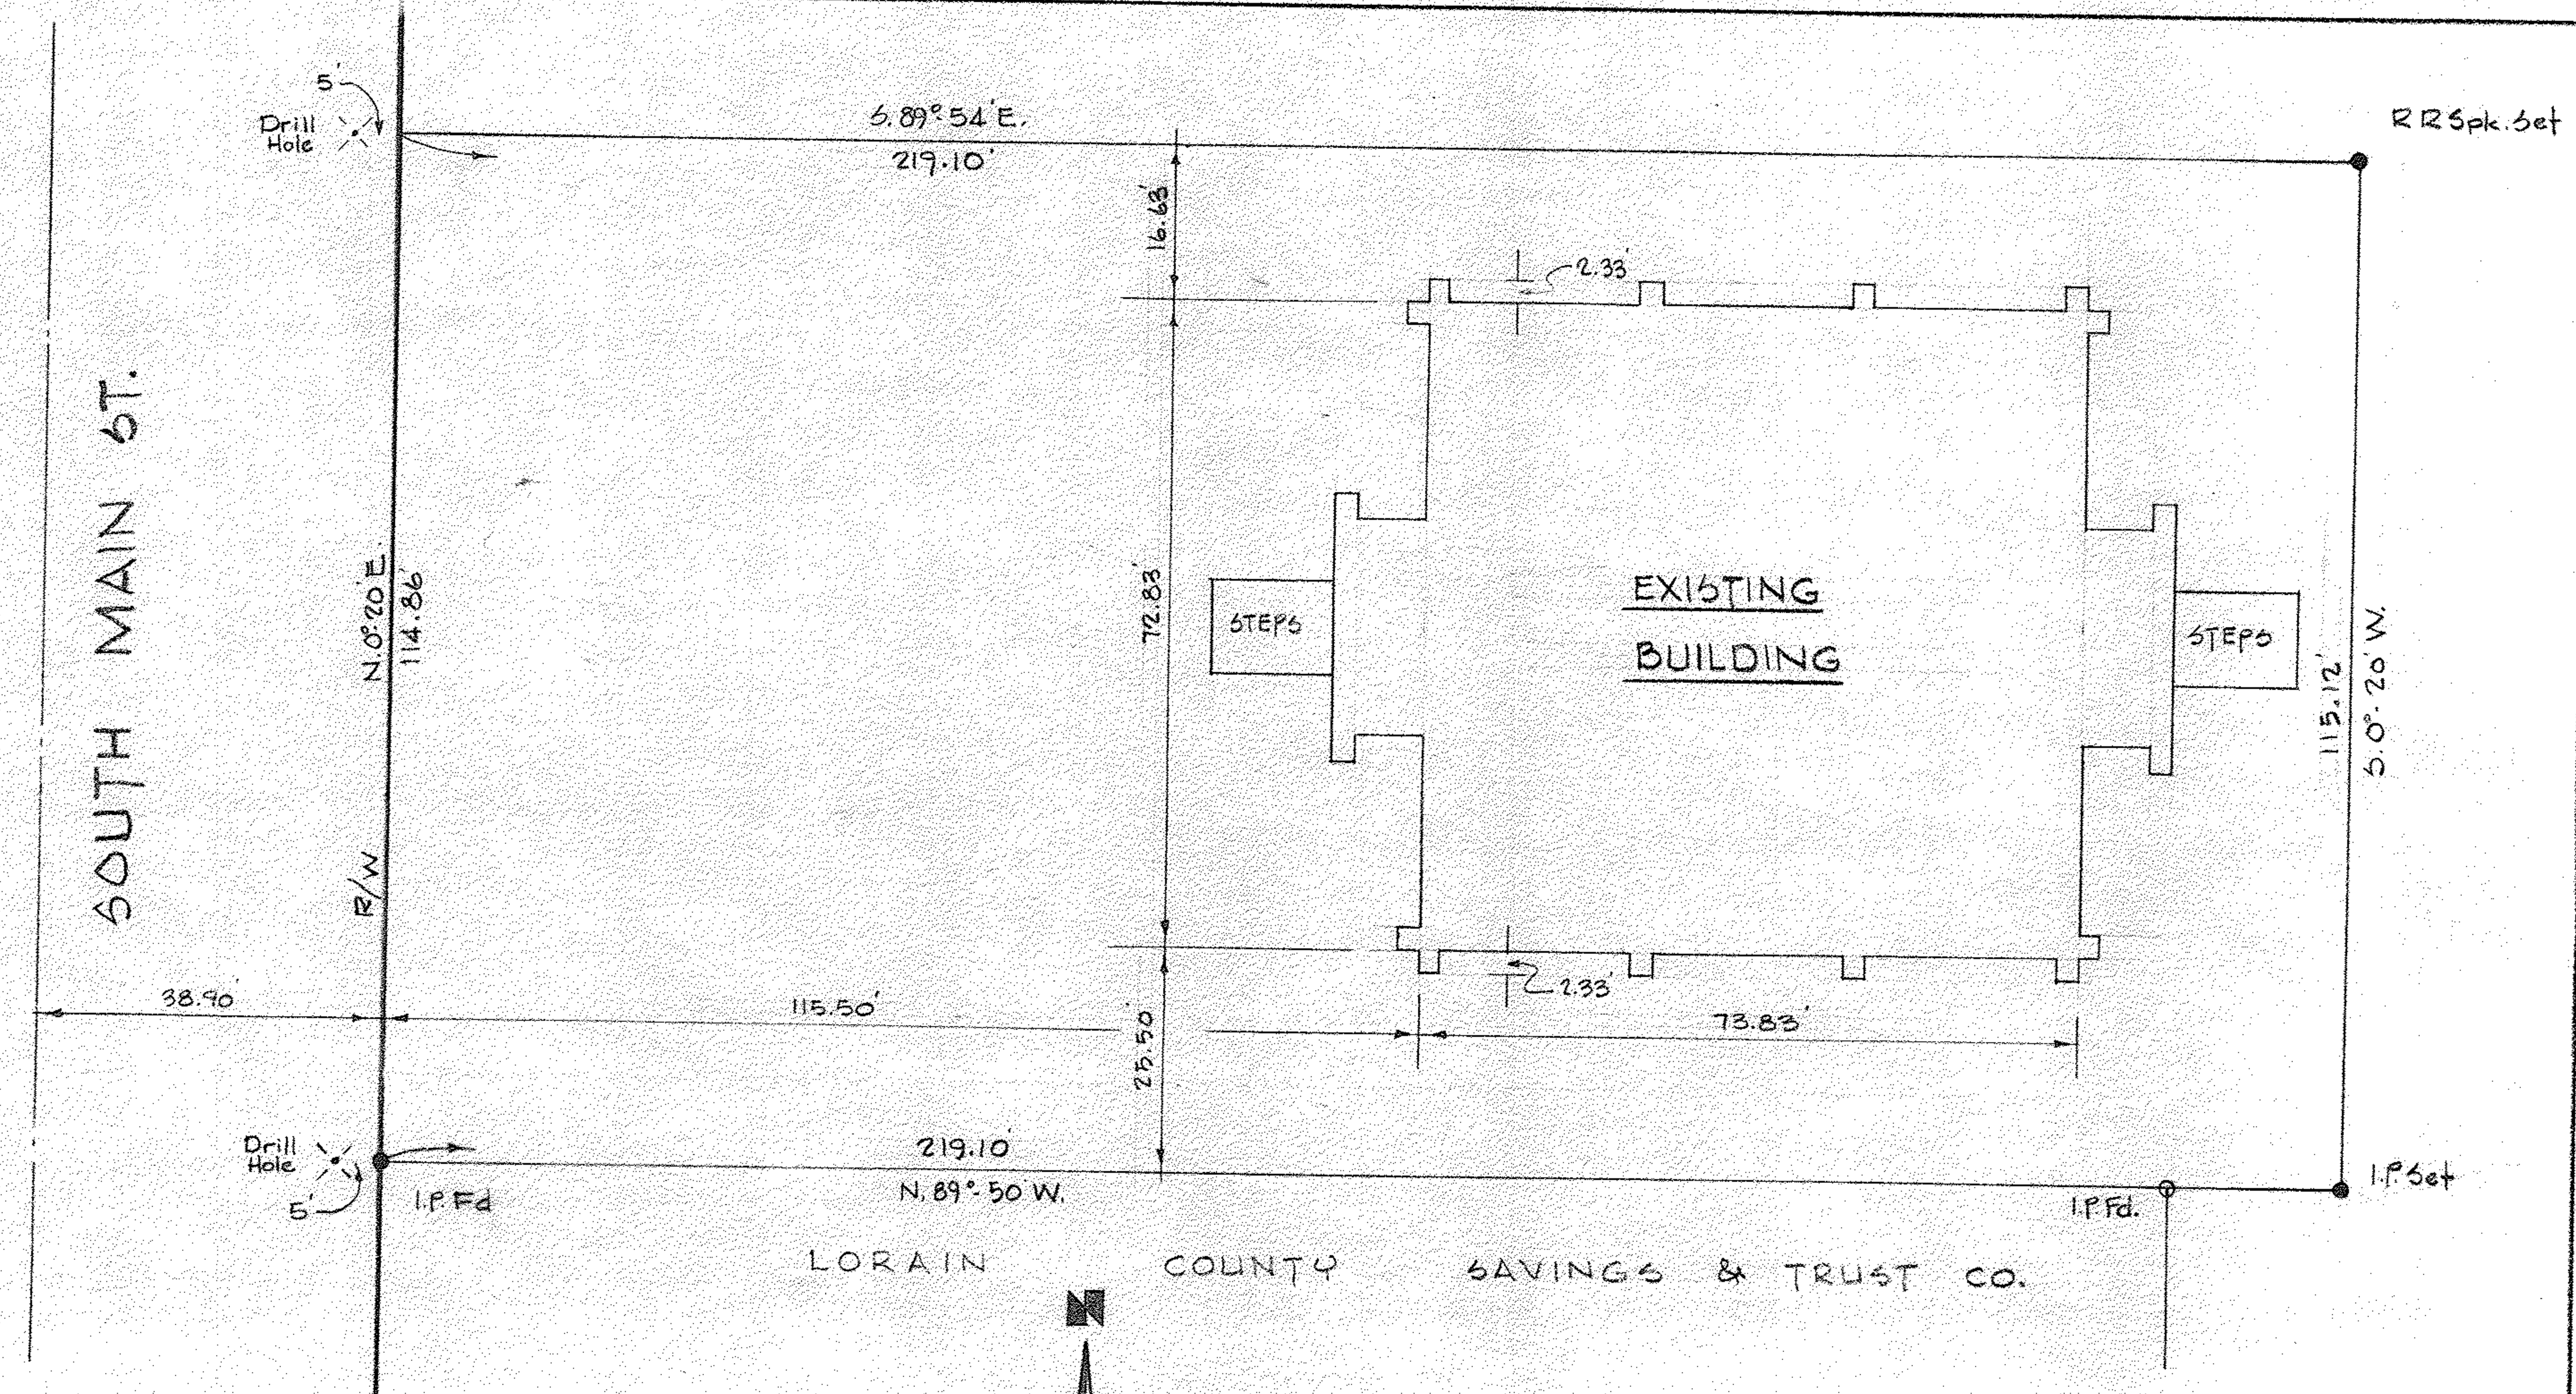


LORAIN COUNTY SAVINGS & TRUST CO.

CERTIFIED CORRECT AND NO ENCROACHMENTS FOUND.

*Rodger G. Wilson*

MADE FOR AND AT THE INSTANCE OF: MINNESOTA TITLE CO.

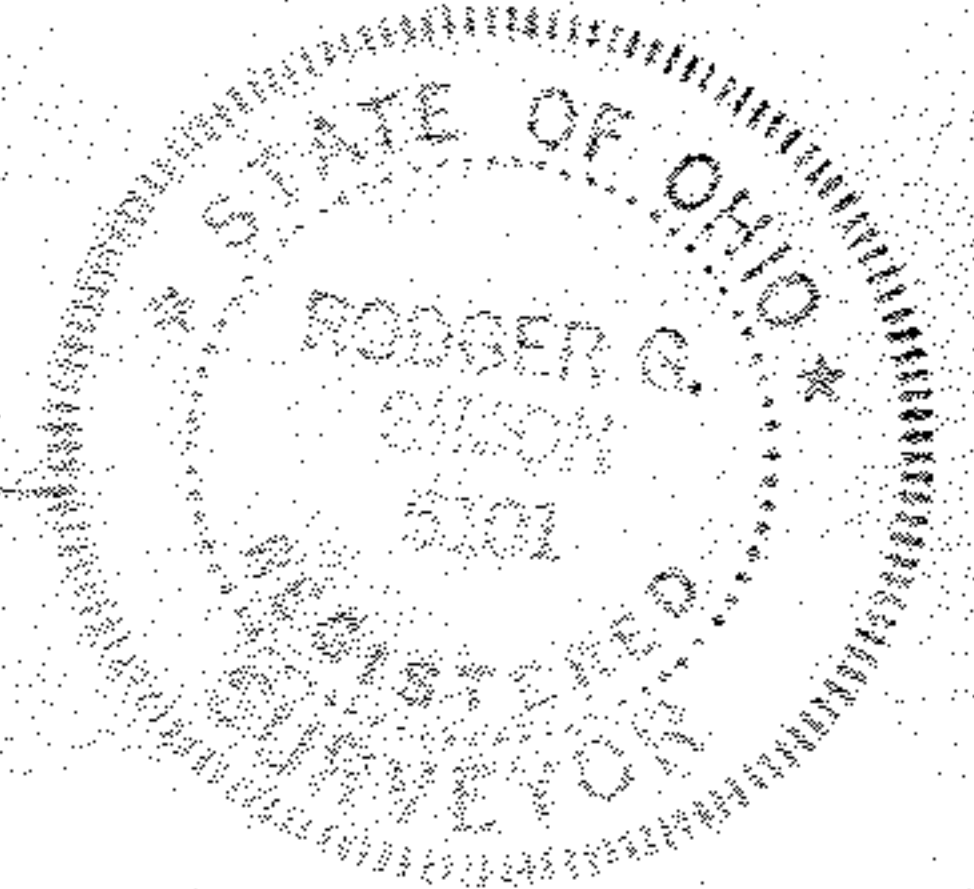

SCALE 1"=20'  
JAN. 17, 1980  
Job No. 80-942

BUILDING LOCATION FOR  
ARTHUR H. CLARK

PART OF LOTS 34 & 35 ORIG. VILLAGE PLAT  
O.L. 86 RUSSIA TWP. CITY OF OBERLIN  
LORAIN COUNTY OHIO  
LAUNDON • SIMON • CAHL & ASSOC., INC.  
ENGINEERS SURVEYORS