

# J. W. WARDEN & ASSOCIATES


## CIVIL ENGINEERS AND SURVEYORS

D. D. ANDRUS, PRESIDENT  
405 ELYRIA BLOCK  
ELYRIA, OHIO

TELEPHONES 3211  
42871

M. W. JACKSON  
SECRETARY

STATE OF OHIO  
REGISTERED PROFESSIONAL ENG.  
SURVEYOR

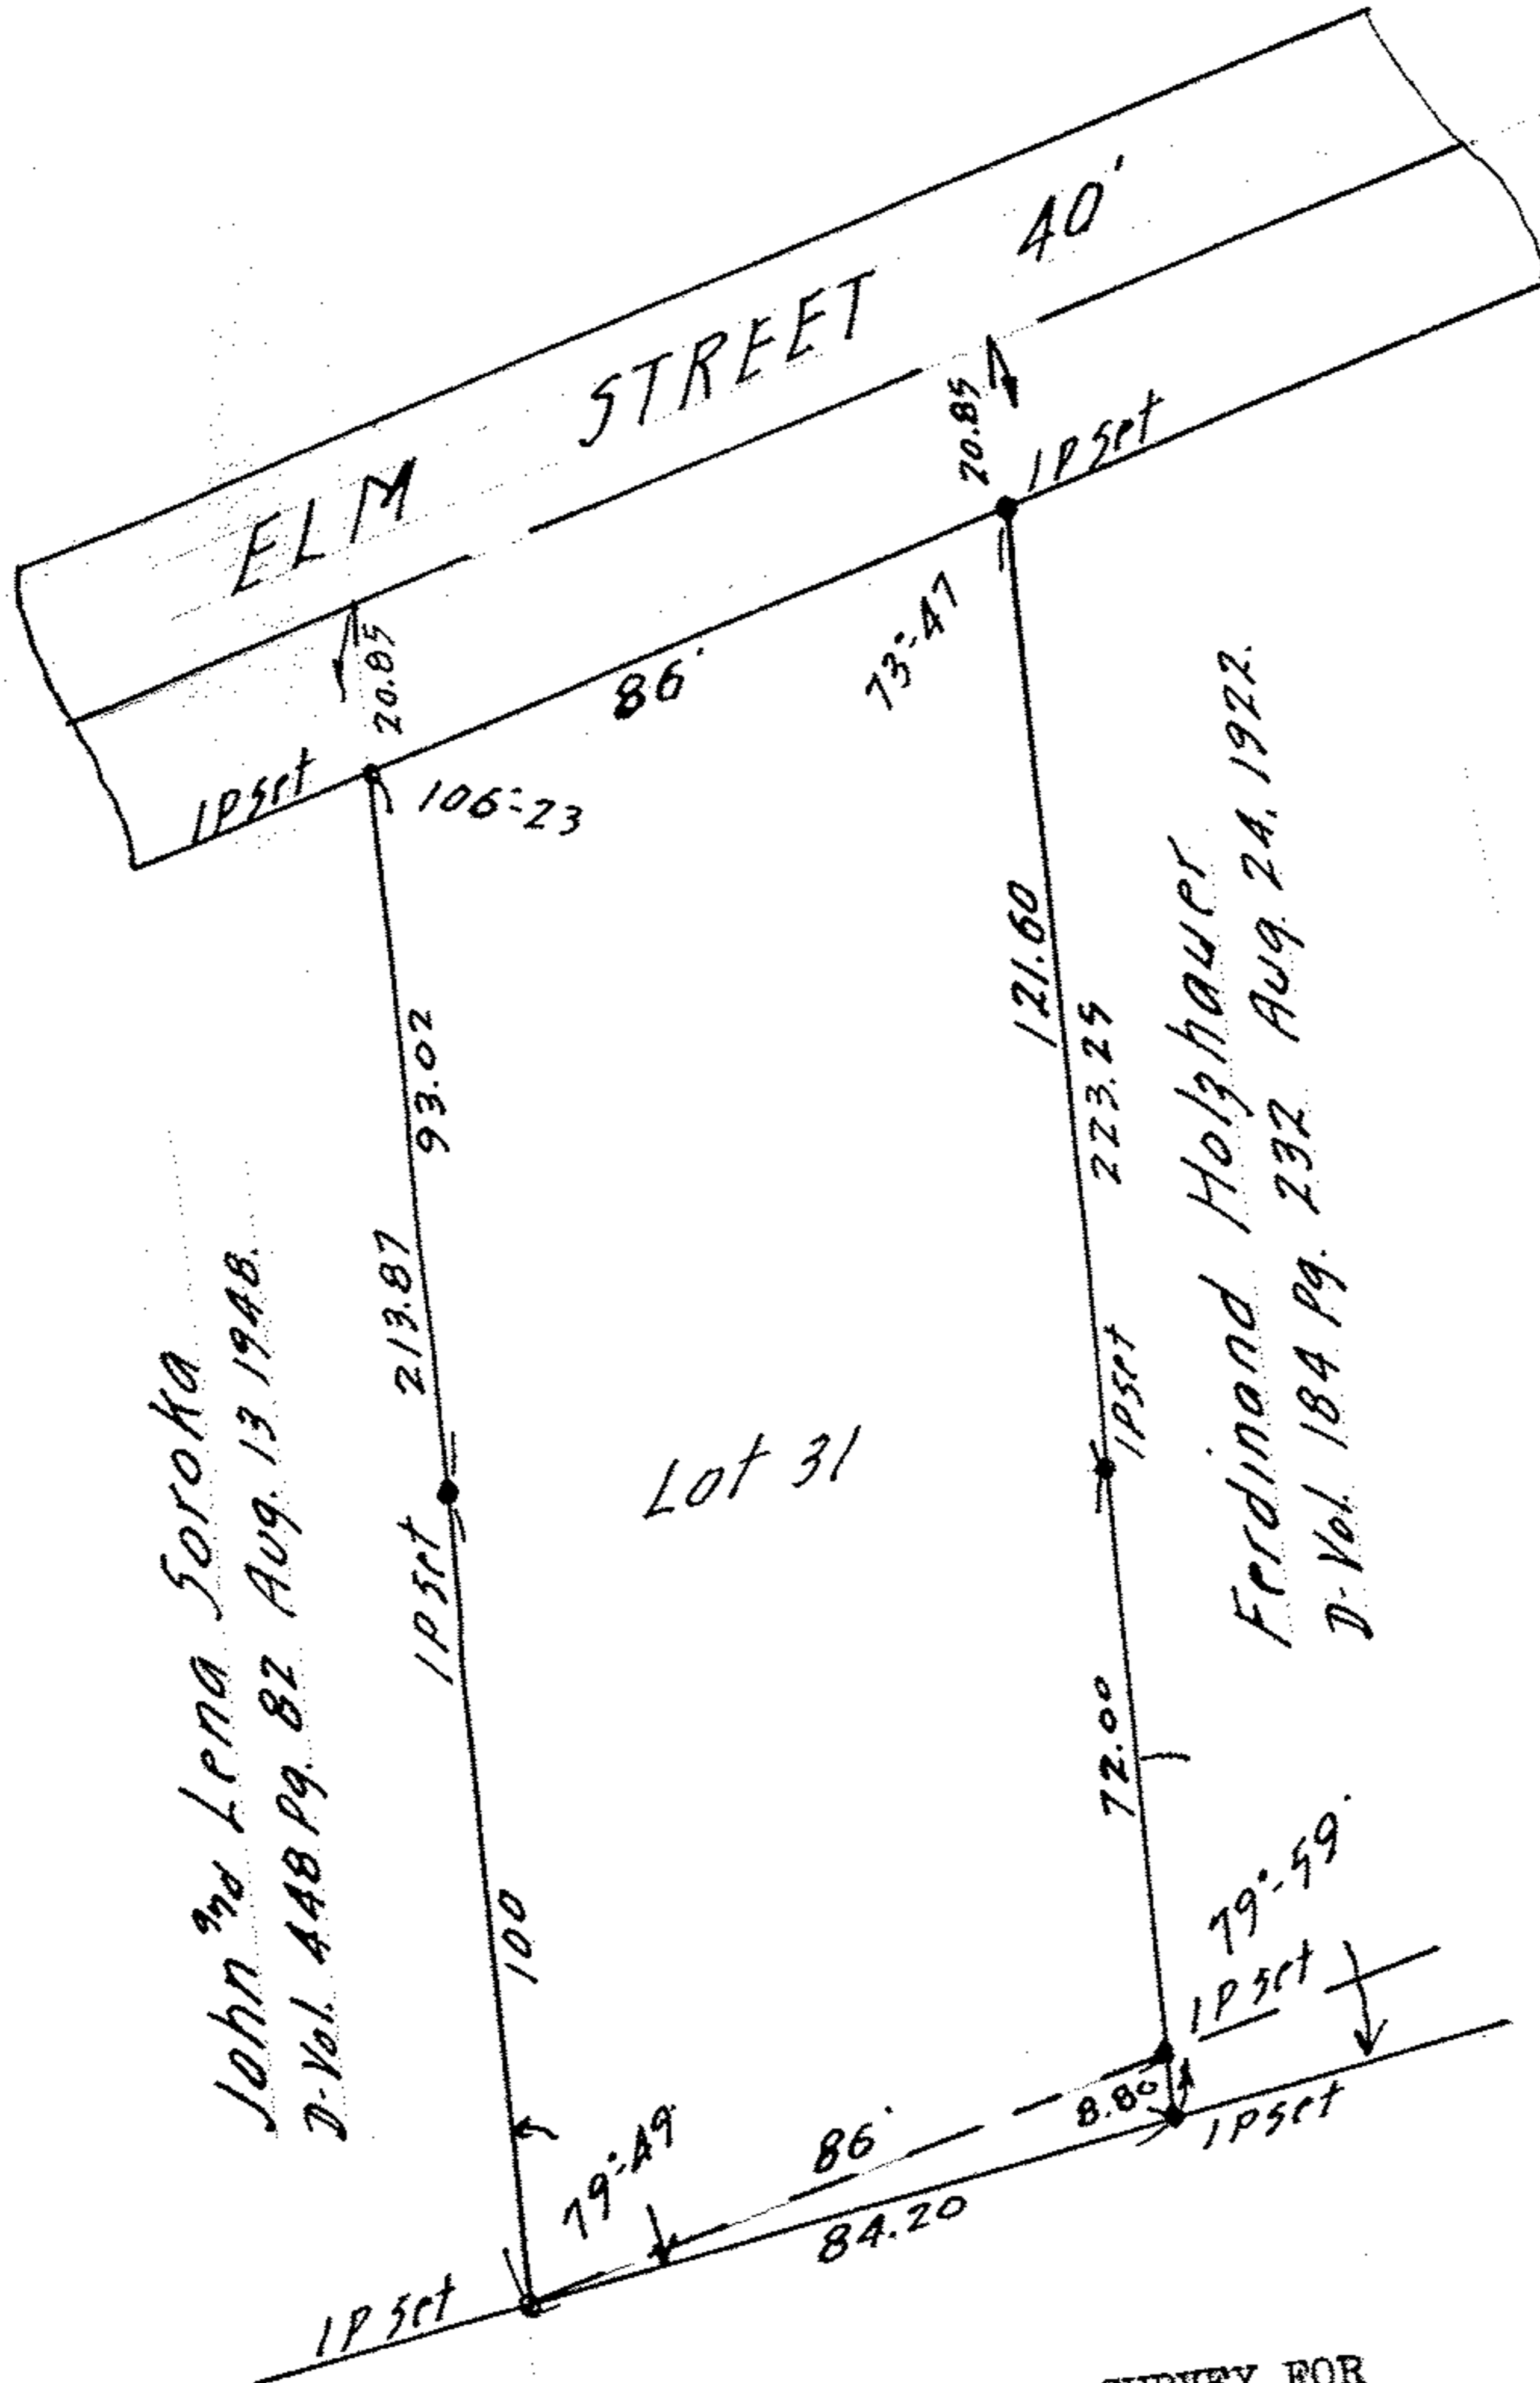

John and Lena Soroka  
D. Vol. 448 Pg. 82 Aug. 13 1948.

Ferdinand Holzhauser  
D. Vol. 184 Pg. 232 Aug. 24 1922.

PPN 05-00-091-108-004

MAP PG 05-00-091-C 44399

SURVEY FOR  
WM. AND EMMA WIRTH  
D-VOL. 286 PG. 382 JUNE 19, 1937  
LOT 31 REDFERNS 2nd ADDN. VOL. 4 PG. 3  
SOUTH AMHERST VILLAGE, LORAIN COUNTY, OHIO  
SCALE 1" = 40' April 22, 1953