


OBERLIN ROAD

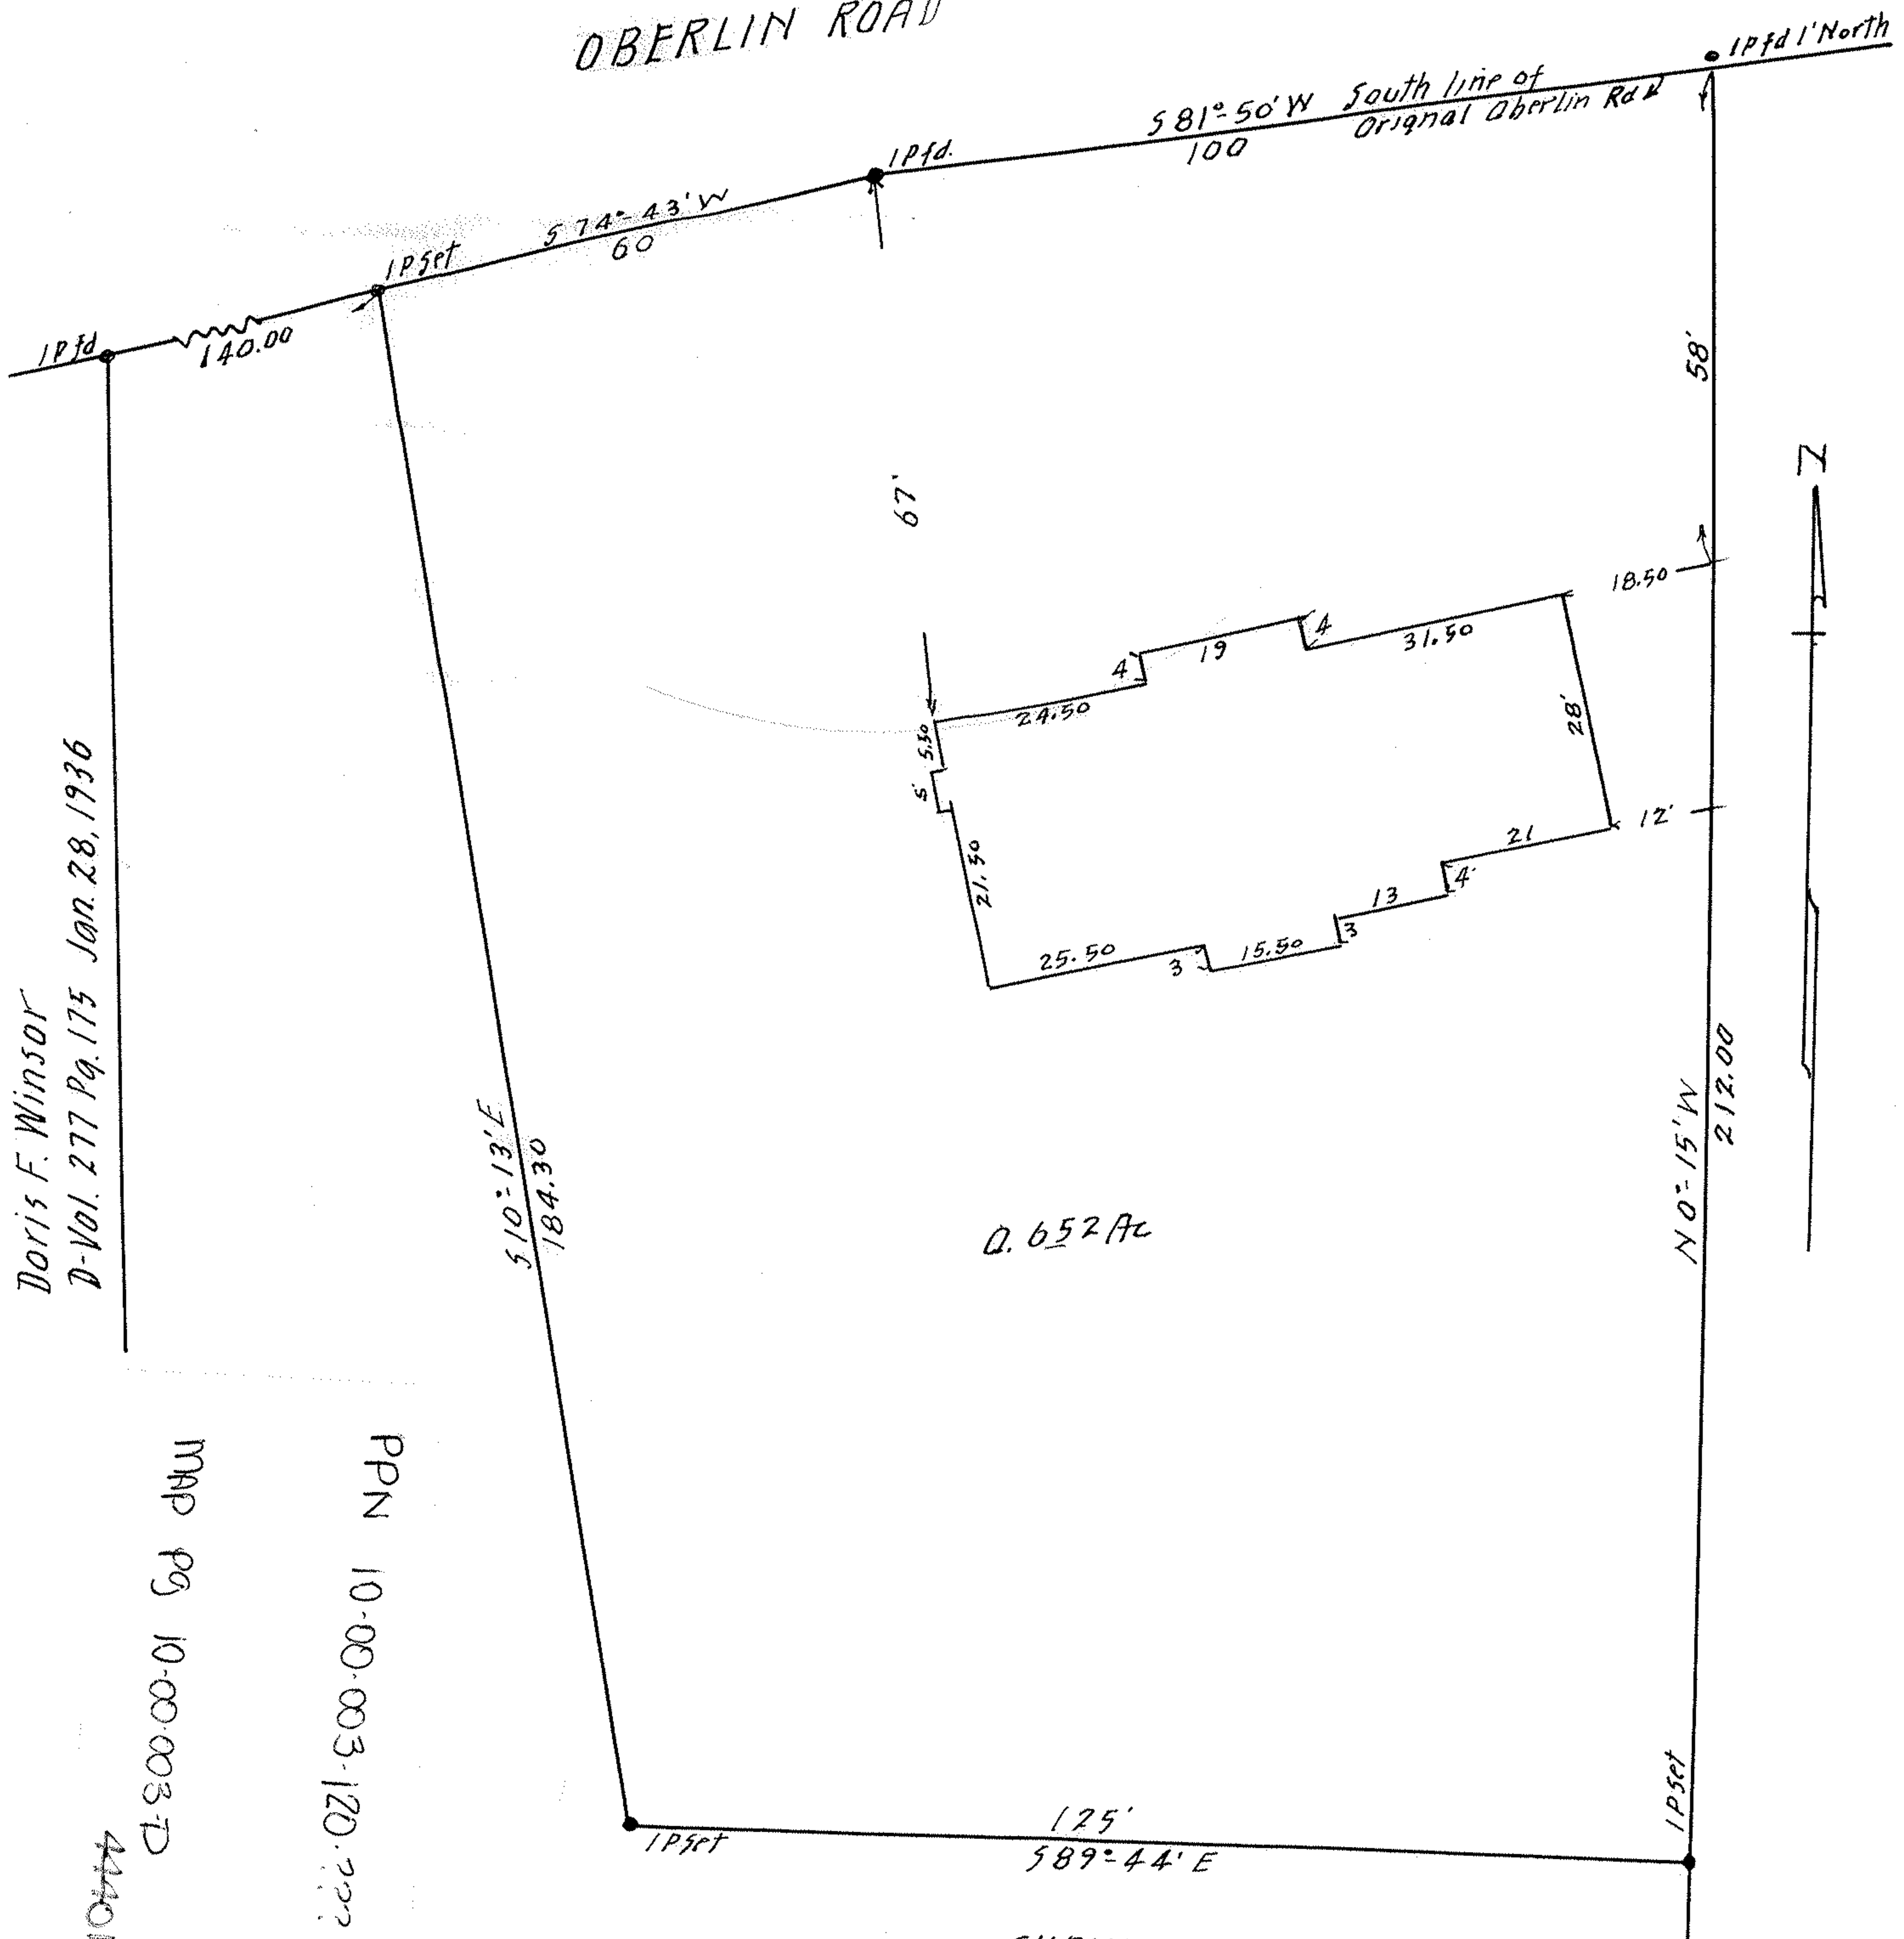

0.652 Ac

Doris F. Winsor
D-Vol. 277 Pg. 175 Jan. 28, 1936

MAP PG 10-00-003-D
PPN 10-00-003-120-???

44401

SURVEY FOR
MATT HERMAN
D-Vol. 673 Pg. 605 August 22 1956
Section 3 Carlisle Township
Lorain County O.
Scale 1" = 20' Feb. 27 1968
D. D. Andrus Reg. Surveyor.

600363