

J. W. WARDEN & ASSOCIATES

CIVIL ENGINEERS AND SURVEYORS

D. D. ANDRUS, PRESIDENT

405 ELYRIA BLOCK


ELYRIA, OHIO

STATE OF OHIO

REGISTERED } PROFESSIONAL ENG.
SURVEYOR

TELEPHONES 3211
42871

M. W. JACKSON
SECRETARY

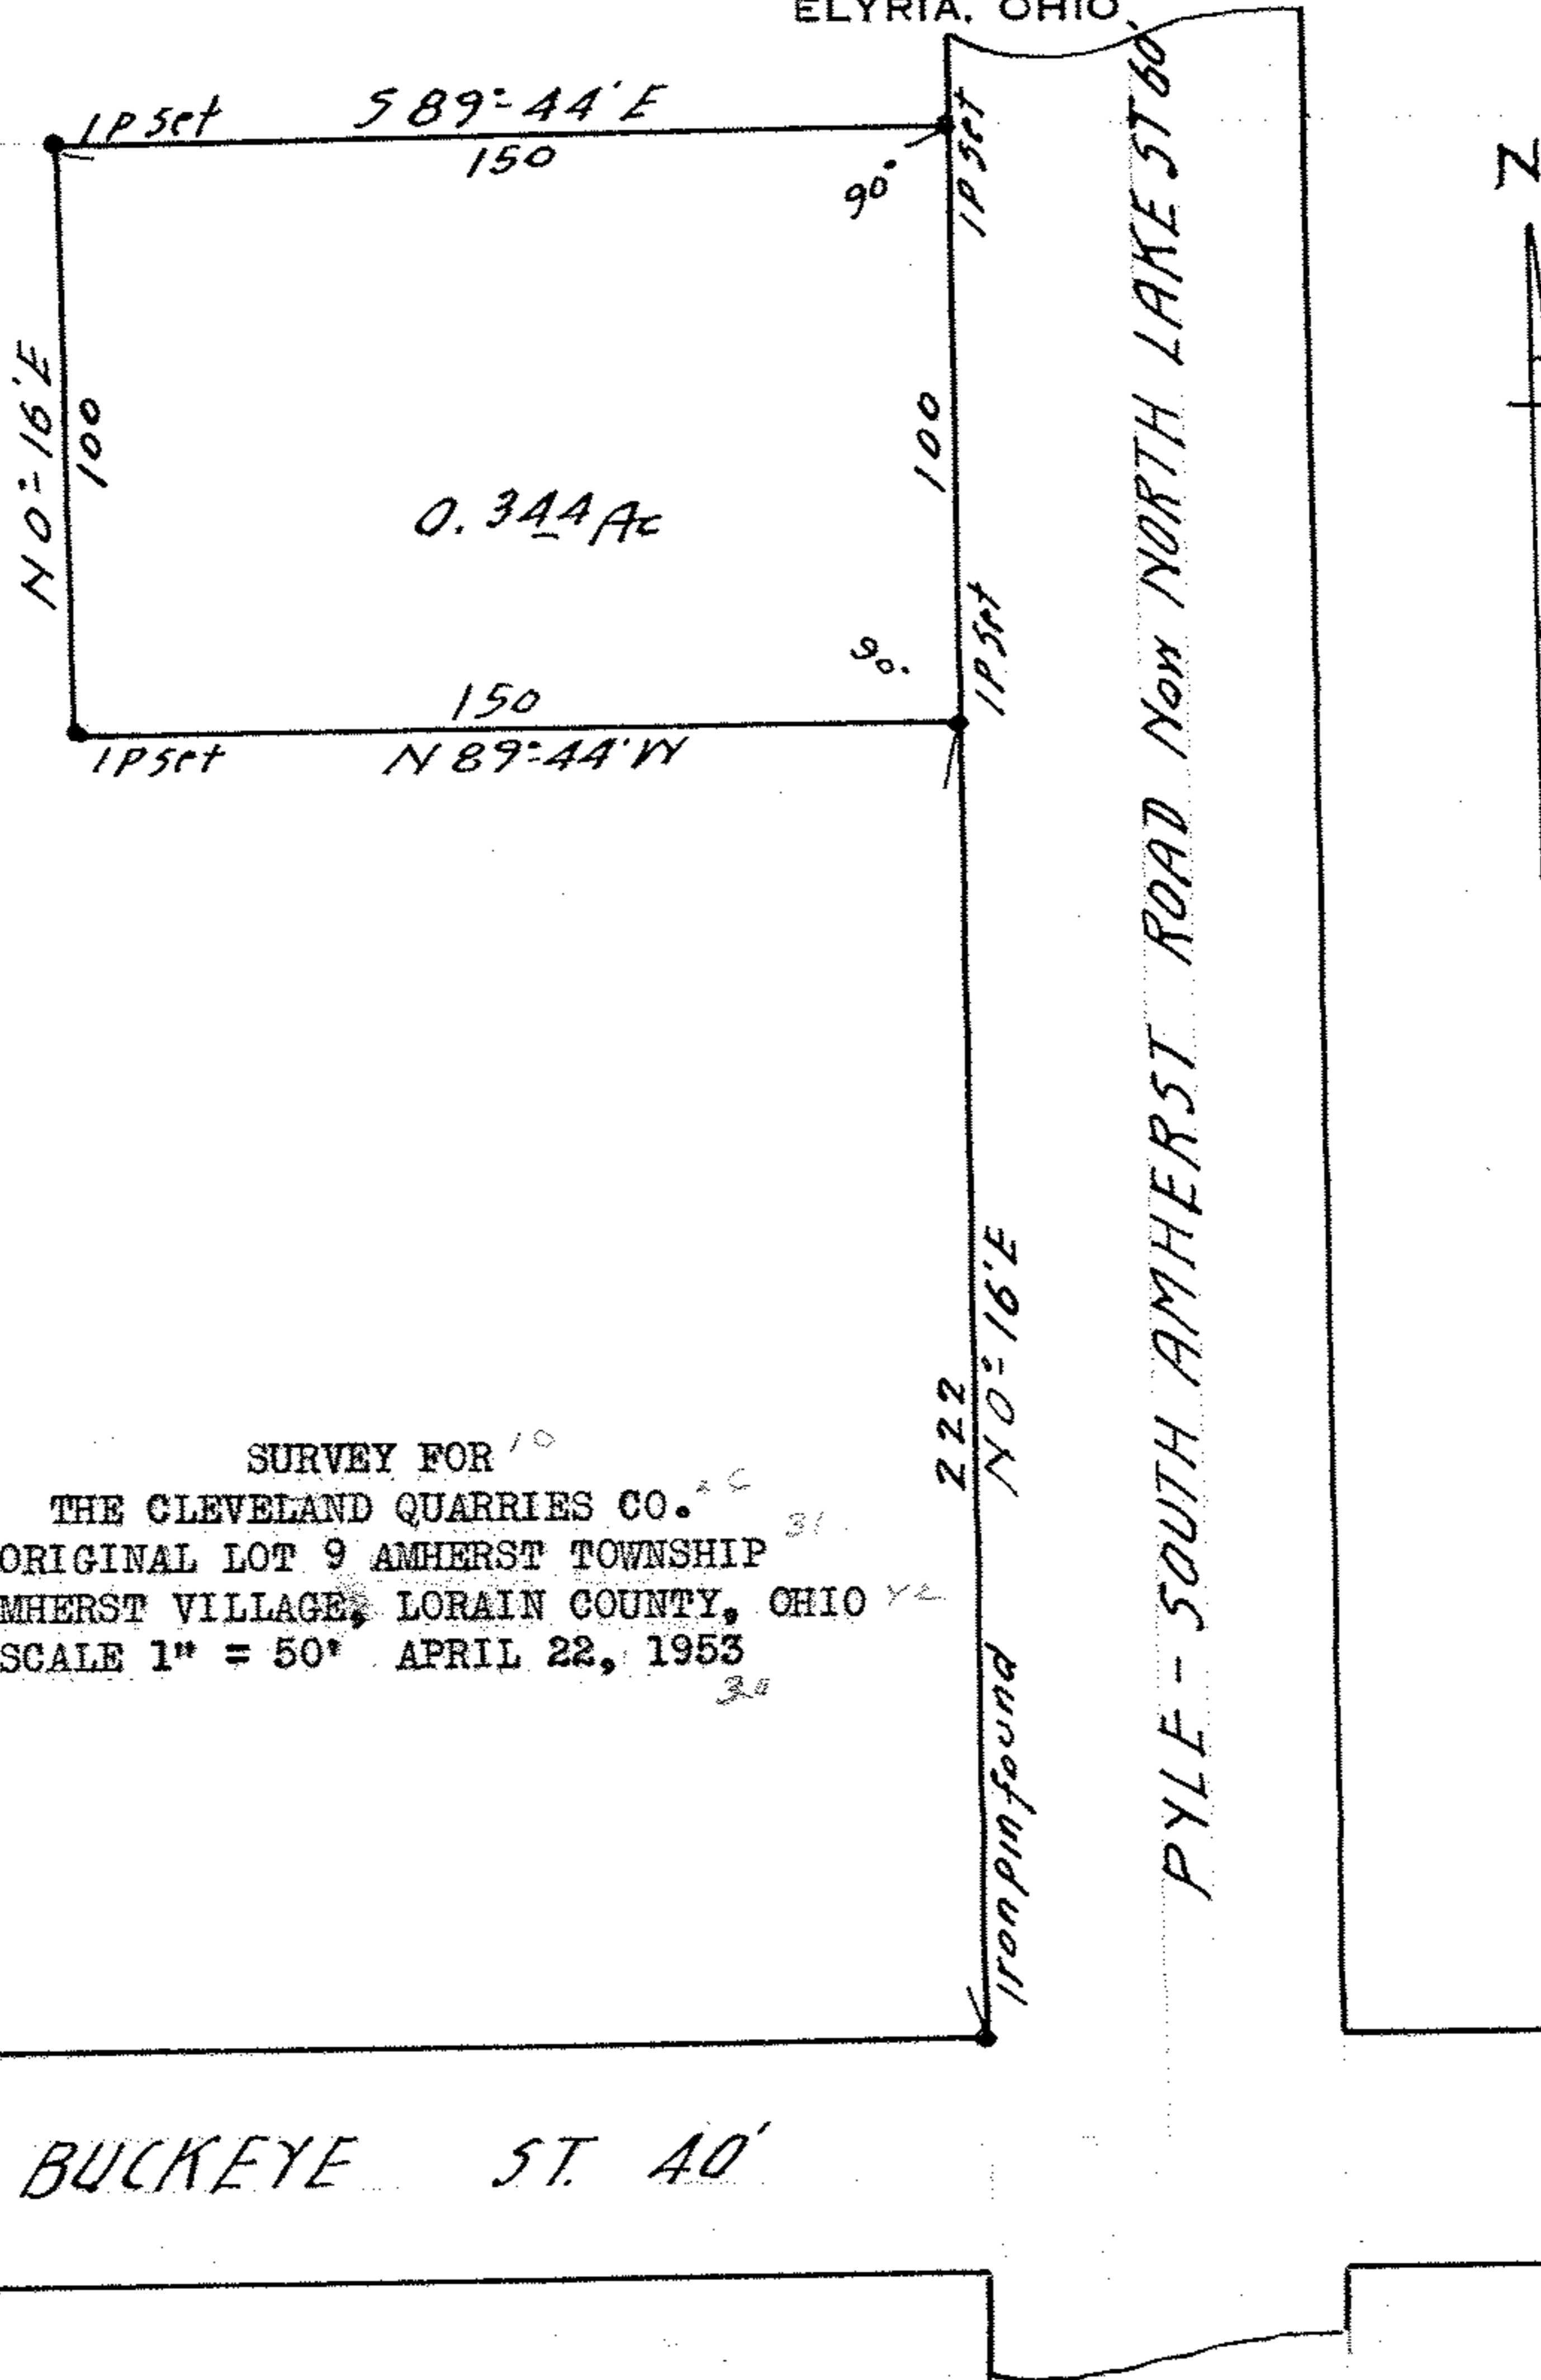

SURVEY FOR
 THE CLEVELAND QUARRIES CO.
 ORIGINAL LOT 9 AMHERST TOWNSHIP
 SOUTH AMHERST VILLAGE, LORAIN COUNTY, OHIO
 SCALE 1" = 50' APRIL 22, 1953

100 729 B