


50157

LAKE AVE.

NICHOLS CT.

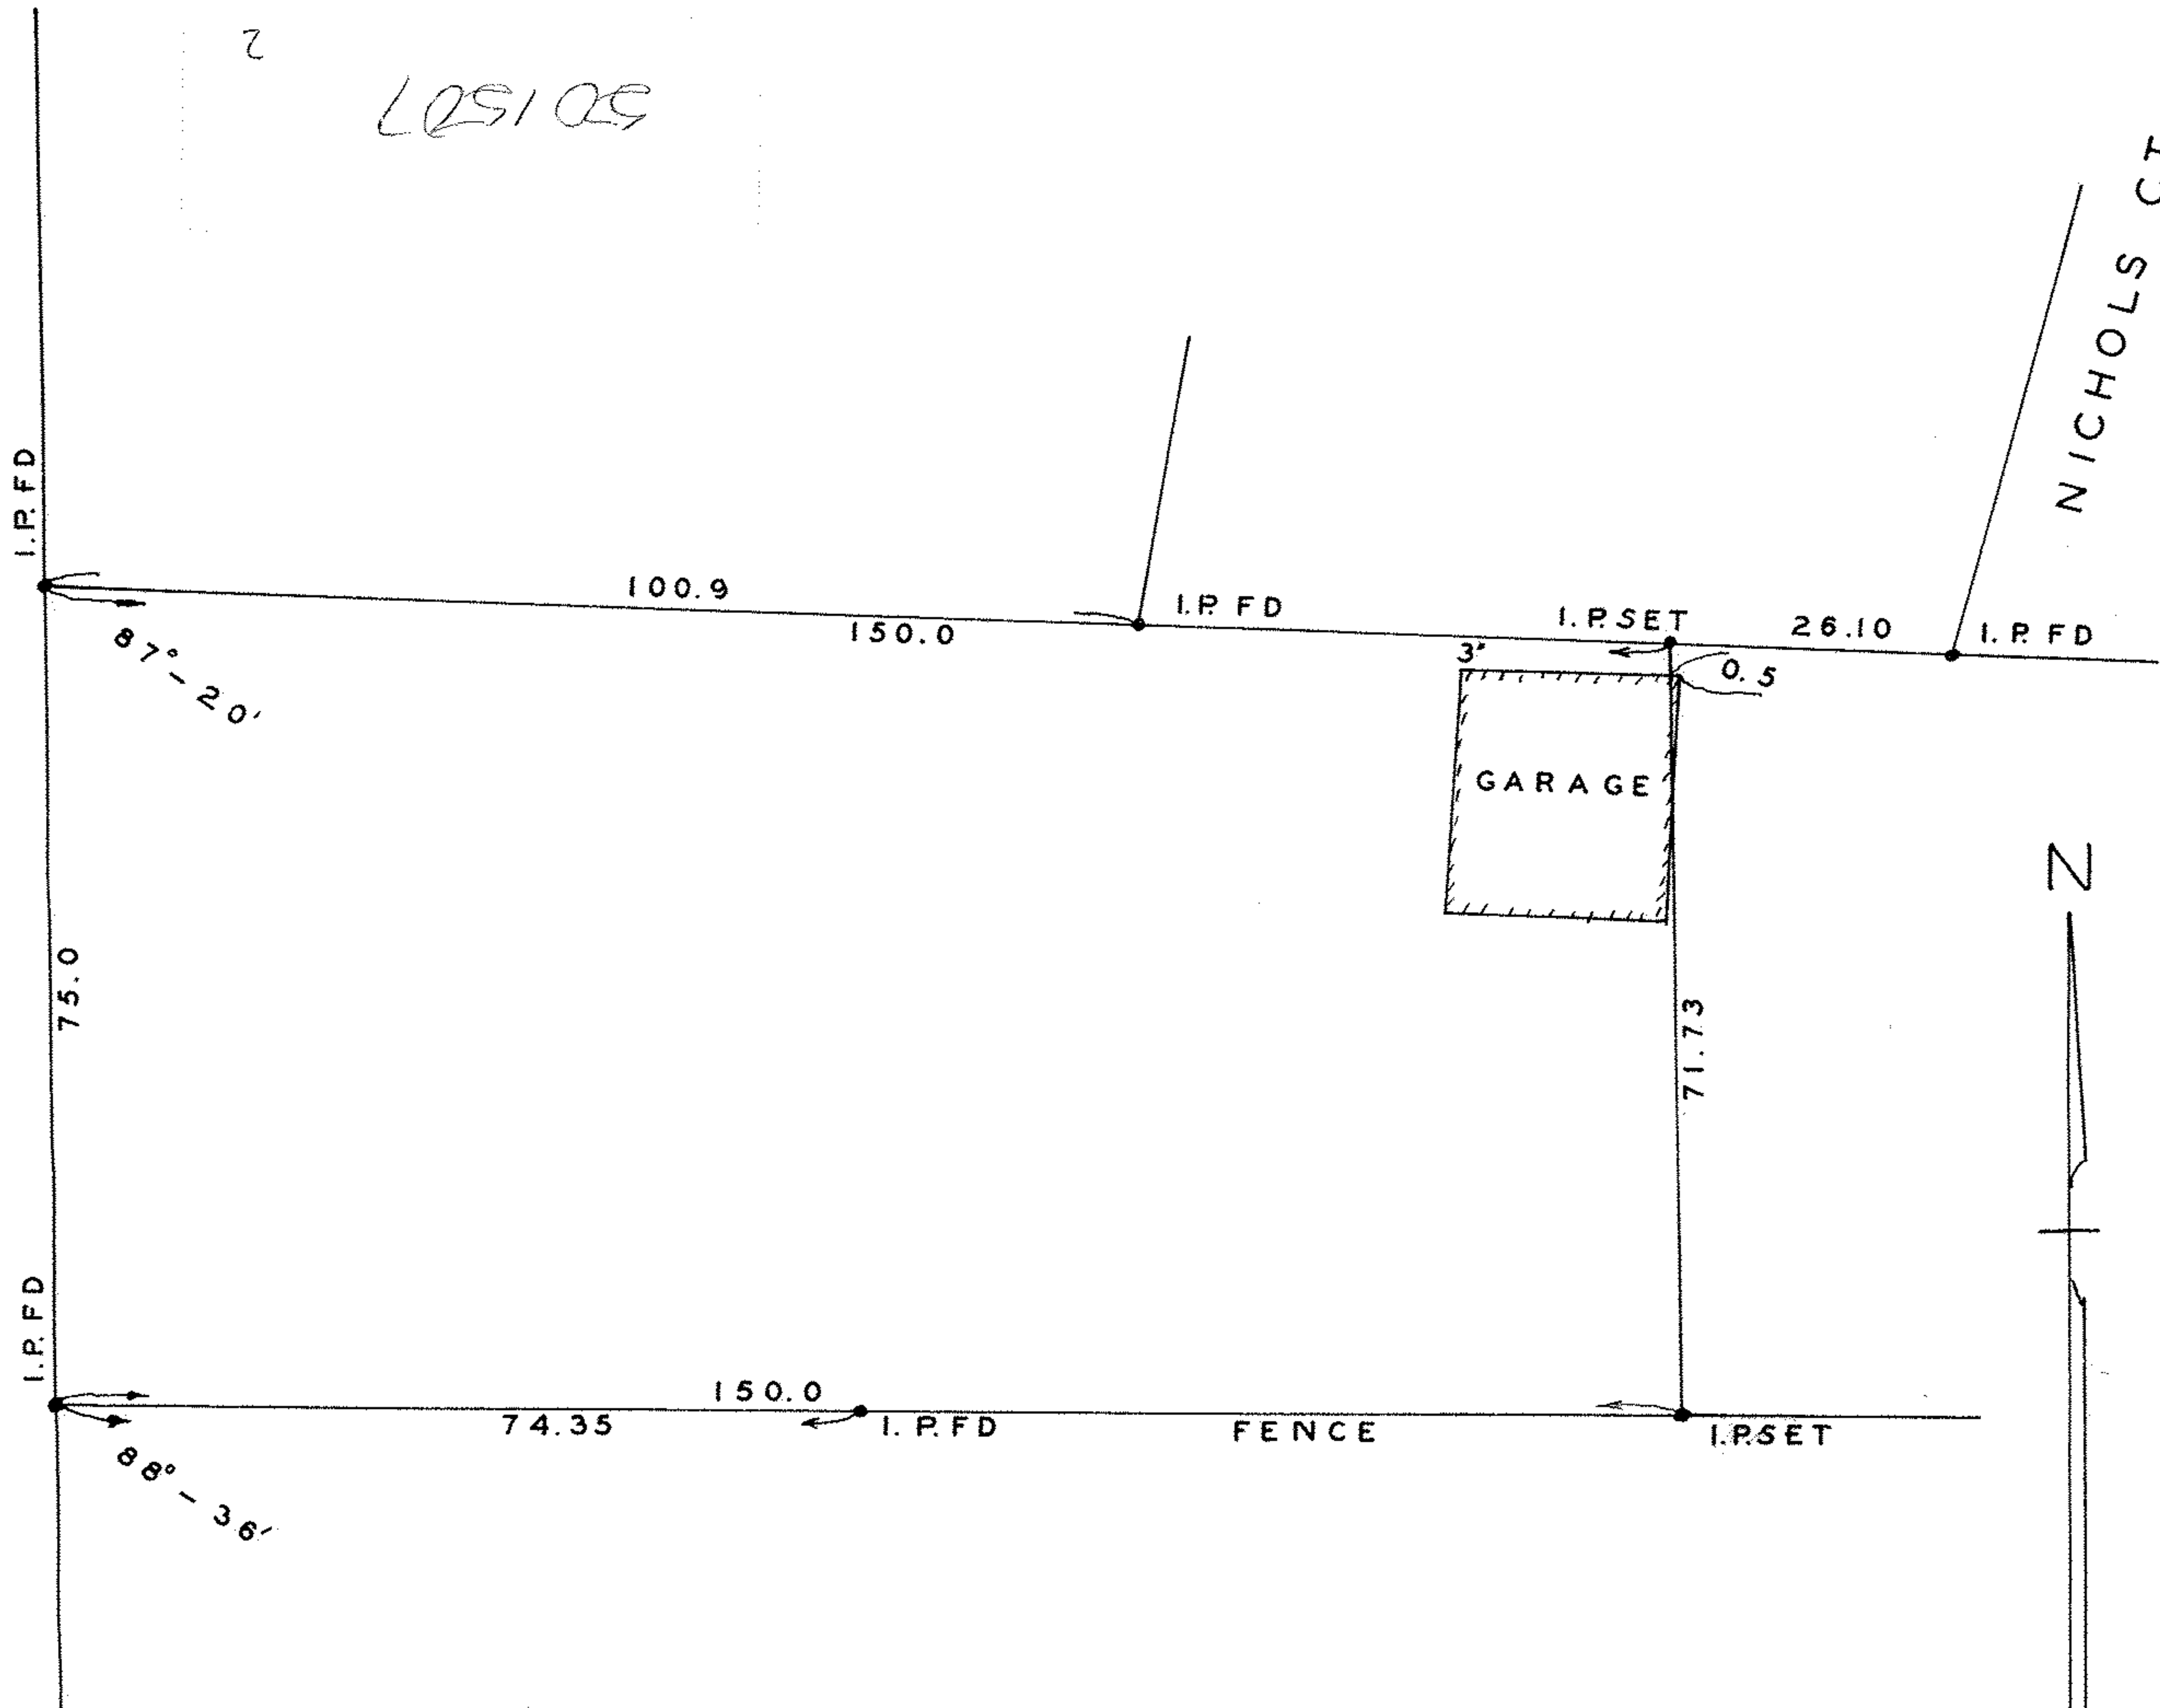

PPN 06-24-080-000-???

MAP PG 6-80 44410

SURVEY FOR
 STEVENSON E. BURKE
 D-VOL 799 PG 117 JUNE 19, 1961
 LOT 80 - 81 W. OF BLACK RIVER
 L. L. SEARS SUBDIVISION
 MAP VOL 4 PG 34
 SCALE 1" = 20' APRIL 28, 1966
 D. D. ANDRUS AND ASSOCIATES
 REG SURVEYORS