

# J. W. WARDEN & ASSOCIATES


## CIVIL ENGINEERS AND SURVEYORS

D. D. ANDRUS, PRESIDENT  
405 ELYRIA BLOCK  
ELYRIA, OHIO

TELEPHONES 3211  
42871

M. W. JACKSON  
SECRETARY

STATE OF OHIO  
REGISTERED } PROFESSIONAL ENG.  
SURVEYOR

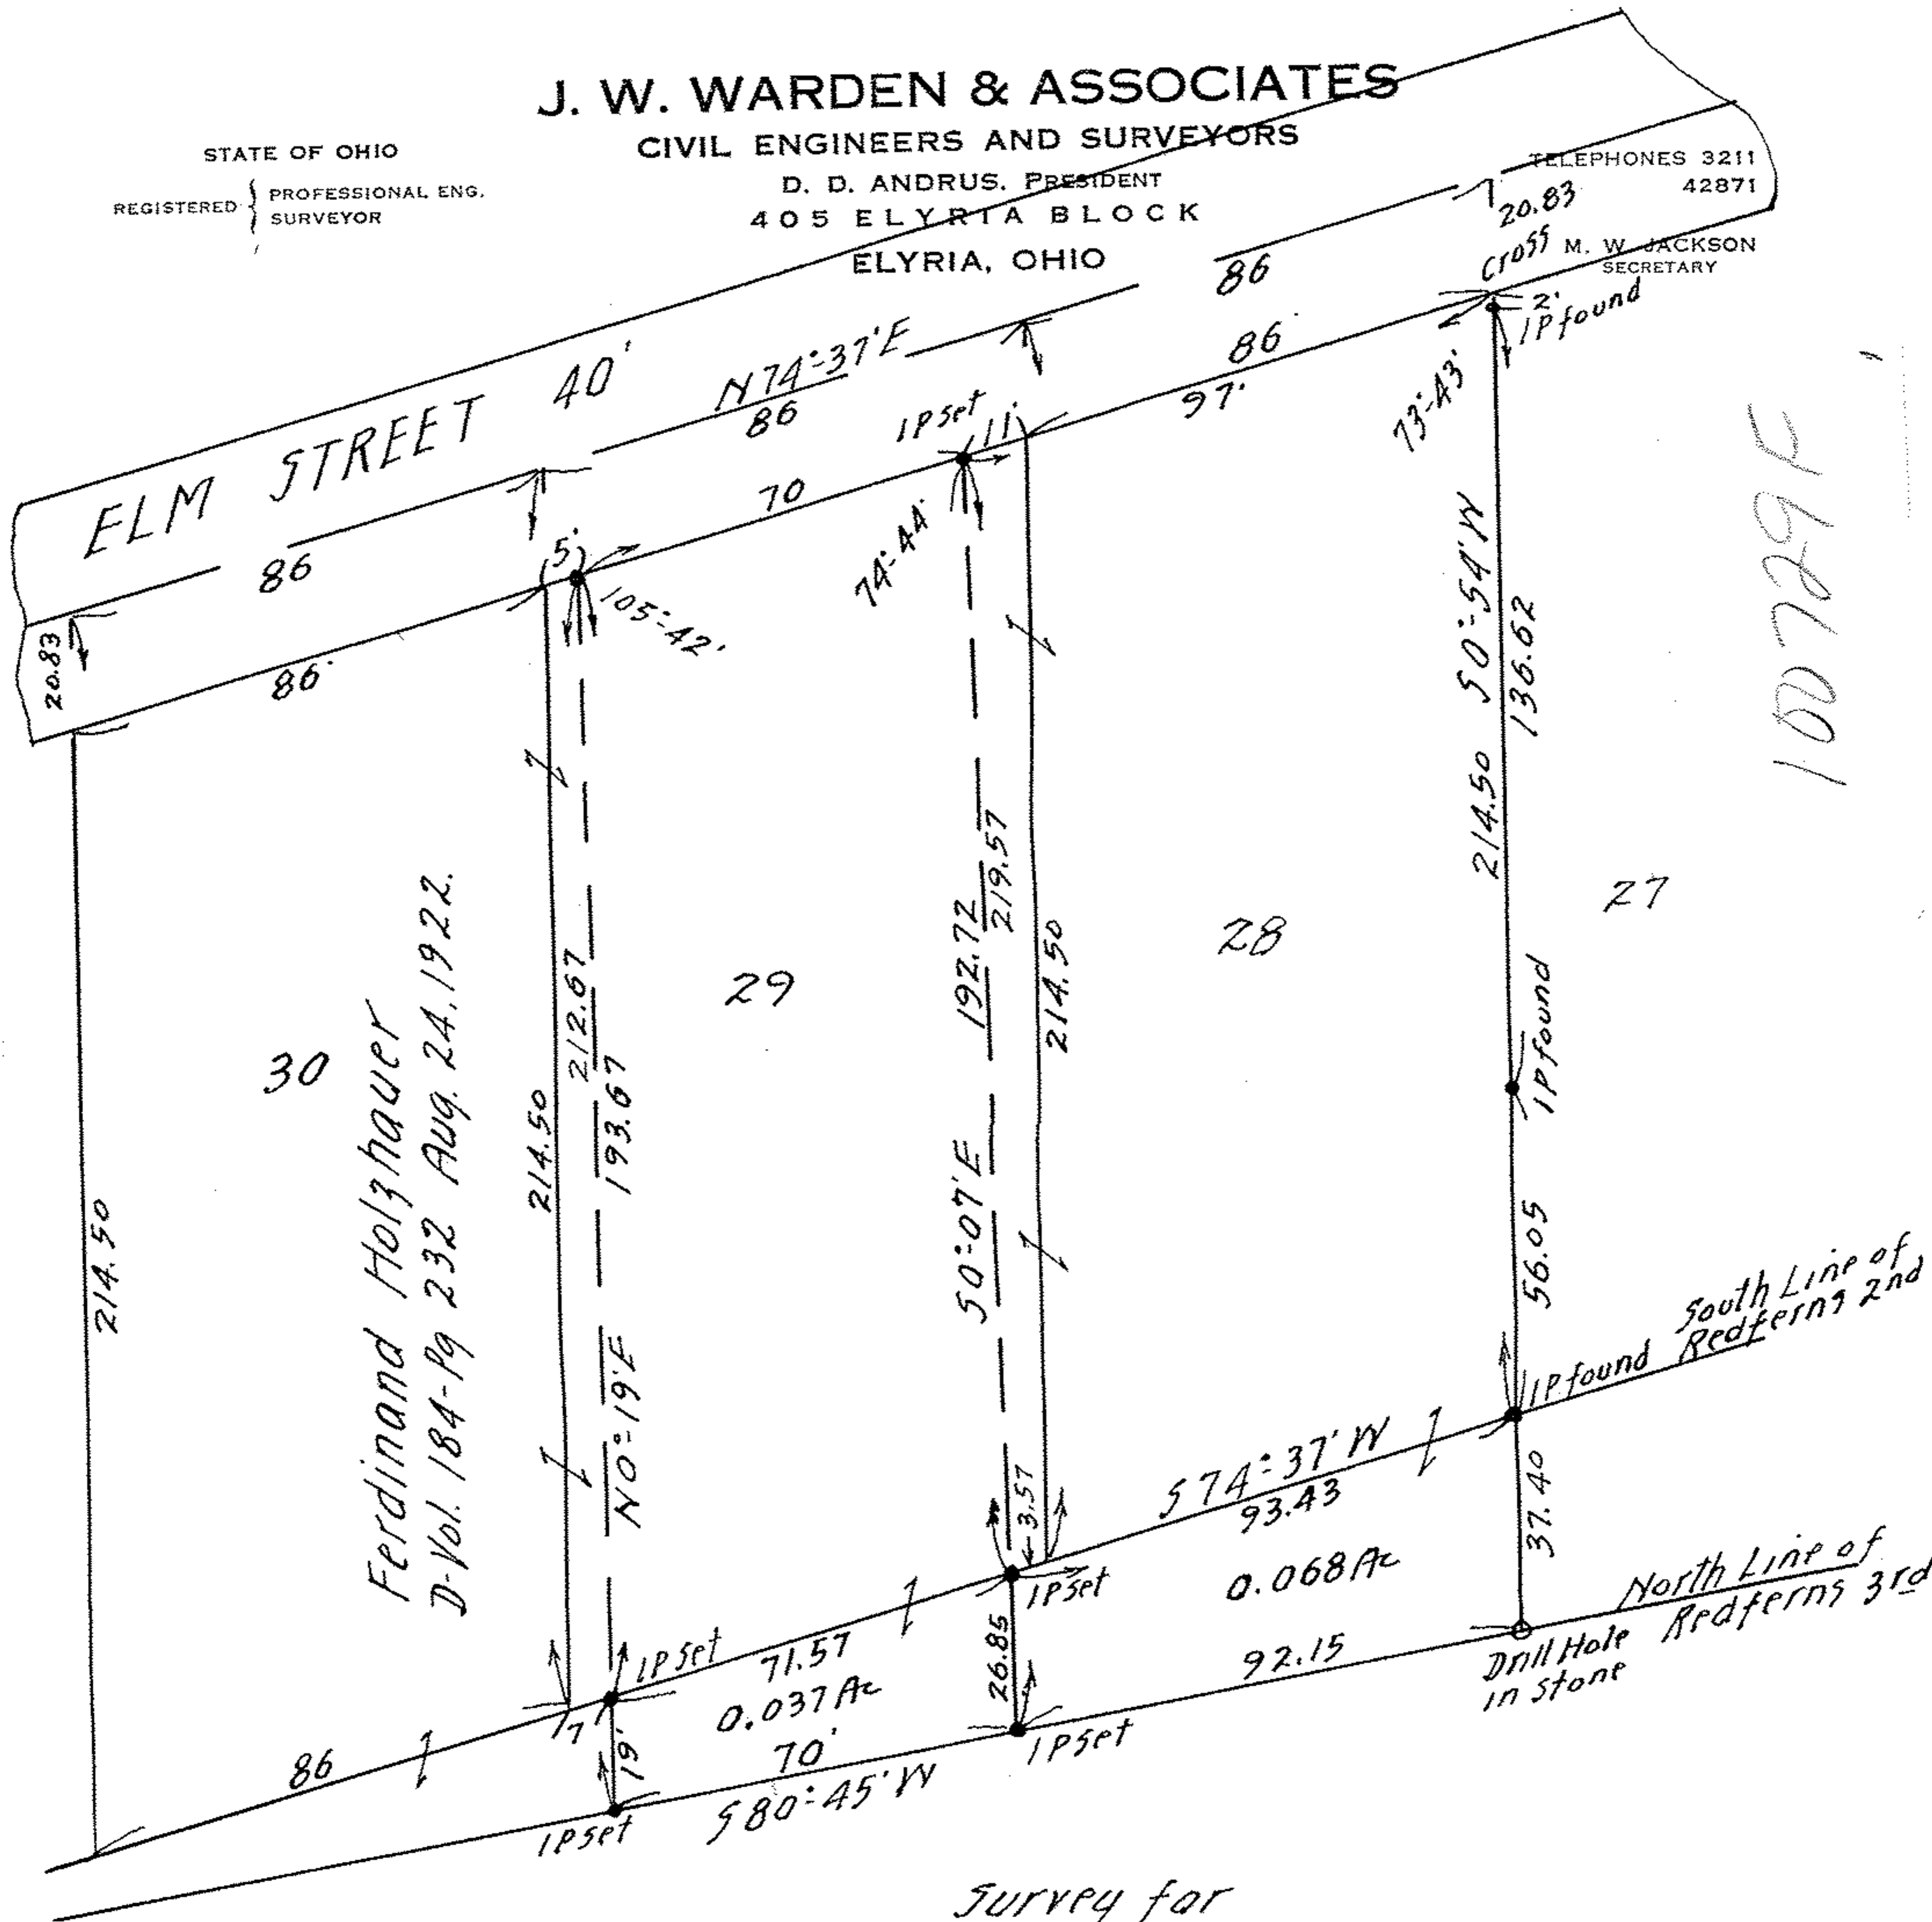

Ferdinand Holzhauser  
D-Vol. 184-Pg 232 Aug. 24, 1922.

100729F

Survey for  
ALBERT O. 9th CORA E. SCHNEIDER  
Original Lot 91 Amherst Township.  
Lots 28-29 Redfern's 2nd Addn. Vol 4 Pg 3  
South Amherst Village, Lorain County Ohio.  
Scale 1" = 40' Feb. 29, 1952.