


Survey for  
 THE CLEVELAND QUARRIES CO.  
 Original Lot 9 Amherst TWP.  
 South Amherst Village.  
 Lorain County Ohio.  
 Scale 1" = 50' April 20, 1955.  
 J. W. Warden & Associates Reg. Surveyor's  
 Note - Iron Stakes set at all points thus •

100729D

Eliza and Jennie Joseph  
 D-Val. 454 Pg. 591 Dec. 11 1948.

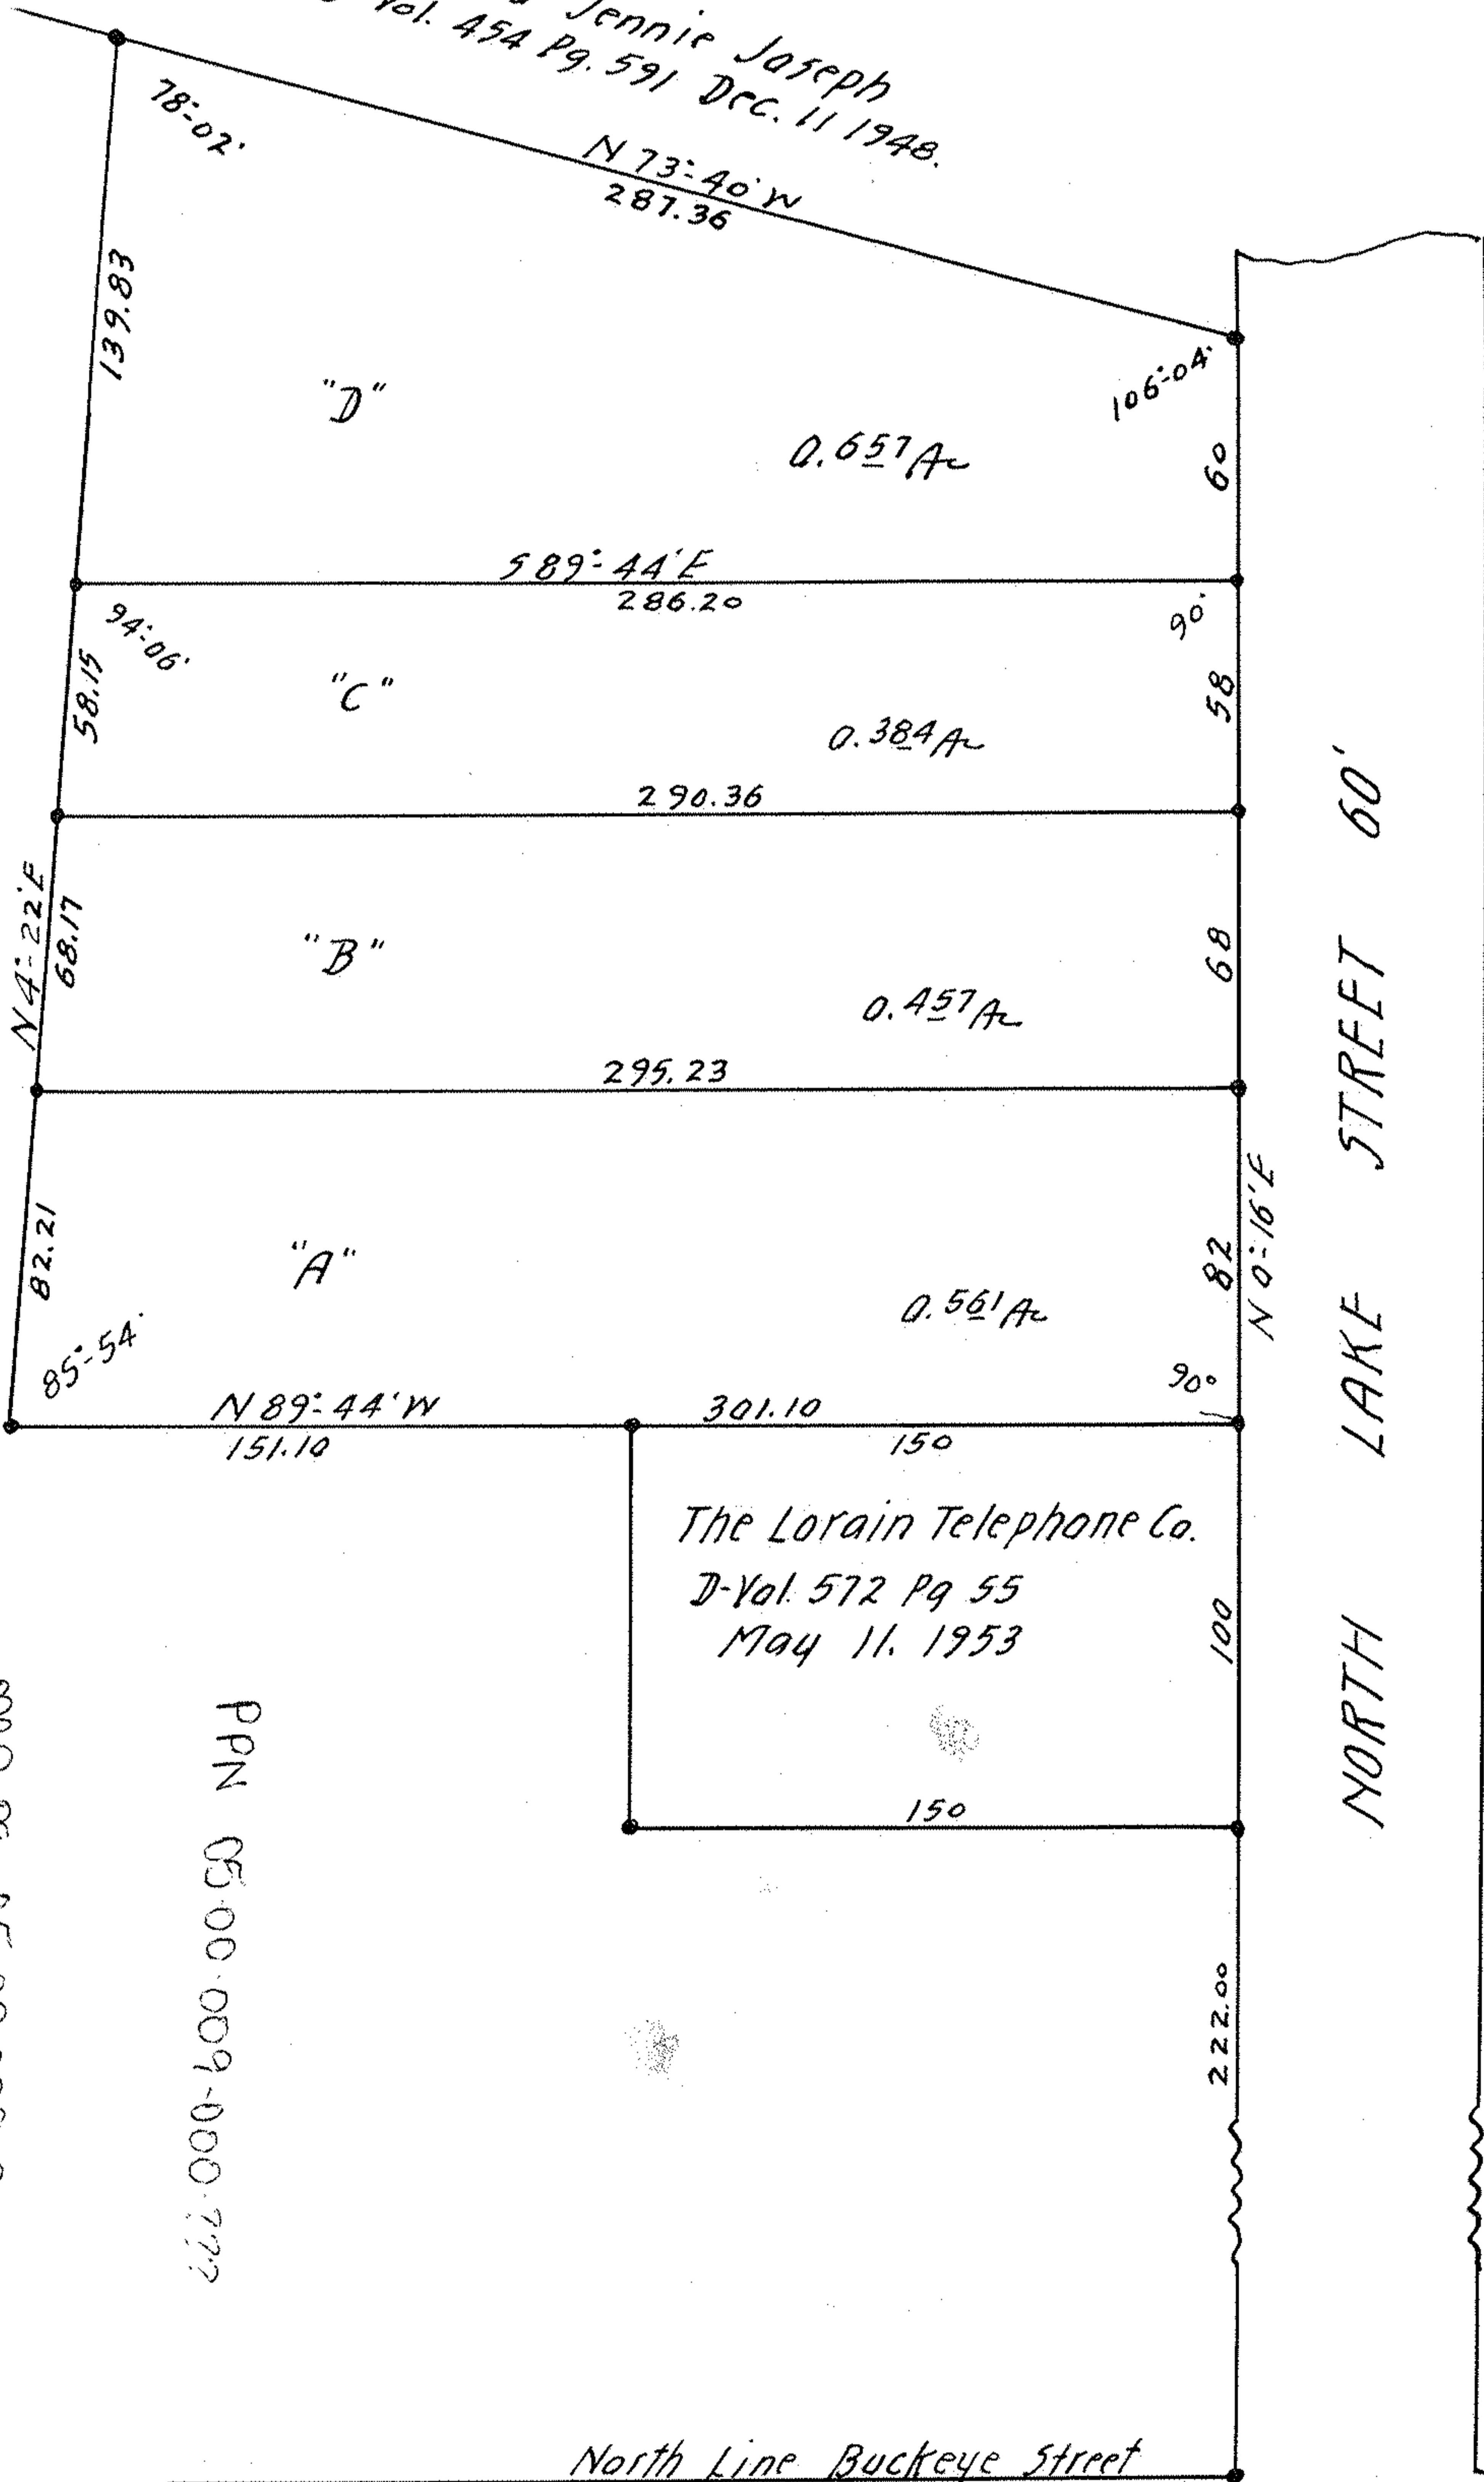

NORTH LAKE STREET 60'

The Lorain Telephone Co.  
 D-Val. 572 Pg 55  
 May 11, 1953

MAP PG 05 00 009-B

PPN 05 00 009-000 777

44418

North Line Buckeye Street