


Nellie P. Bowman
 D-Val. 277-Pg 285 March 4, 1936.

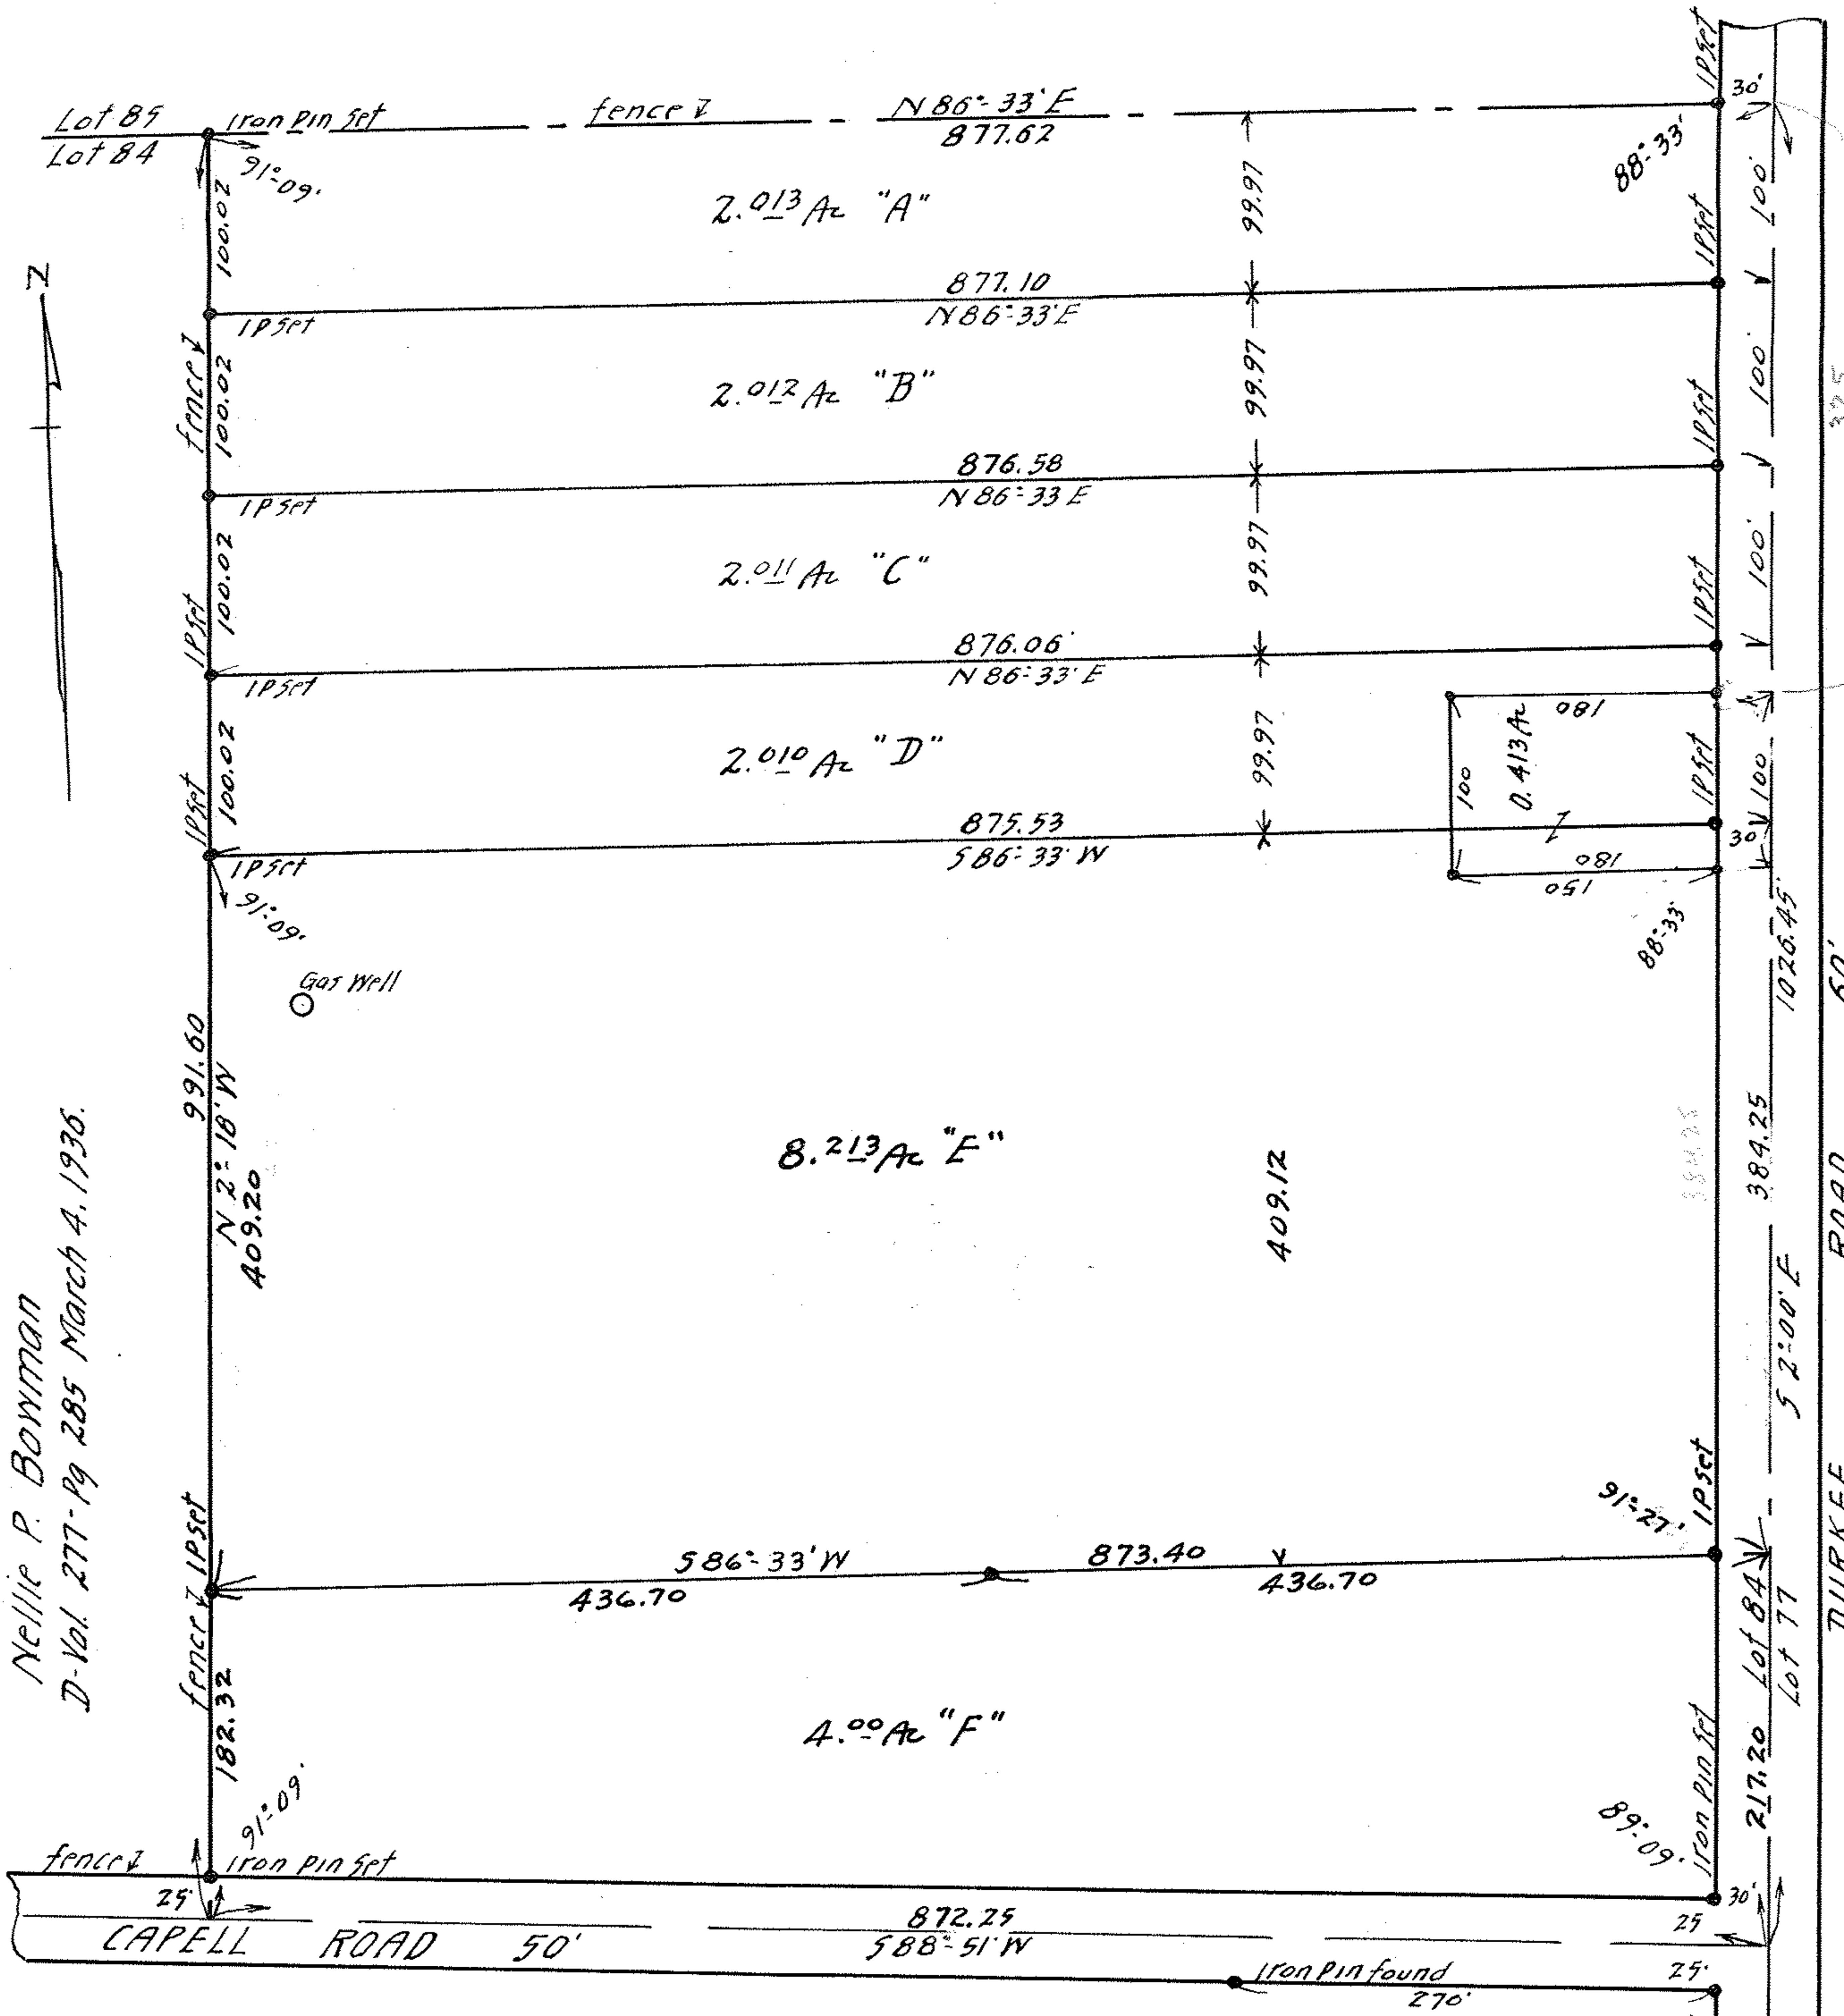

17-1062-3

Survey for
JULIA VISNICK
 D-Val 312-Pg 488 Aug. 13, 1941.
 Lot 84 Eaton Township.
 Lorain County Ohio.
 Scale 1"=100' May 11, 1948
 J. W. Warden, Registered Surveyor.
 20.259 Ac Total Revised Sept. 8, 1948. Sept. 5, 1951.

17-1062-3