



SBH 21

13-1482

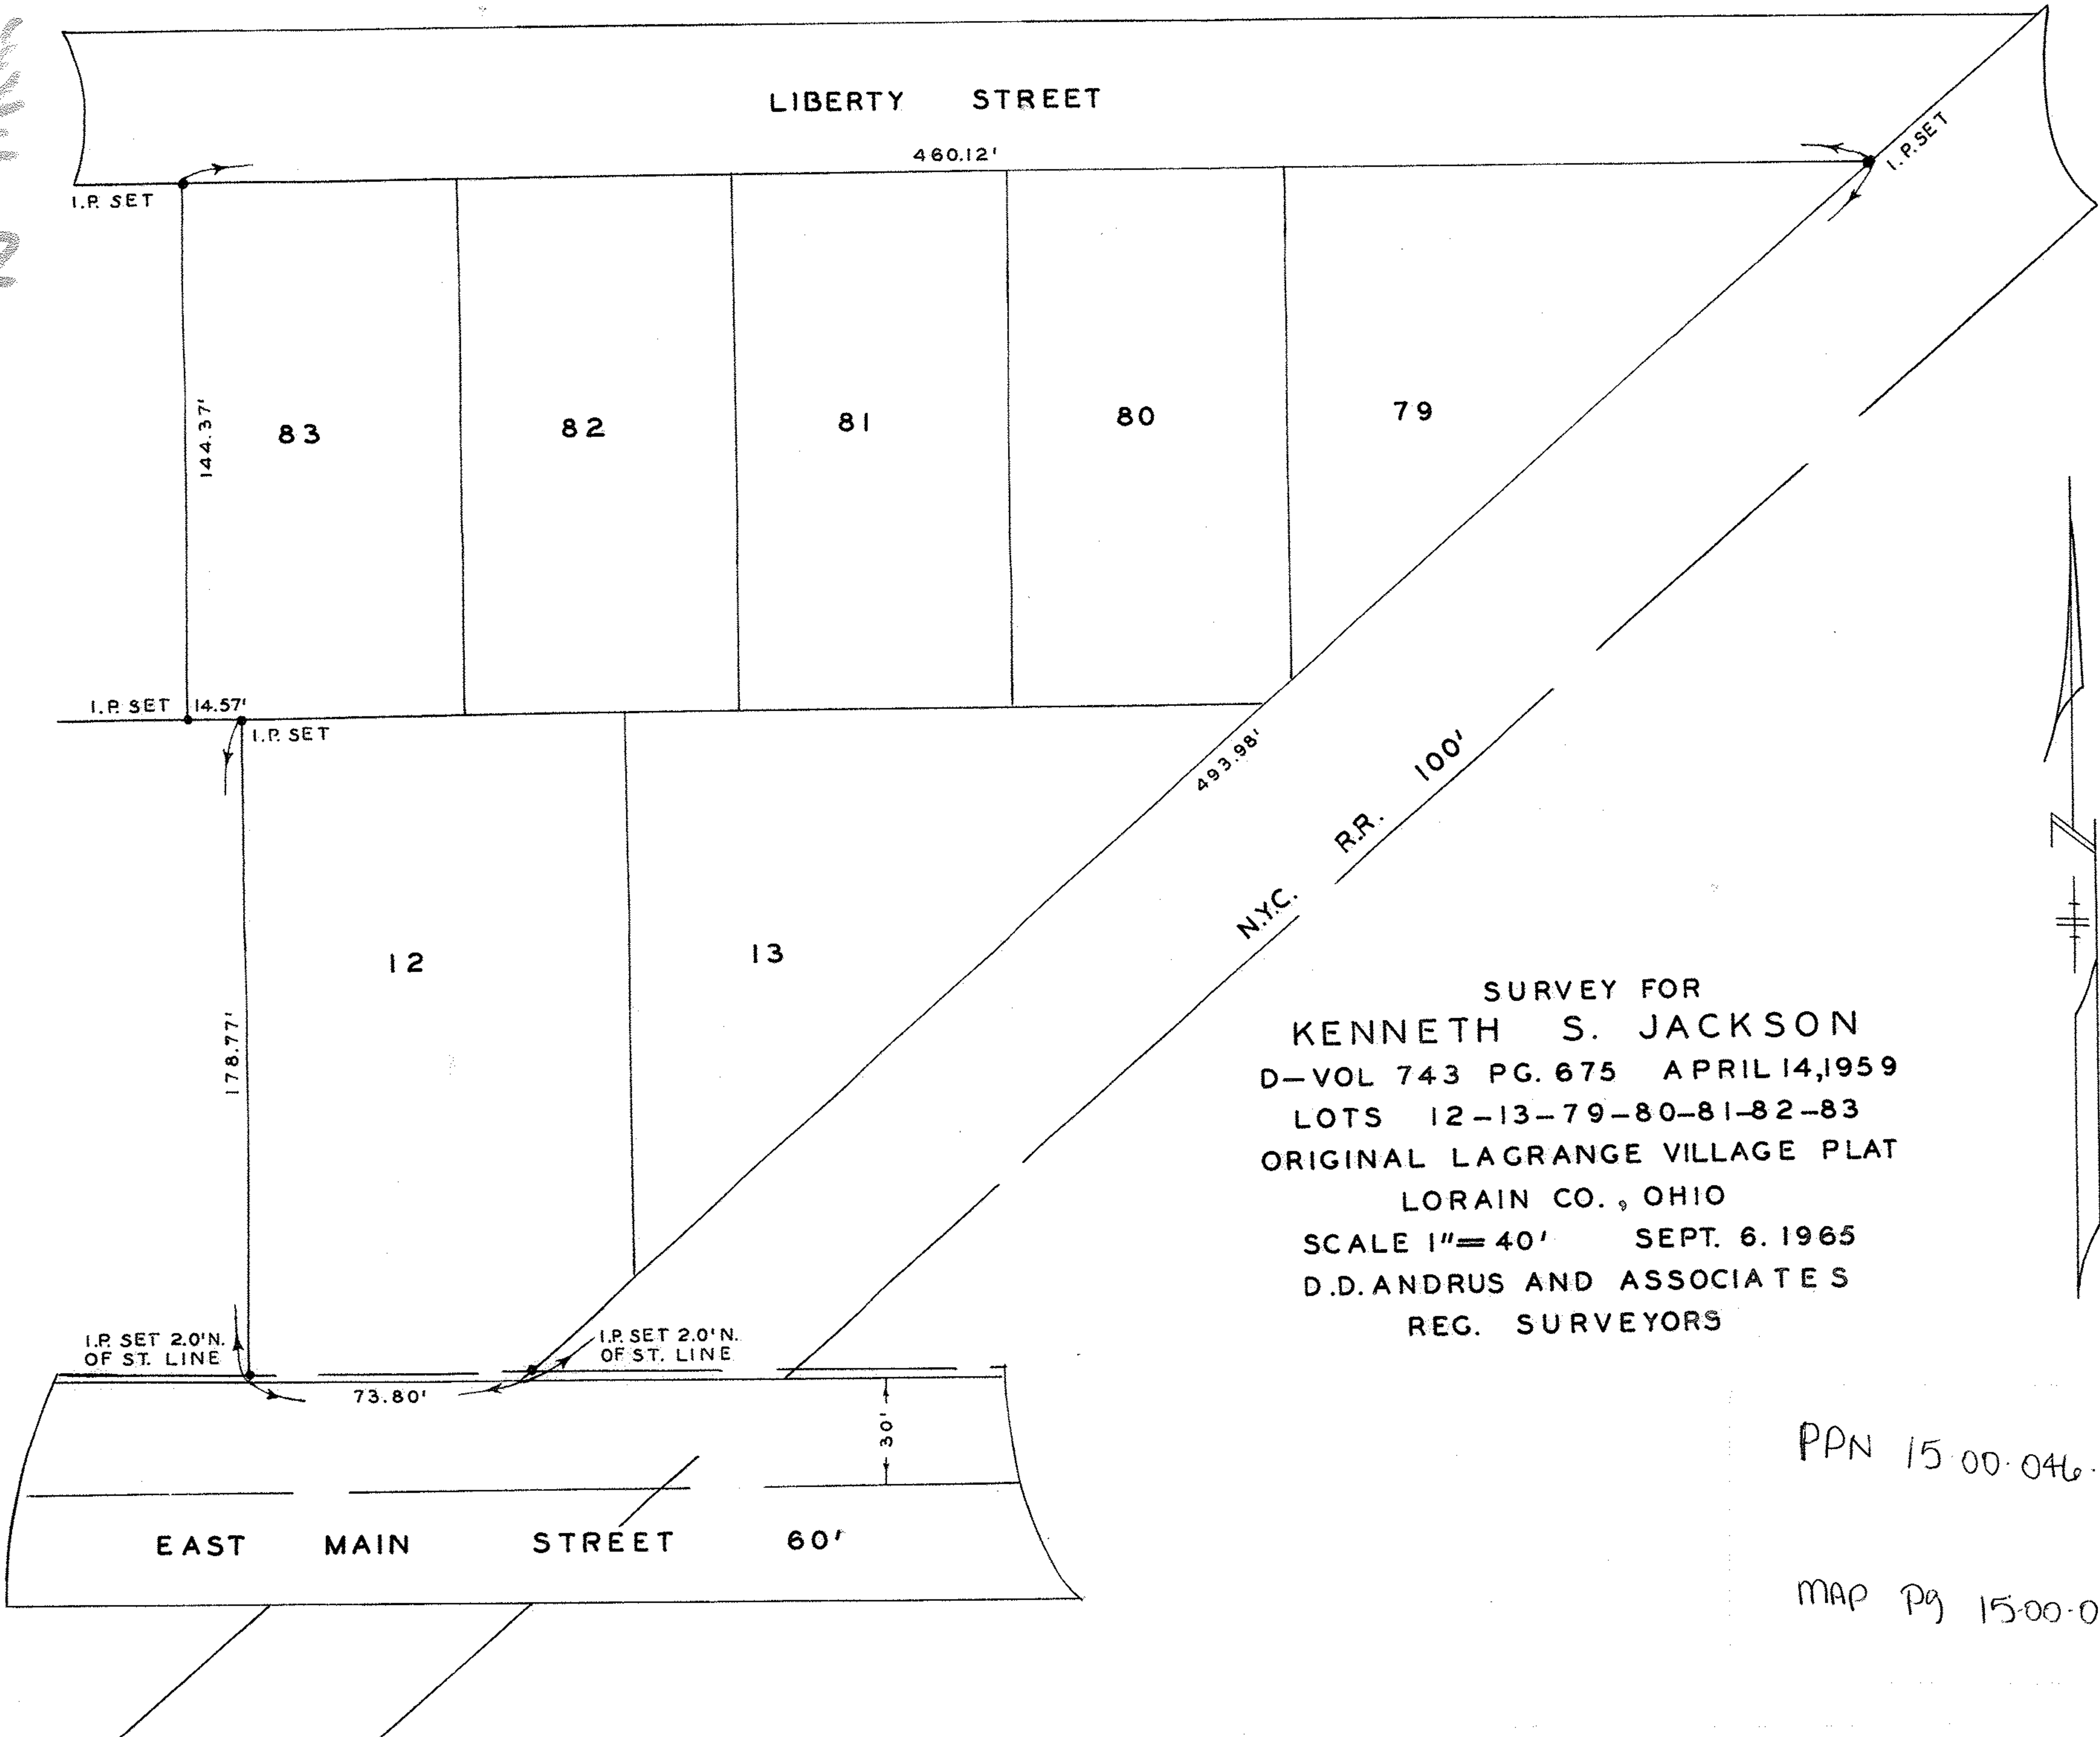

SURVEY FOR
 KENNETH S. JACKSON
 D-VOL 743 PG. 675 APRIL 14, 1959
 LOTS 12-13-79-80-81-82-83
 ORIGINAL LAGRANGE VILLAGE PLAT
 LORAIN CO., OHIO
 SCALE 1"=40' SEPT. 6, 1965
 D.D. ANDRUS AND ASSOCIATES
 REG. SURVEYORS

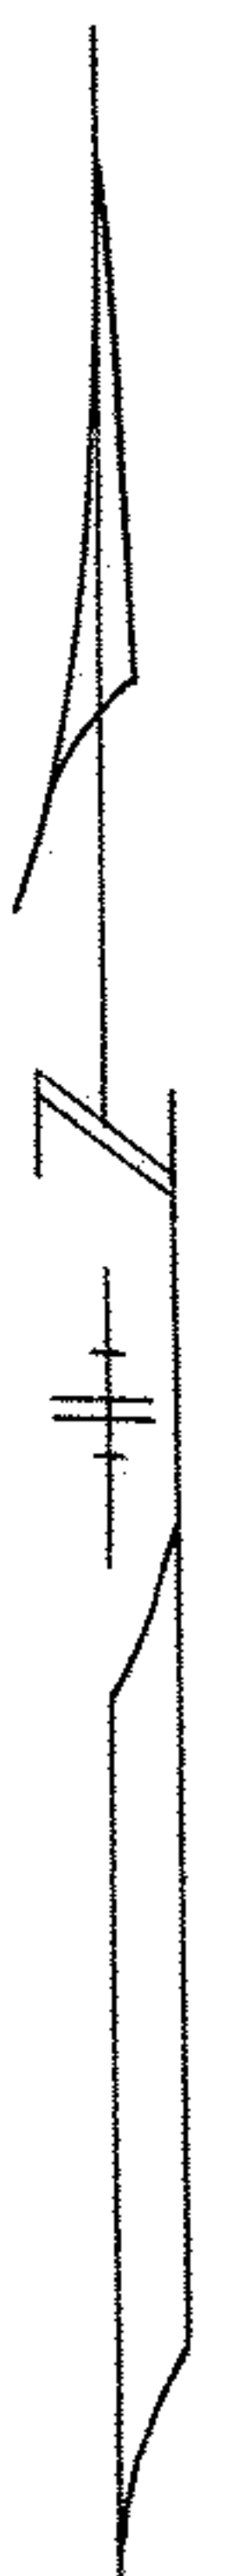

PPN 15-00-046-105-???

MAP Pg 15-00-046-A

44423