


SURVEY FOR CHAS. TATTERSALL  
 IN  
 Lot 123 west of Black River Elyria Lorain Co. Ohio  
 Scale 1 inch = 40 feet.  
 February 14, 1907

200702

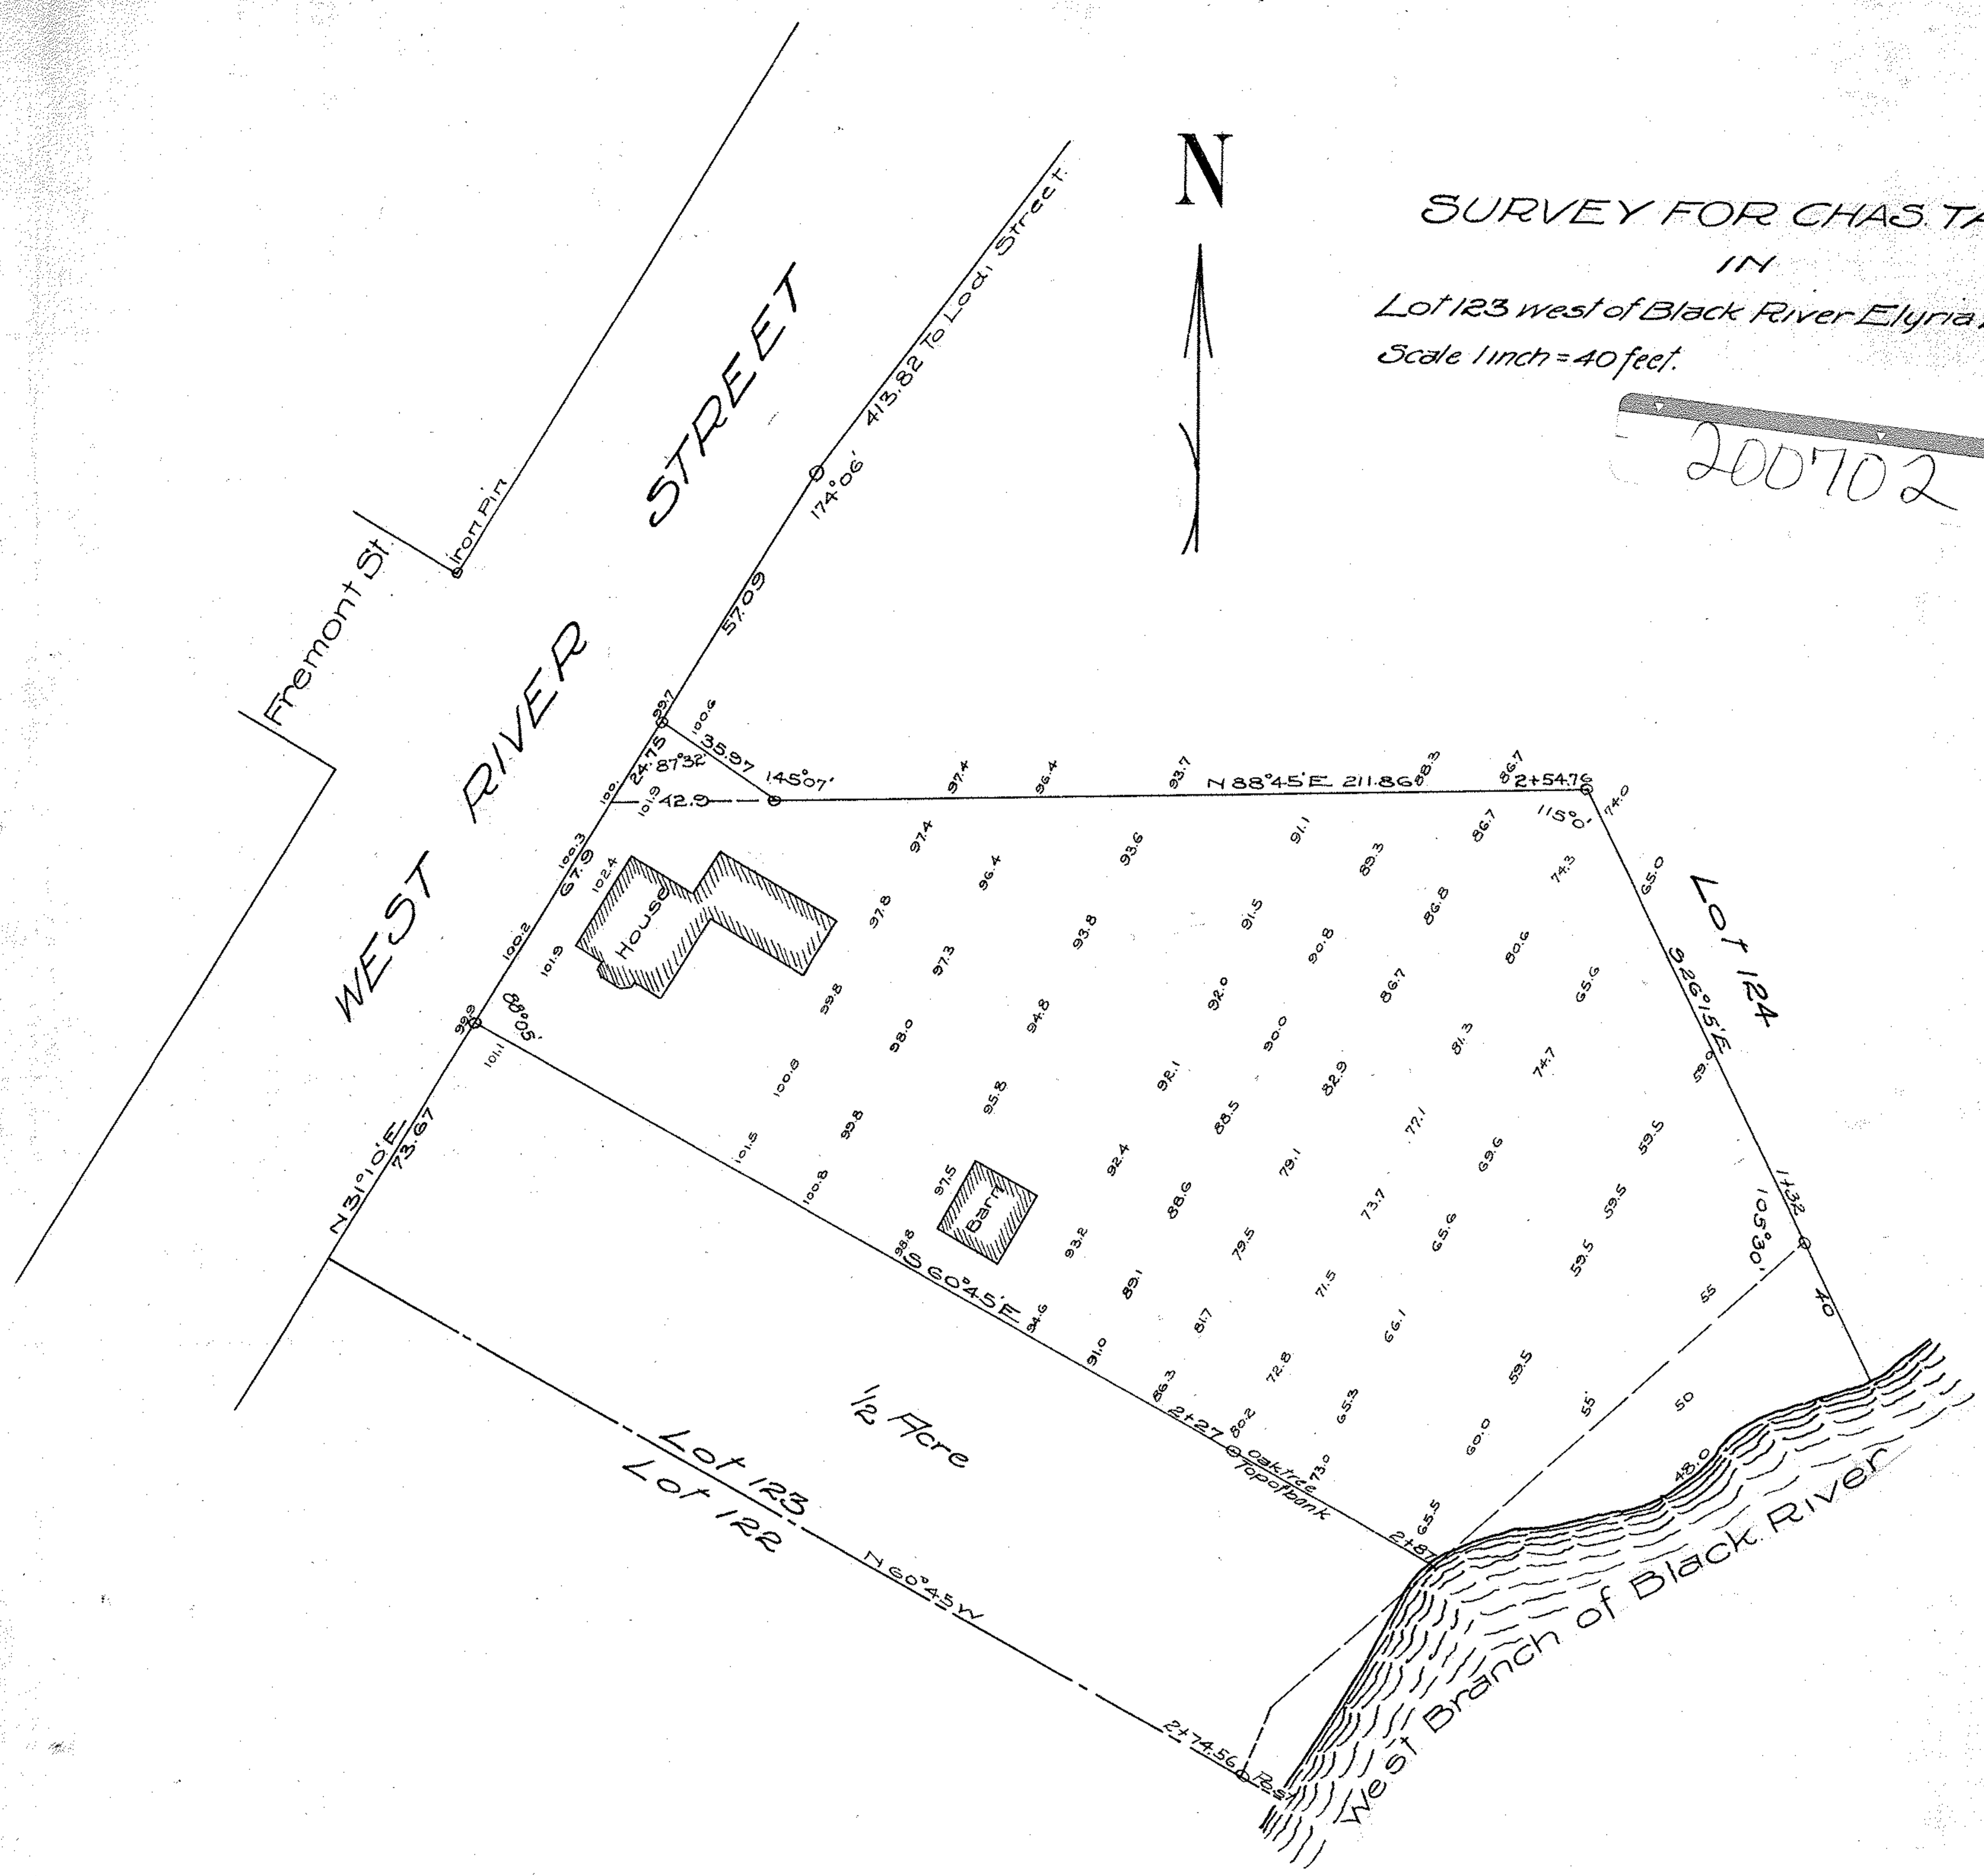

PPN 06 24-123-000-???

MAP PG 6-100 4448

507-5