


Centerline Union St. 727.04'

Survey for
 Oberlin College.
 Original Twp., Lot 75, Russia Twp.,
 Sub Lots 102-103- & Out Lots 1-51-52,
 Original Village Plat of Oberlin,
 Map Vol-5- Pg 30,
 Oberlin, Lorain Co., Ohio.
 July 1, 1931. Scale 1 inch = 50 feet.
 Warden and Laundon, Civil Engineers.

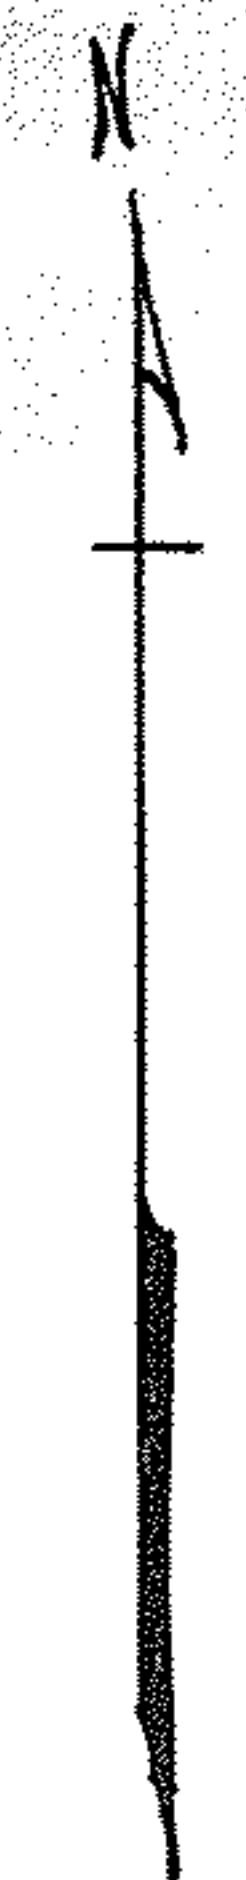

anna Metcalf
Irving W. Metcalf 1928

Lot 50
Lot 51

Irving W. Metcalf

I.P. found 1.95 East I.P. Set 165.0' I.P. Set 332.66 cal. & meas. I.P. Set 167.66 I.P. Set 332.66 cal.

Line Established by C.H. Snow, Surveyor for I.W. Metcalf, June 26, 1911.

ST. 60

332.66 cal.

Oberlin College

Edith H. Martin

Mary A. Morris

Oberlin College
 (Pfaff Lot)

Oberlin College

Village Out Lot 51
 Village Out Lot 52

Out Lot 51. 282.35 meas.

Sub Lot 102

Sub Lot 103.

Cong. Church

PPN 09-00-075 110-???

MAP pg 09-00-075 B 4445+

PROFESSOR

NORTH MAIN

633.0 meas.

99.0'

I.P. found 2.0 East of St. line

172.0

178.40

50.0'

18.29

13.32

49.50'

2190.126

47.3

330.0

47.3

187.68

I.P. Set in Concrete

I.P. Set 279.40 meas.

I.P. Set

I.P. Set in concrete

I.P. Set

I.P. Set in Concrete

60.12'

70.62'

I.P. Set

149.50'

49.5

99

330.0

90° 55'

ST. 66

332.15 cal.

99' I.P. Set in concrete

49.5

99

311.34 meas.

ST. 66

WEST LORAIN

I.P. found

89° 01'

90° 14' 30"
 170.95 meas.

I.P. found

600632