


PPN 07-00-028-102-???

-PK

MAP pg 07-00-028-A

44474

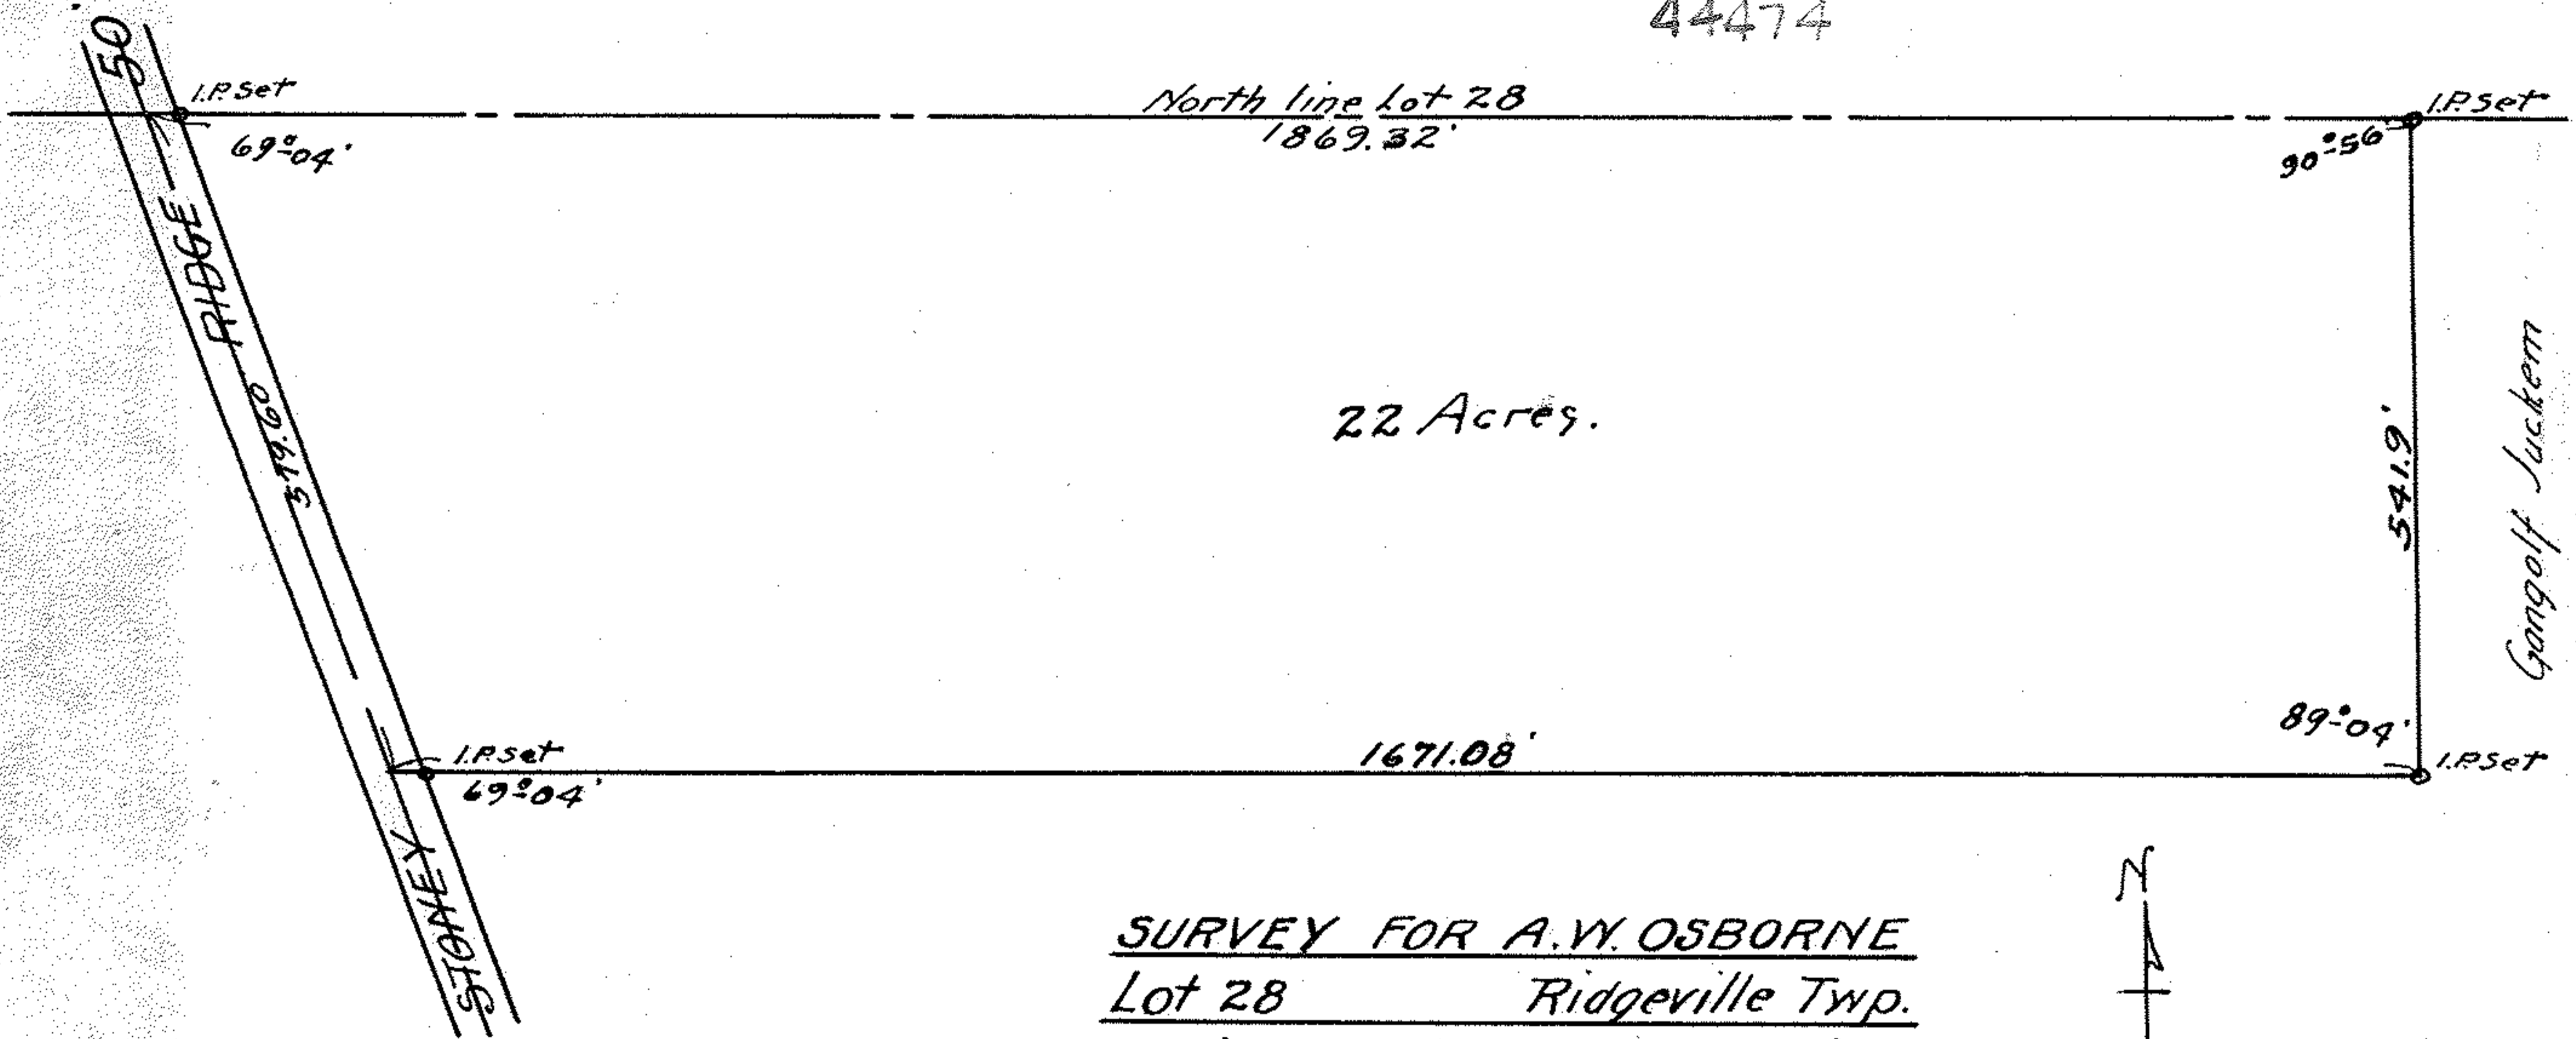

SURVEY FOR A.V. OSBORNE
Lot 28 Ridgeville Twp.
Lorain County Ohio
Scale 1 in. = 200ft. March 31-1920
J. M. Warden
 Surveyors

