



PPN 04-00-017-103 ???

MAP PG 04-00-017-G 4475

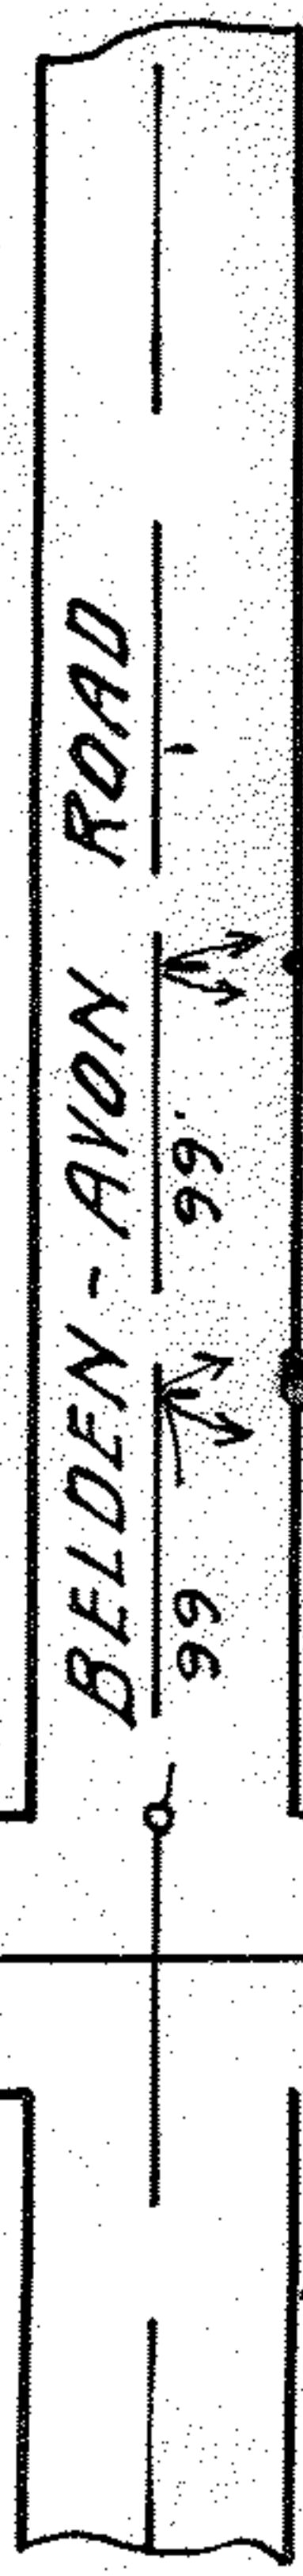

Philomiena N Osterman.

Martin Drotleff
D-Vol-141-Pg. 212- Dec. 9, 1916

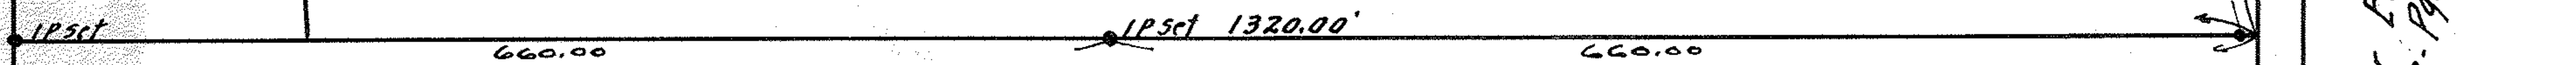


3° Az




Mary Conrad.
D-Vol 176 Pg 69 April 9 1921.

89°-33'

NYC & ST. L. R.R.

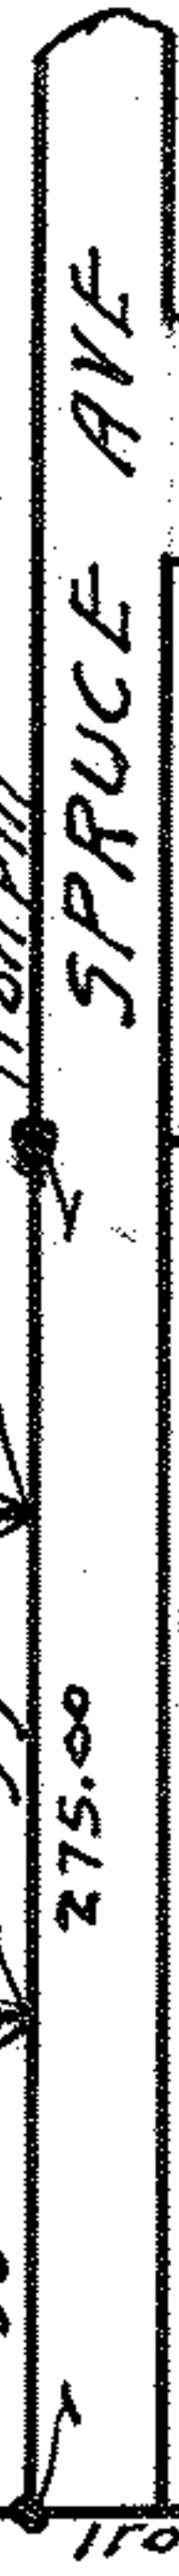

Avon Center Estates No 2
Map. Vol 12-Pg. 19

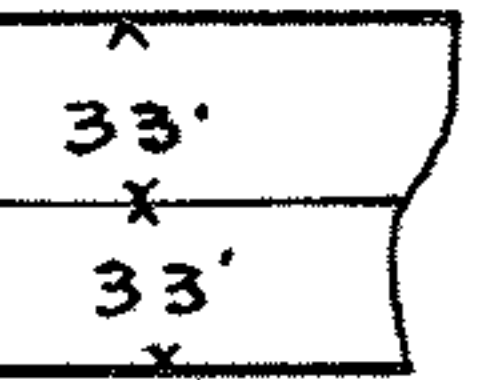

Survey For
OWEN McKENNA
Section 17 Avon Lake Village
Lorain County O.
Scale 1"=100' July 26, 1944.
J.W. Warden, Registered Surveyor.

2-8-41