

Survey of Grafton Village Town Hall Site
 Parts of Lots 67 & 68 Rawsonville Plat
 Grafton Village Lorain Co. Ohio.


Scale 1" = 20'

May 31, 1934

J.W. Saunders

Surveyor

Certificate applied for 1-1-34

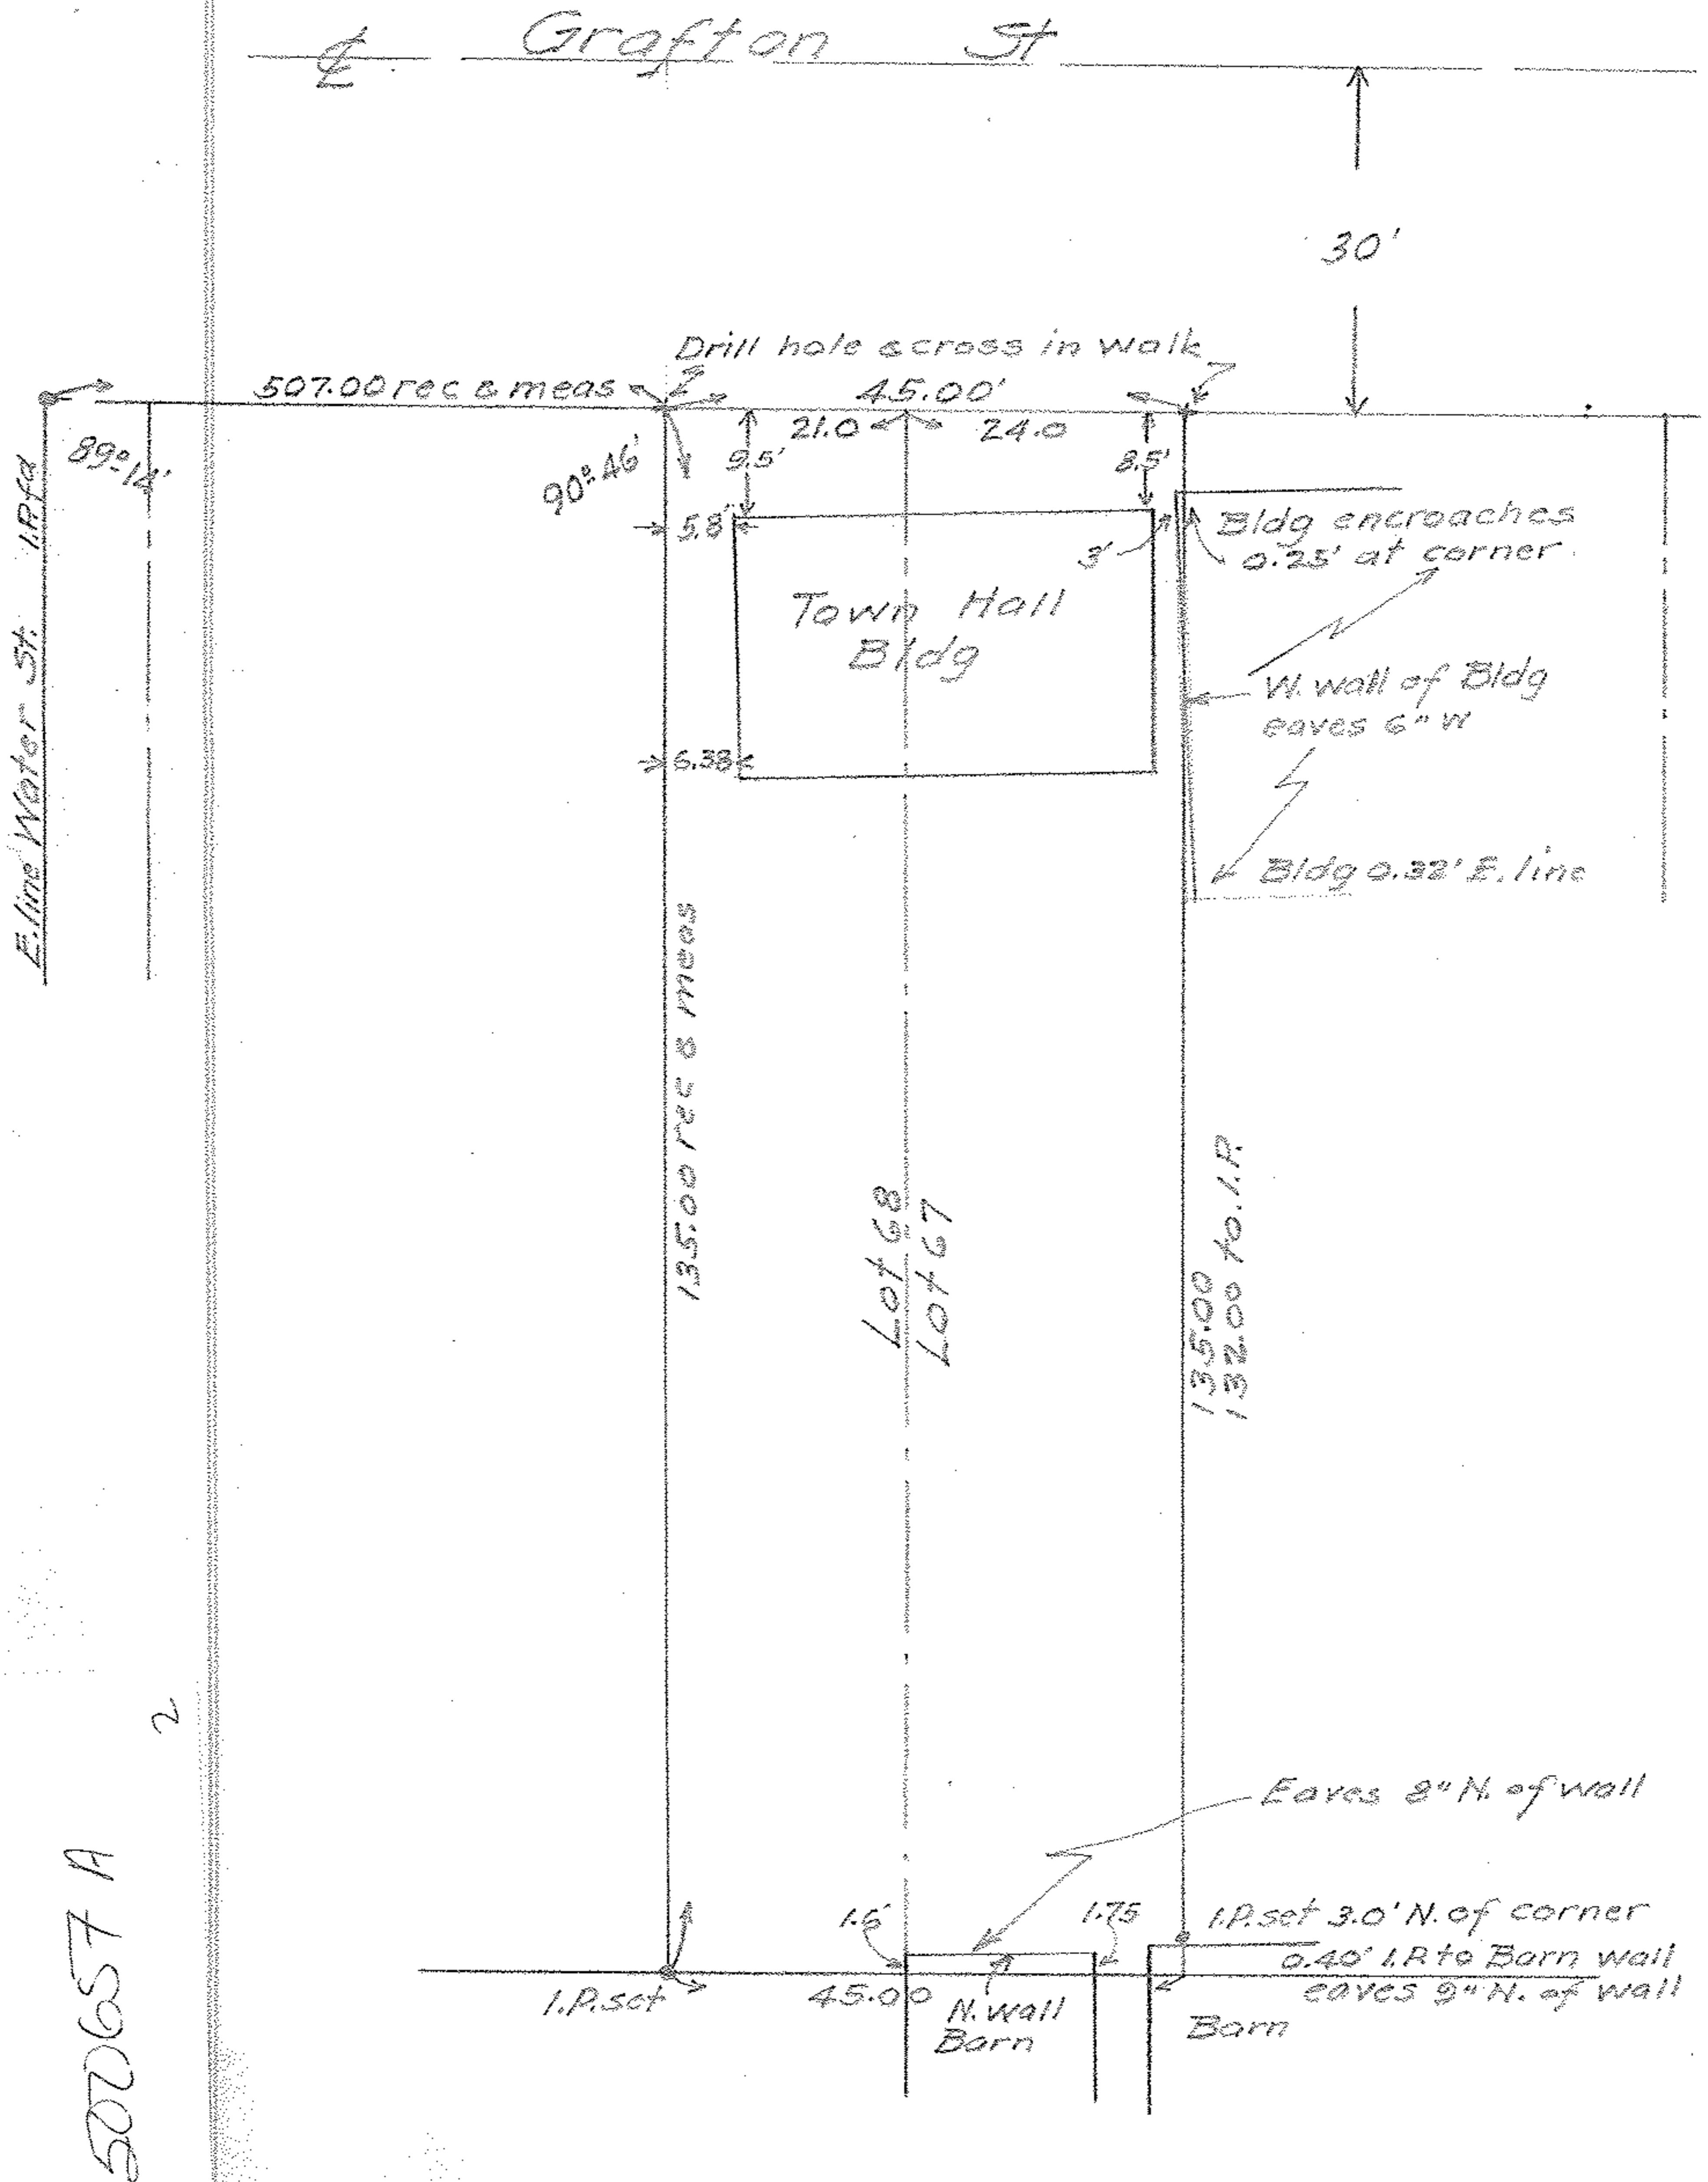

E. line Water St 1.R. to

89° 14'

507.00' rec & meas

Drill hole across in walk

45.00'

30'

90° 46'

21.0

24.0

5.8'

Town Hall Bldg

Bldg encroaches 0.25' at corner

W. wall of Bldg eaves 6" W

6.38'

Bldg 0.32' E. line

135.00' rec & meas

Lot 68

Lot 67

135.00' to 1.R.
132.00' to 1.R.

Eaves 9" N. of wall

1.R. set

45.00'

N. wall Barn

Barn

1.R. set 3.0' N. of corner

0.40' 1.R. to Barn wall eaves 9" N. of wall

507657 A

2