


9241-4

3

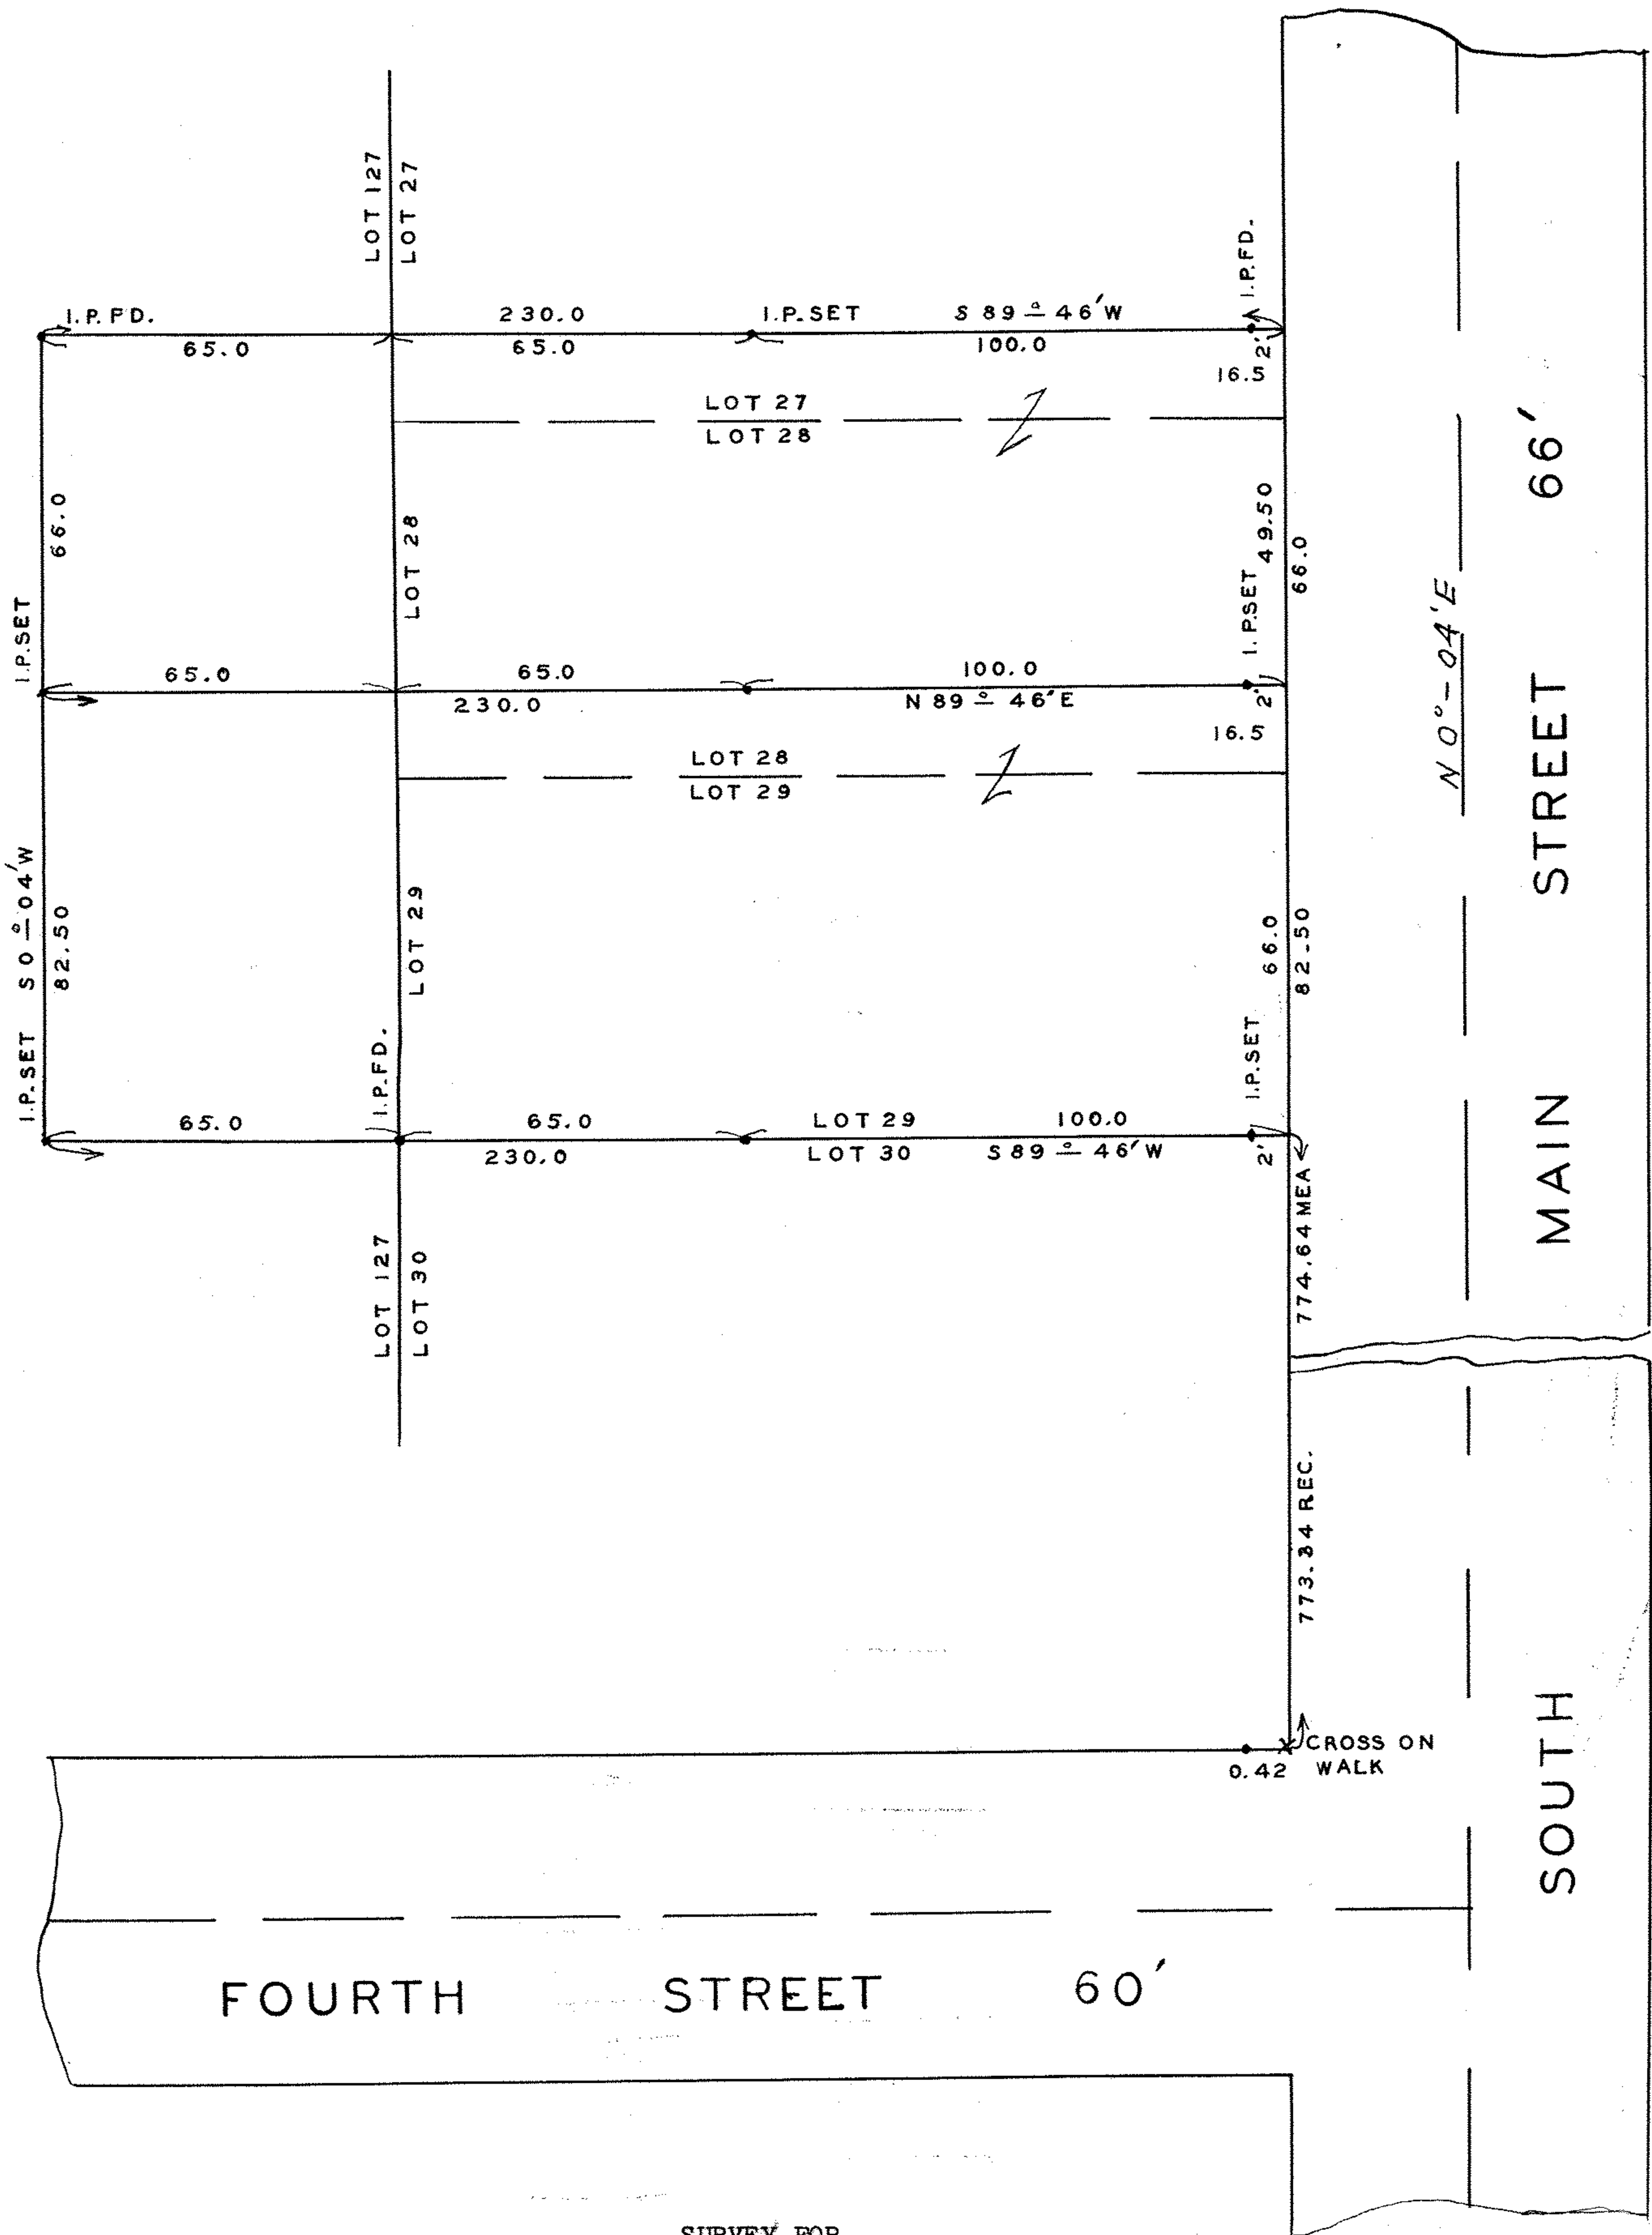

SURVEY FOR  
 WM. AND WILMA L. WEBER  
 PART OF SUB LOT 27 ALL OF SUB LOTS 28-29 BLK 1  
 ORIGINAL VILLAGE PLAT OF WELLINGTON  
 MAP VOL 1 PG 6  
 PART OF OUT LOT 127 HAMLIN AND TURLEY ADDN  
 MAP VOL 1 PG 25  
 WELLINGTON VILL. LORAIN COUNTY, OHIO  
 SCALE 1" = 30' FEB 6, 1964  
 J. W. WARDEN AND ASSOCIATES REG. SURVEYORS

PPN 18-00-027-111-???

MAP PG 18-00-027-B  
44484