


PPN 05-00-045-000-77?

MAP Pg 05-00-045-B

44508

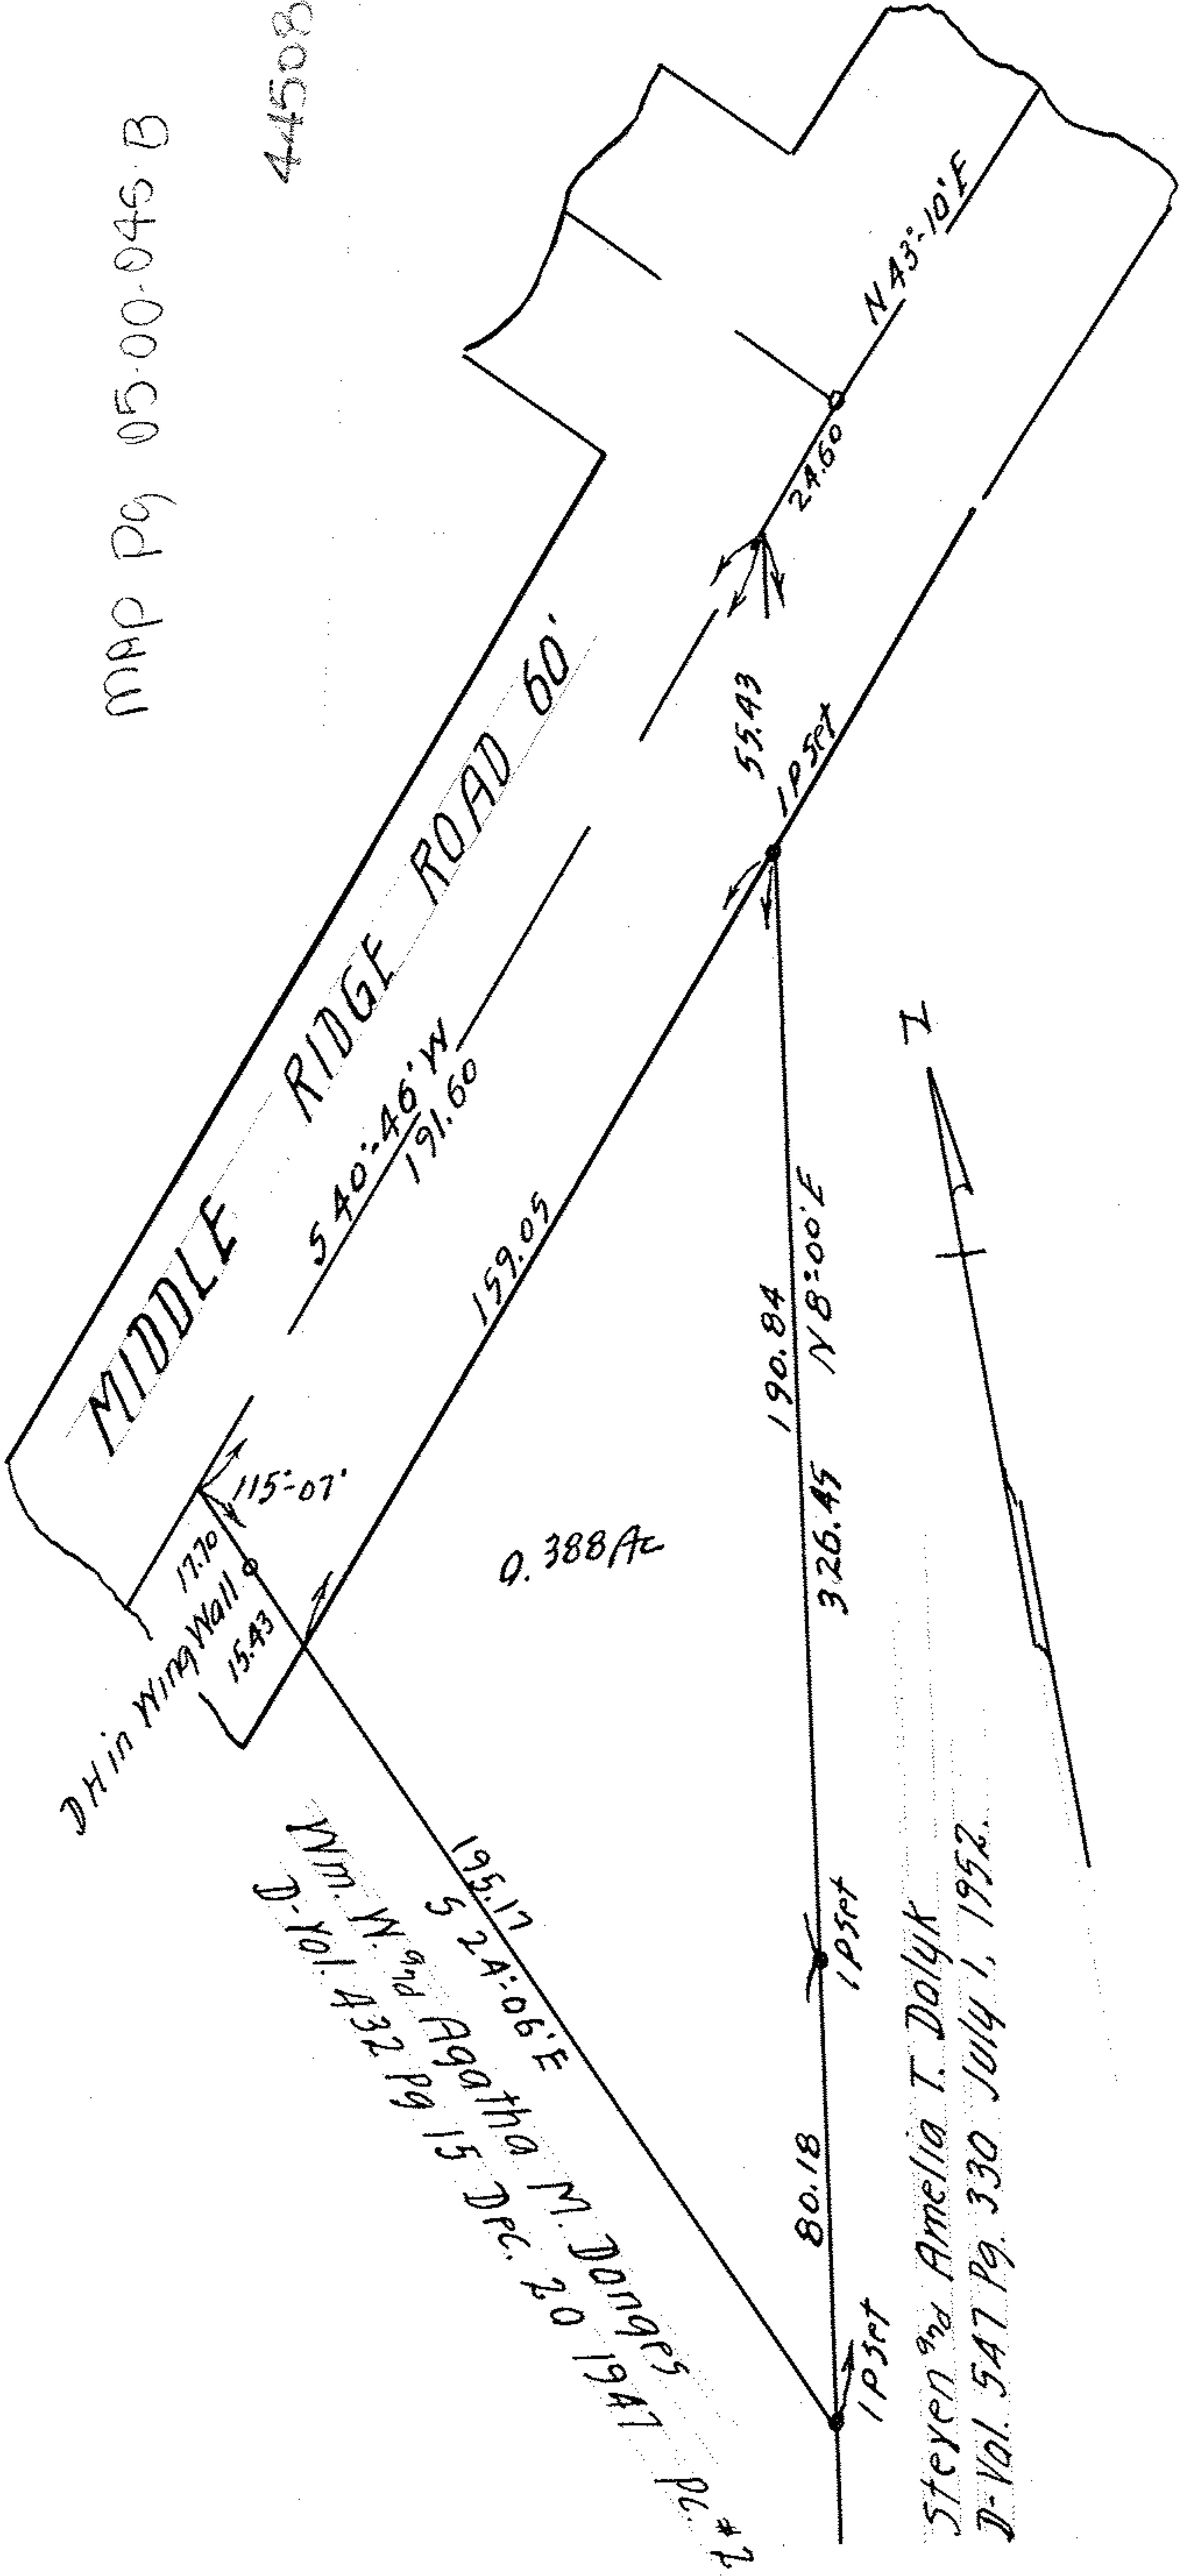

SURVEY FOR  
 STEVEN AND AMELIA T. DOLYK  
 PREMISES OF WM. W. AND AGATHA M. DONGES  
 LOT 45 AMHERST TOWNSHIP  
 LORAIN COUNTY, OHIO  
 SCALE 1" = 40' MAY 8, 1956  
 J. W. WARDEN AND ASSOCIATES REG. SURVEYORS

24-1254-1