


PPN 07-00-006-102-???

MAP PG 07-00-006-B  
44510

Survey for Gustav Hasenkamp.  
Original Lot 6. Ridgeville Tp. Lorain Co. Ohio.  
Feb'y, 11, 1920.  
Warden & Laundon. Civil. Engr's

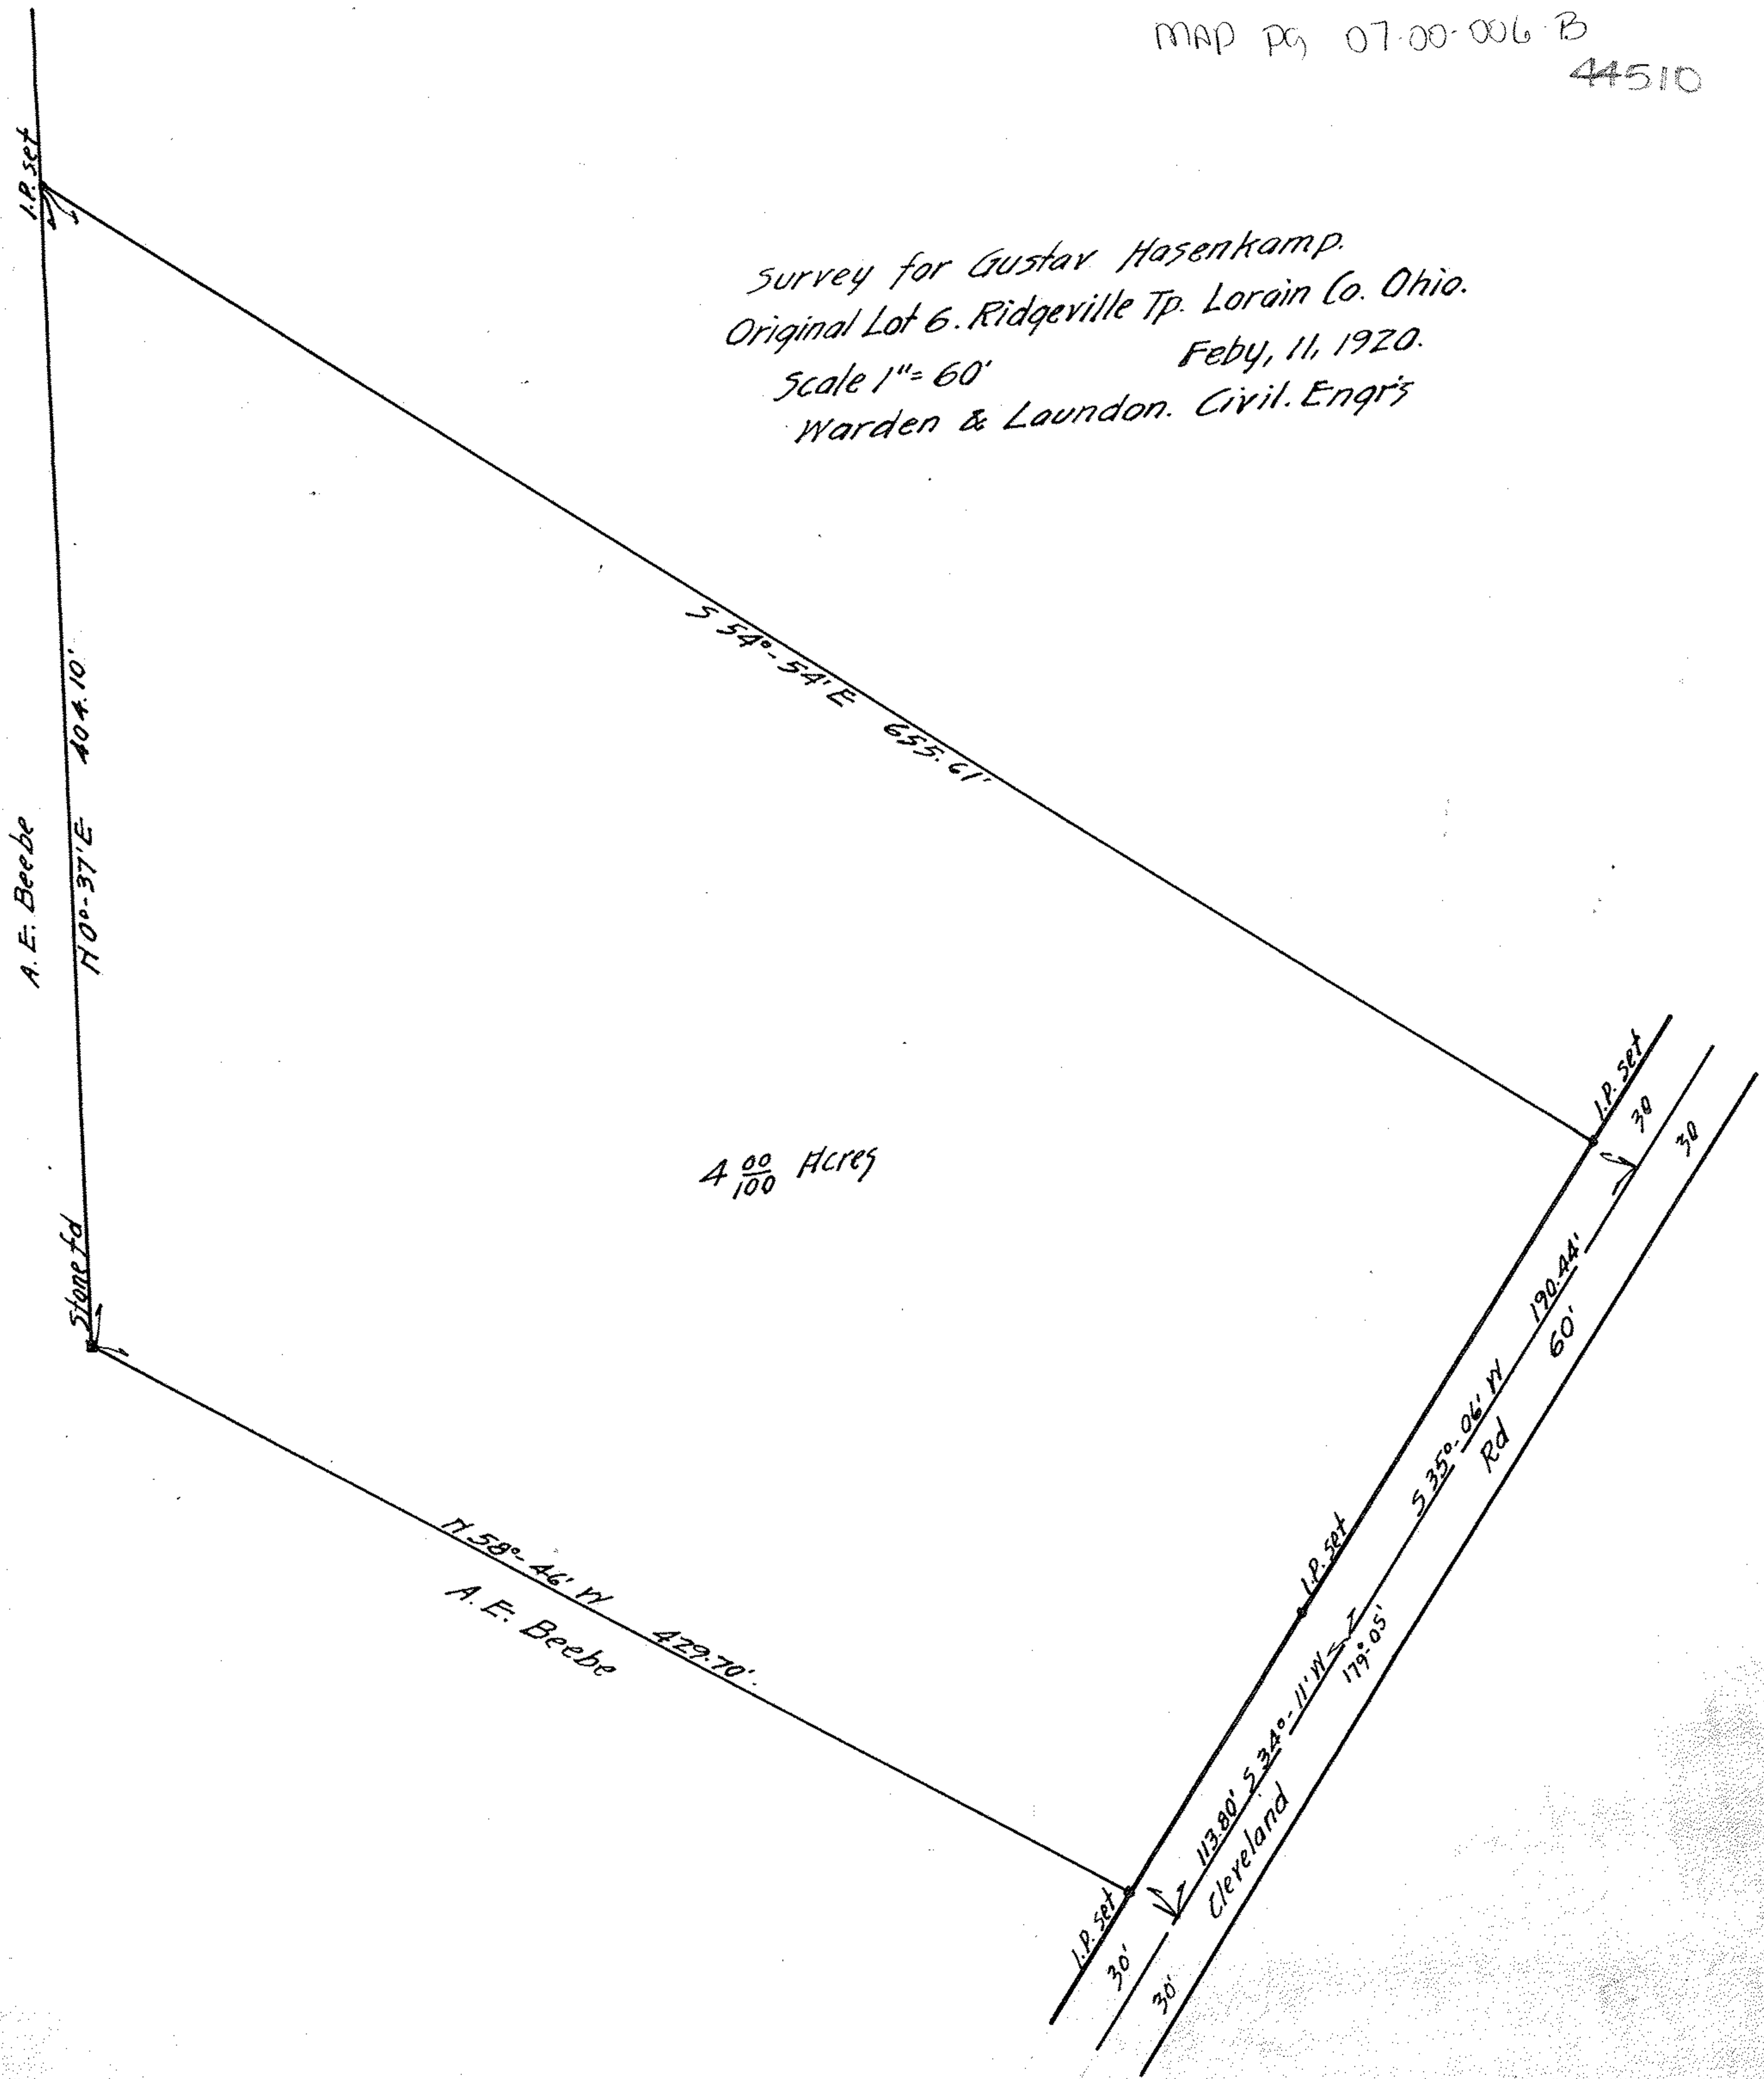

500164 B