


84-1824

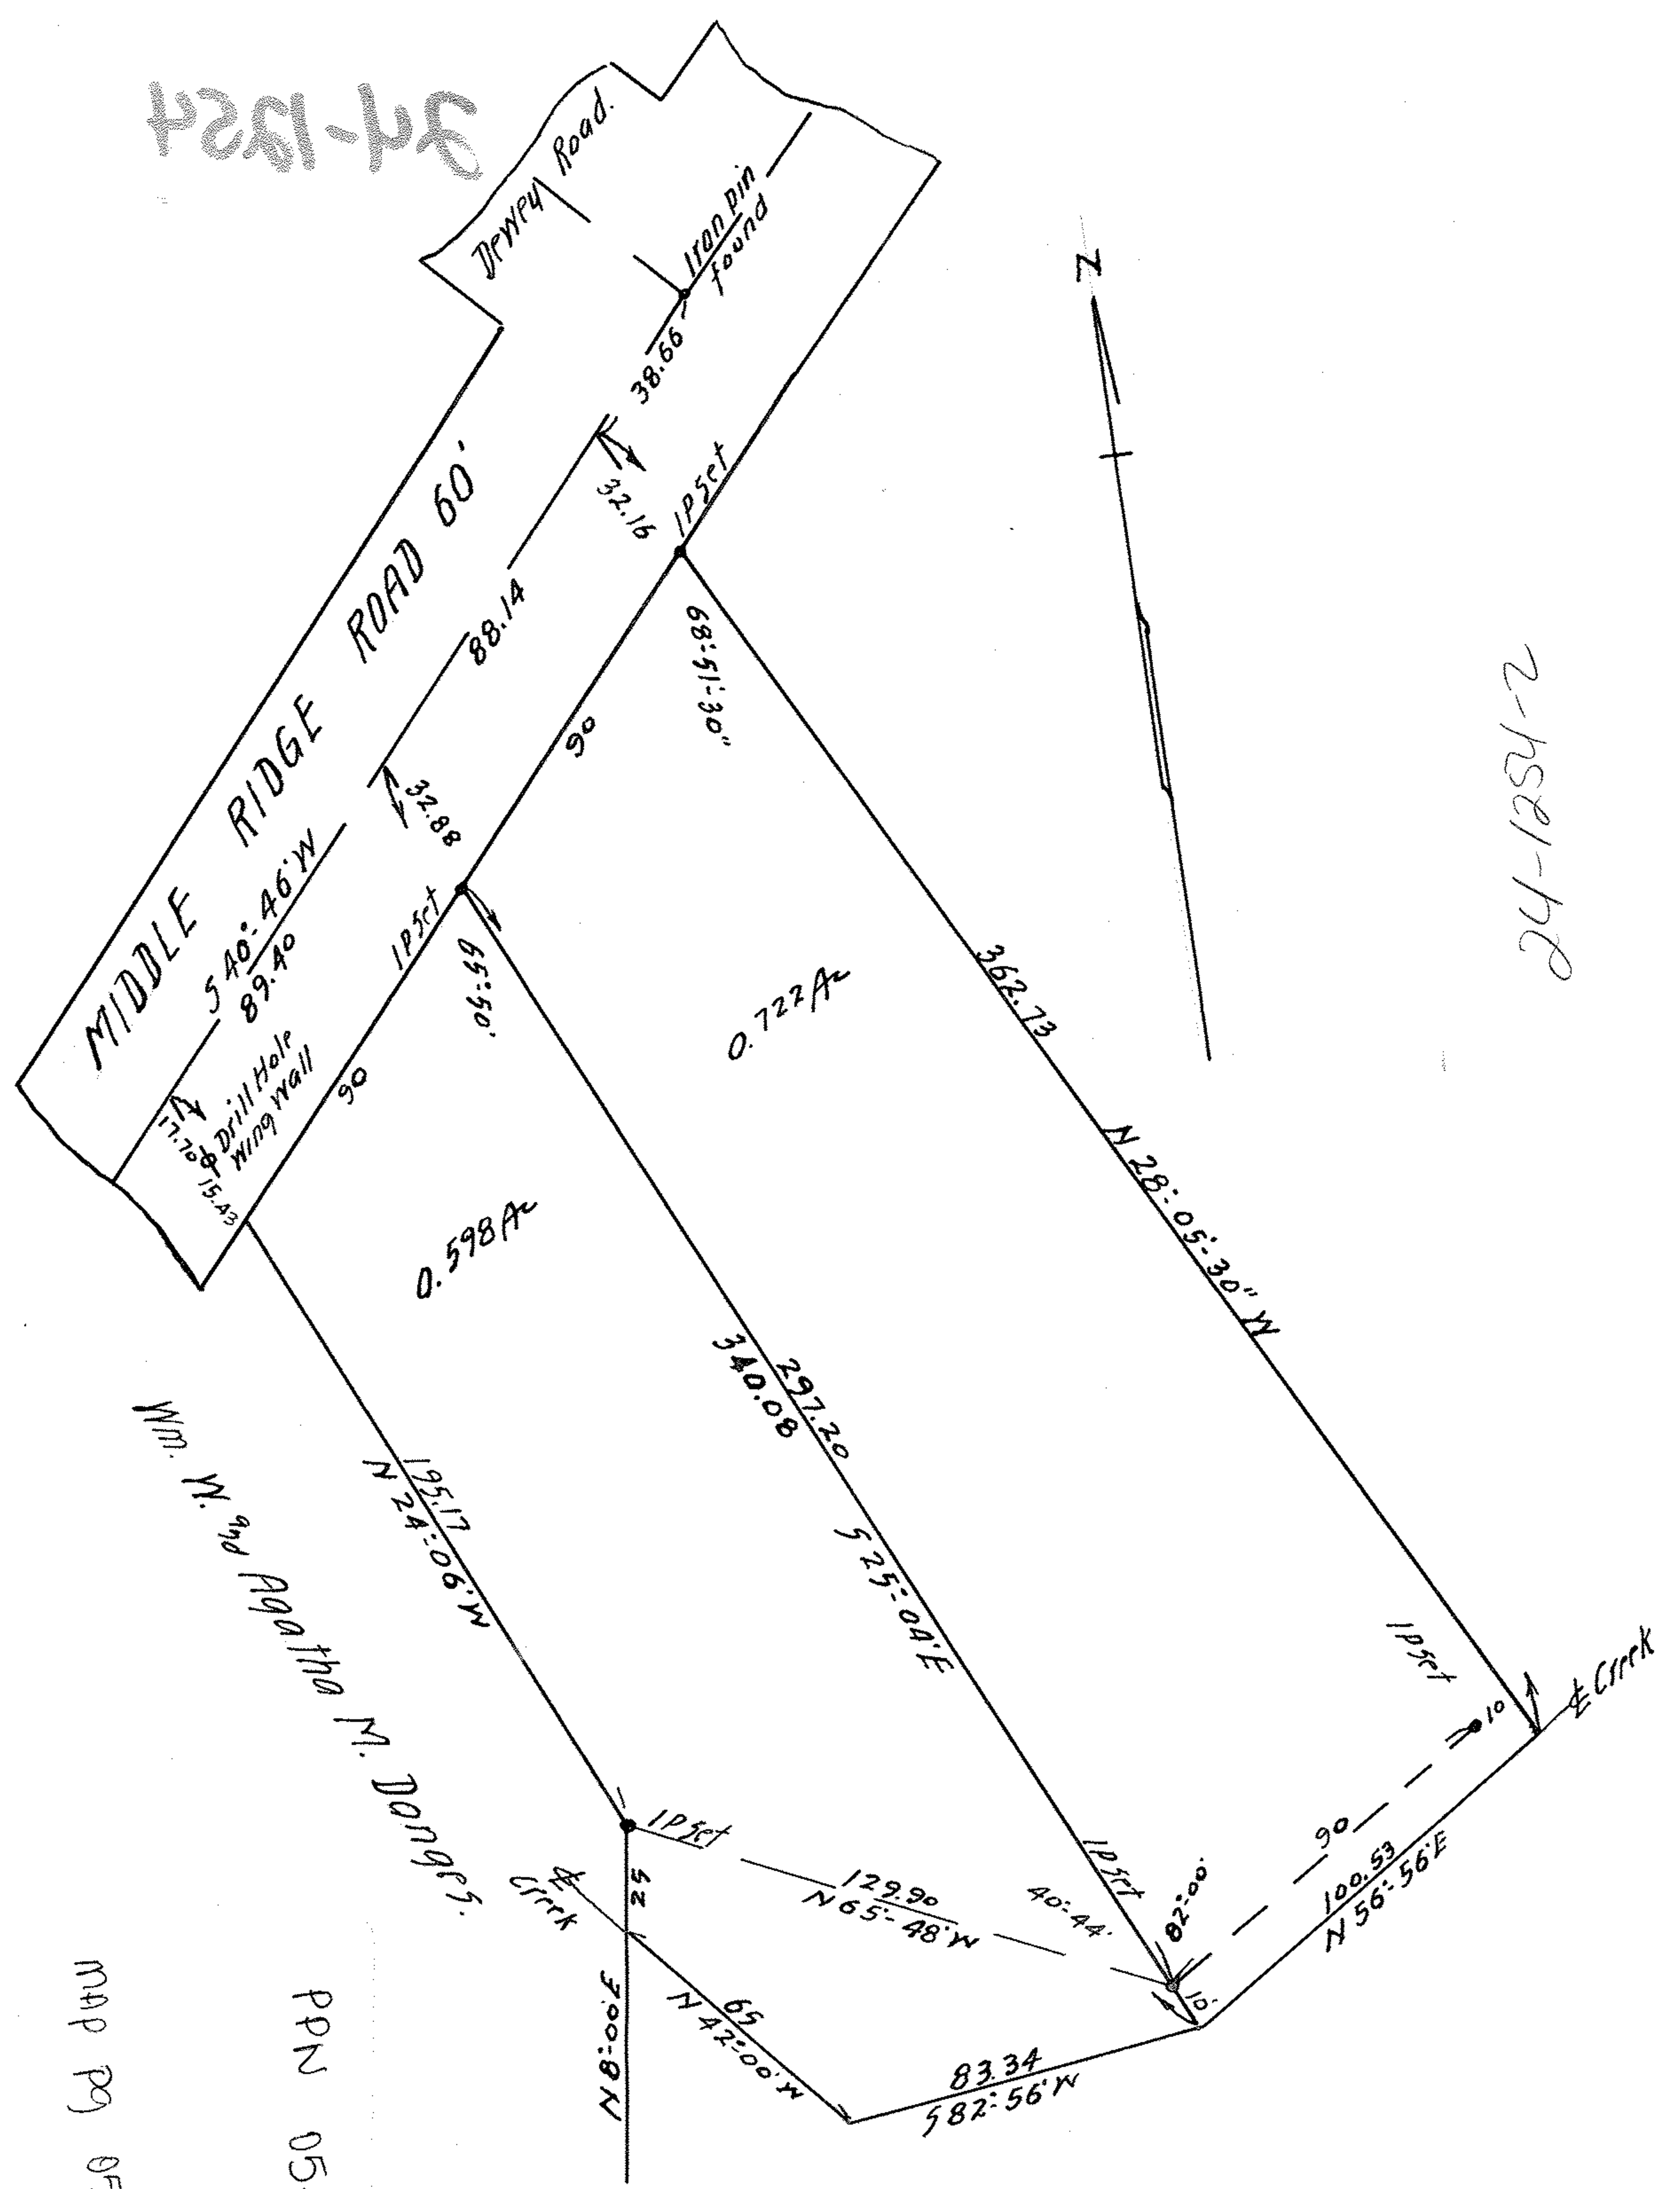

2-1824-12

N.M. W. and Pappano N. Dan 68.5.

MAP PG 05.00-045-B

PPN 05.00-045-000-777

44514

Survey for  
 STEVEN and AMELIA T. DOLYK  
 Lot 45 Amherst TWP.  
 Lorain County Ohio.  
 Scale 1" = 40' May 21, 1956.  
 J.W. Warden and Associates Reg. Surveyors.