


29-11475

29-11475

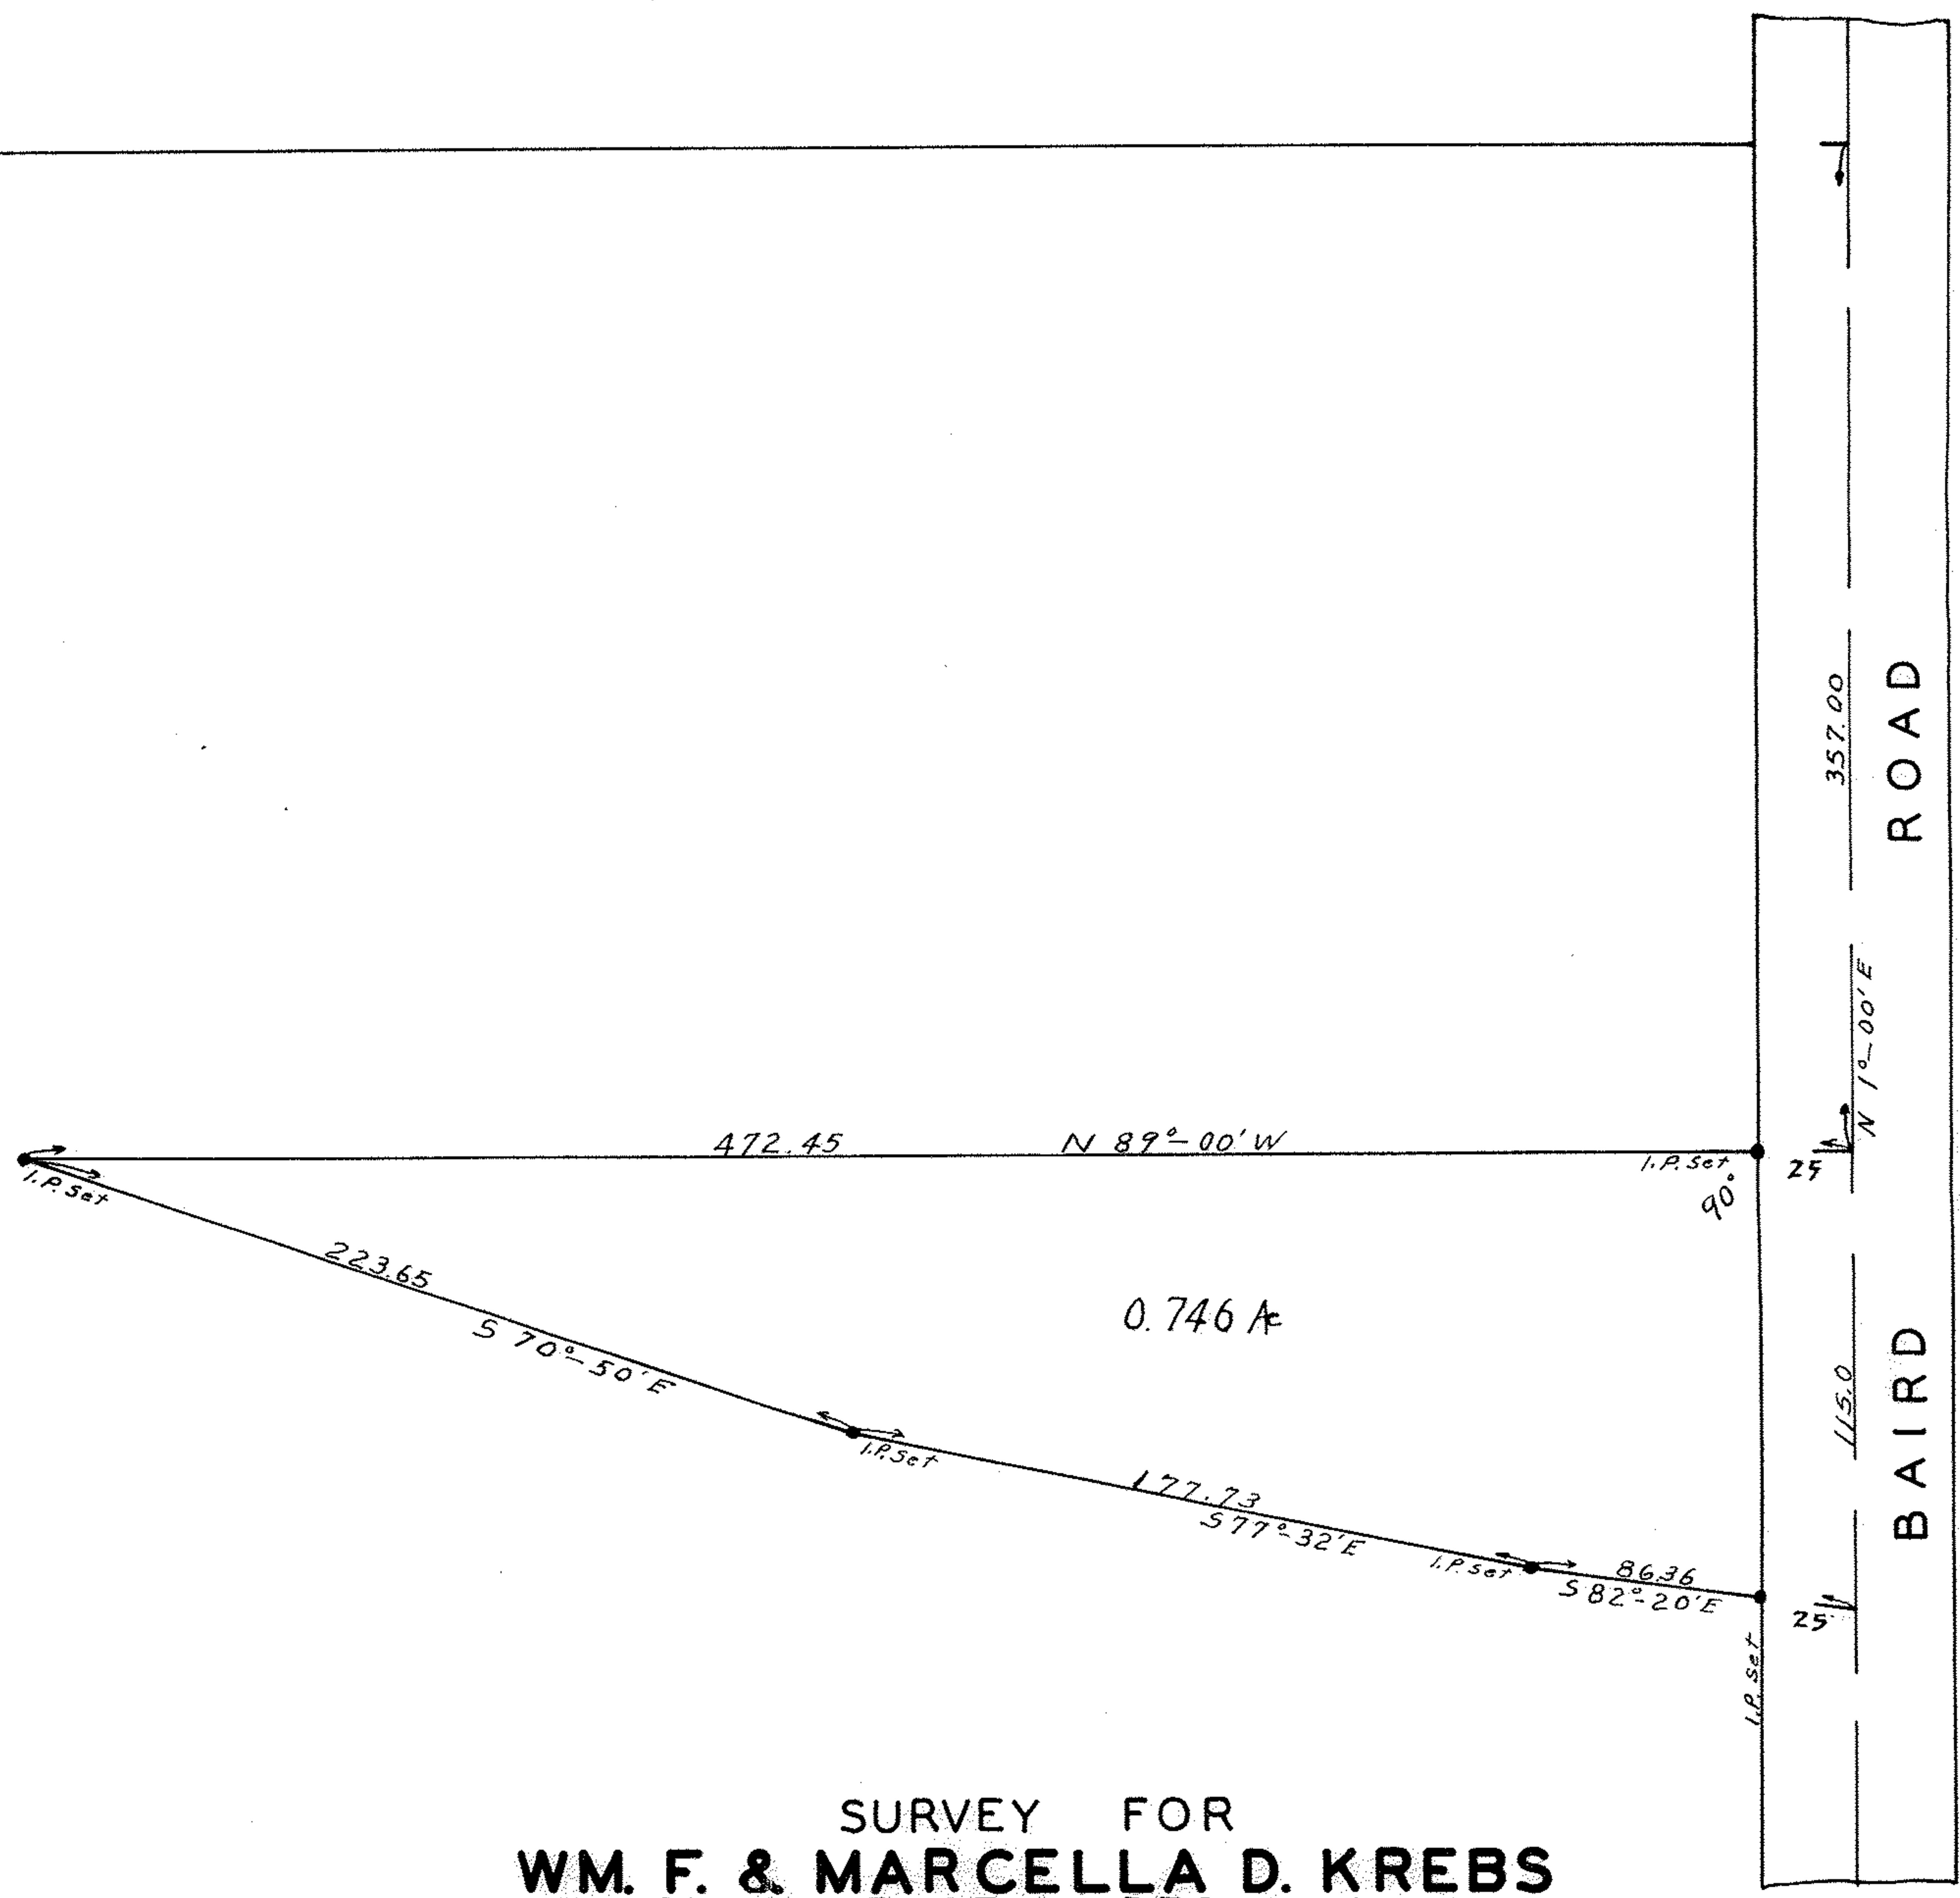

SURVEY FOR  
**WM. F. & MARCELLA D. KREBS**  
 D-VOL. 350 PAGE 86 DEC. 2, 1944  
 TRACT 14 LOT 8 HENRIETTA TWP.  
 LORAIN COUNTY, OHIO  
 SCALE 1" = 50' SEPT. 30, 1952  
 J. W. WARDEN AND ASSOCIATES REG. SURVEYOR'S

PPN 08-14-008-000-007  
 MAP PG 8-A  
 44554

