

Lake Breeze Allotment
Map. Vol-10- Pg. 21

South North Line Lot 30 Ave 30'

4.485 Acres

N.Y.C. & ST. L. R.R. 1.962 Ac
Sheffield Lake Village
D. Vol-49 Pg-251 July 25 1881
Sheffield Village

7.295 Acres

7.315 Acres

John Prohaszka
323-472 Nov 2 1942

Lloyd E + Virginia R Rush
337-423 10/12


April 29 1944

Max C. R. + Ida B. Schmidt
341-254 April 29 44

Survey for
William H & Rose K. Baker
Lot 30 Sheffield Lake Village
Sheffield Village
formerly Sheffield Twp., Lorain Co., Ohio.
Survey exclusive of R.R. 19.095 Acres.
Deed " " " 19.016 "
" to Baker = File #293599 - June 22, 1942
Oct. 28 1942. Scale 1"=100'

J. W. Warden Registered Surveyor.

Julia Rothgery et al.
formerly to Hiram Belden D. Vol-3- Pg-434
June 19 1850.

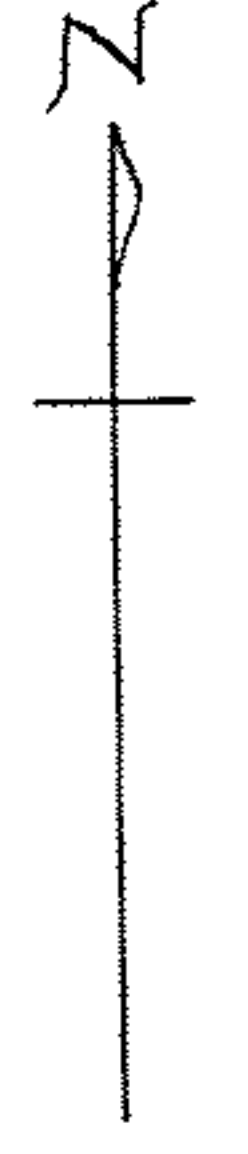

MAP PG 03-00-030-B

49560

PPN 03-00-030-109-003
018
017

Stone Found

159.15'

Iron Pin Set

Iron Pin Set

66'

706.86'

240.85'

89°-37'

Iron Pin Set

706.86'

240.85'

89°-37'

Iron Pin Set

240.85'

90°-04'

Iron Pin Set

1295.38' Due East

1295.50 N 89°-14'E

1295.50 N 89°-14'E

1295.39' S 89°-40' W

1295.37' N 89°-53' W

89°-57'

89°-14'

90°-23'

89°-58'

ROAD 60'

102.55'

Iron Pin found 0.30 West

60'

BREEZE

249.82'

709.50'

50°-03' W

LAKE

307'

Iron Pin Set

East Line Lot 30