


PPN 08-00-103-000 ???  
08-00-104-000 ???

MAP PG 8-D 44563

Lillian M. Sapienza  
D-Vol 314-Pg. 241 Sept. 18 1941.

Albert & Gladys P. Swiers  
D-Vol. 163-Pg. 245 Dec. 20 1919.

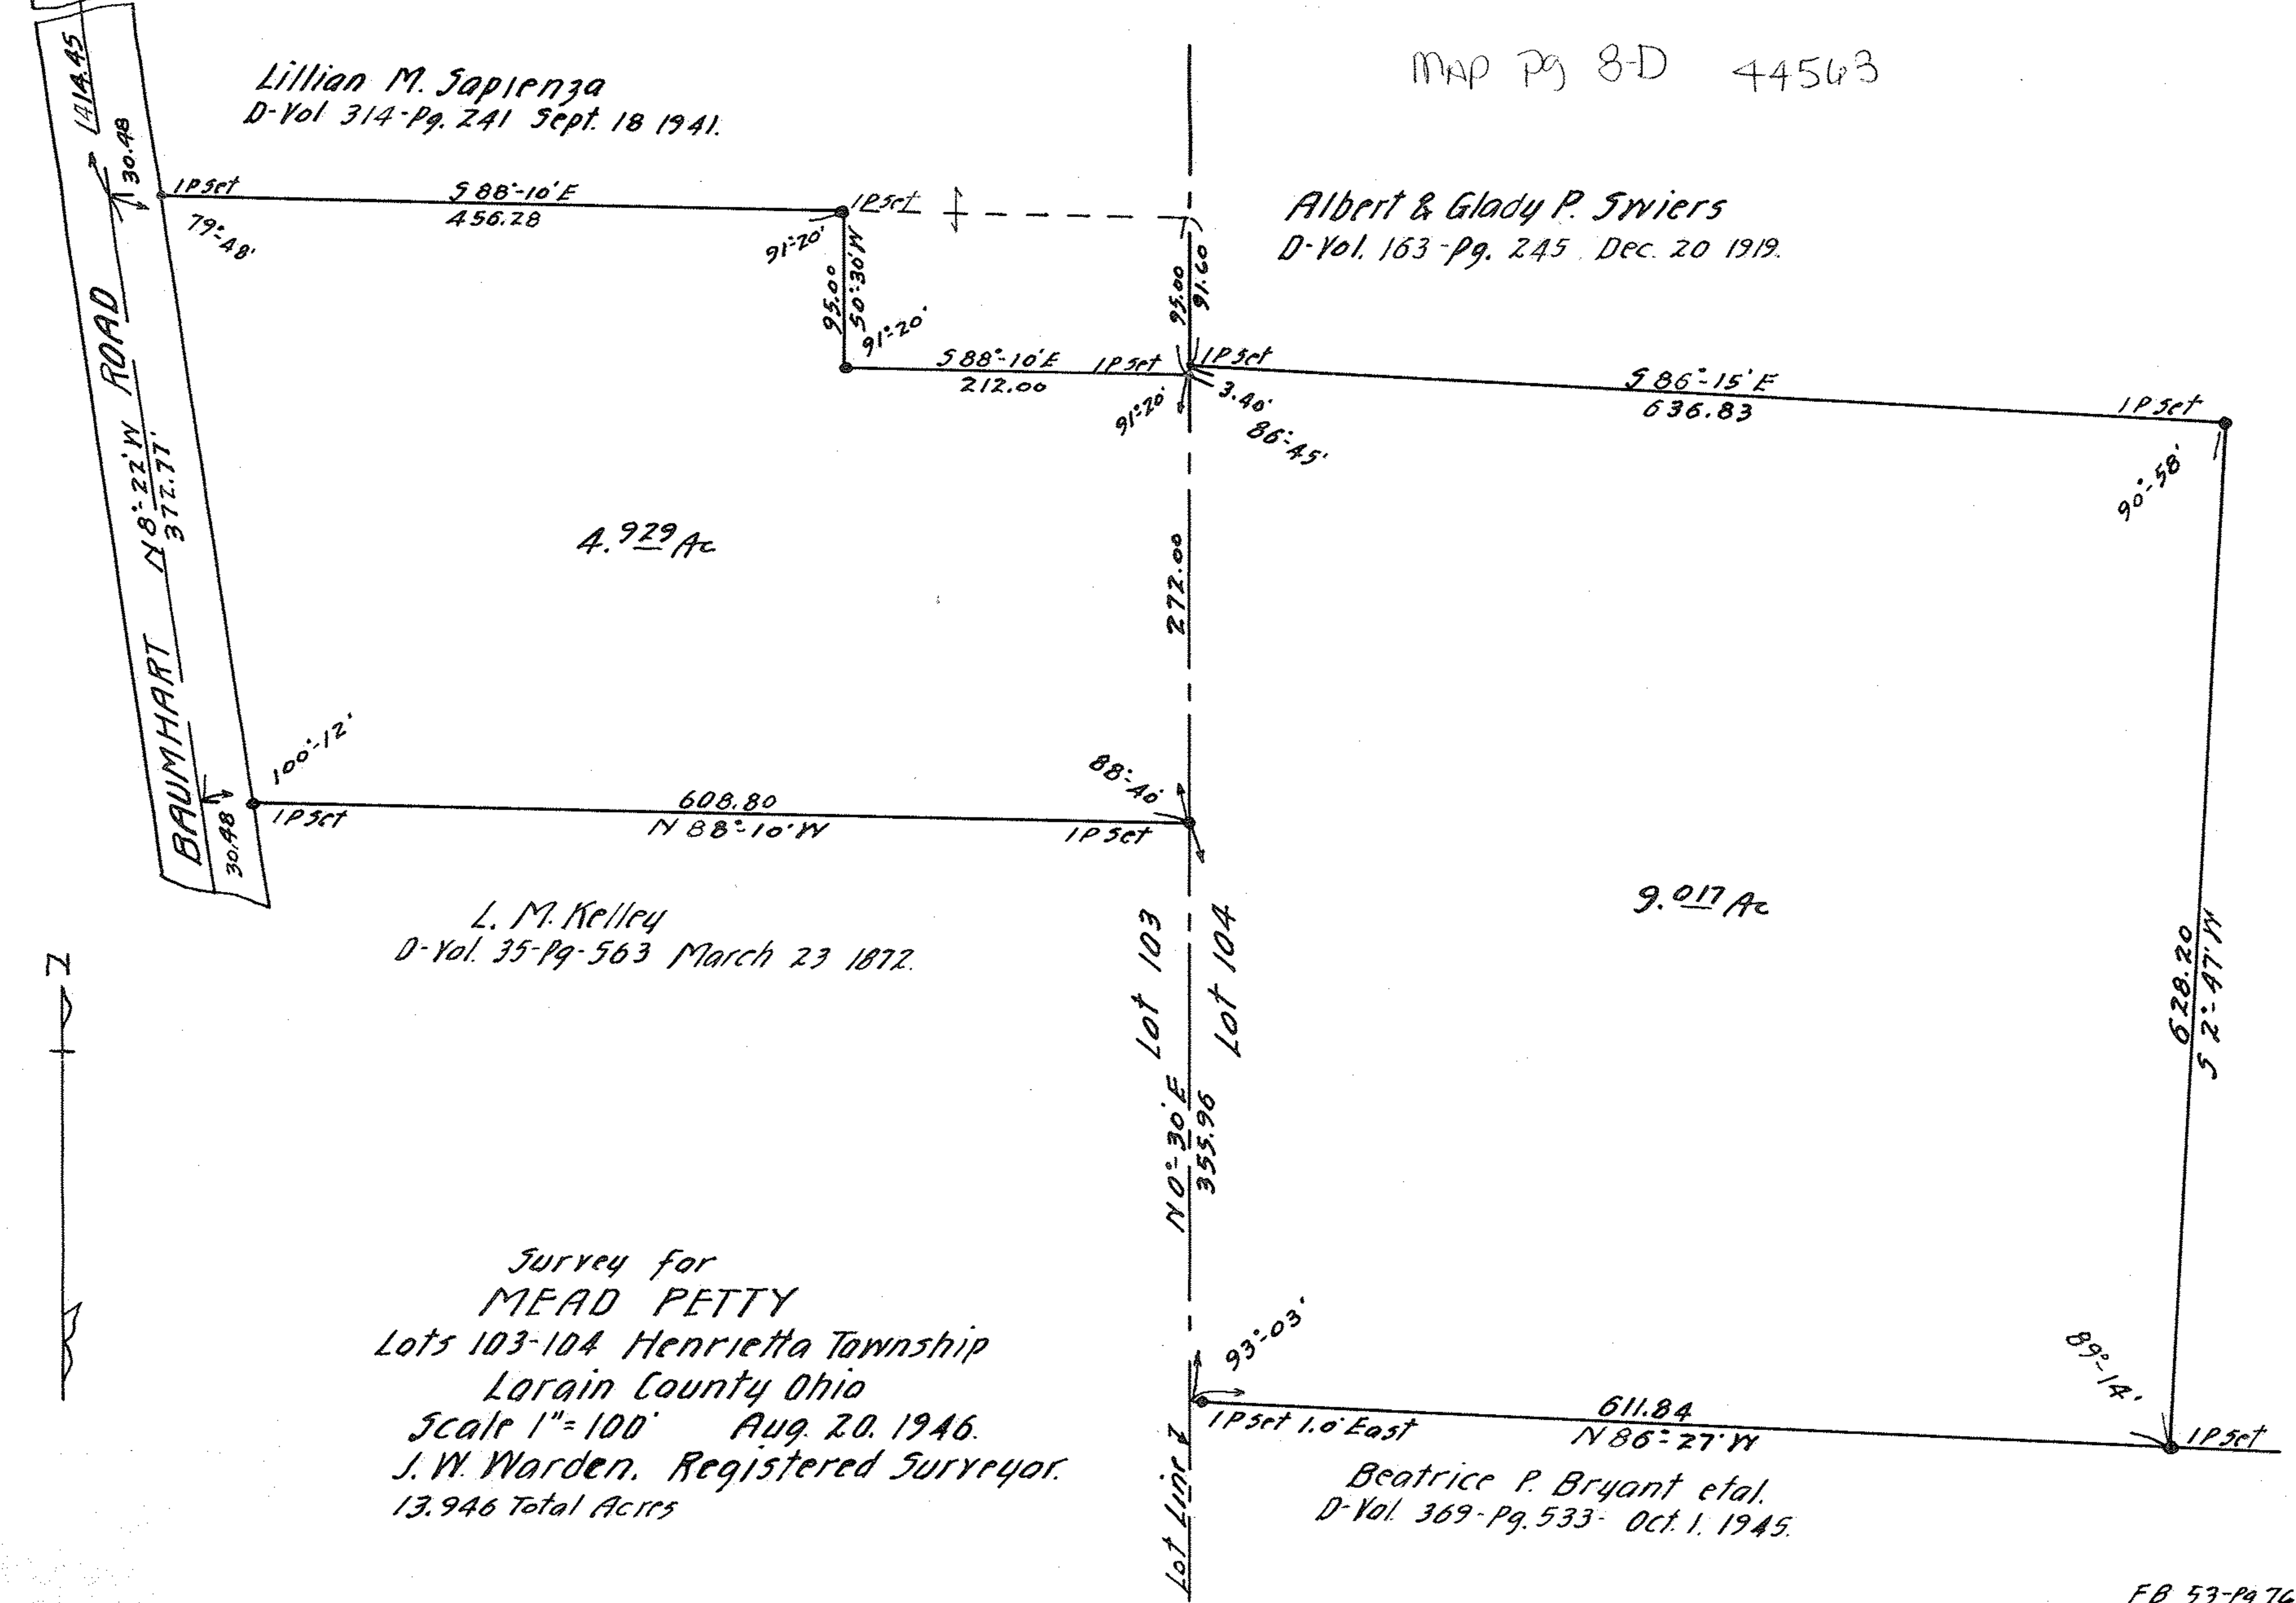

L. M. Kelley  
D-Vol. 35-Pg-563 March 23 1872.

Survey for  
MEAD PETTY  
Lots 103-104 Henrietta Township  
Lorain County Ohio  
Scale 1"=100' Aug. 20, 1946.  
J. W. Warden, Registered Surveyor.  
13.946 Total Acres

Beatrice P. Bryant et al.  
D-Vol. 369-Pg. 533 Oct. 1, 1945.