

# J. W. WARDEN & ASSOCIATES


CIVIL ENGINEERS AND SURVEYORS

D. D. ANDRUS, PRESIDENT  
405 ELYRIA BLOCK  
ELYRIA, OHIO

TELEPHONES 3211  
42871

M. W. JACKSON  
SECRETARY

STATE OF OHIO  
REGISTERED { PROFESSIONAL ENG.  
SURVEYOR

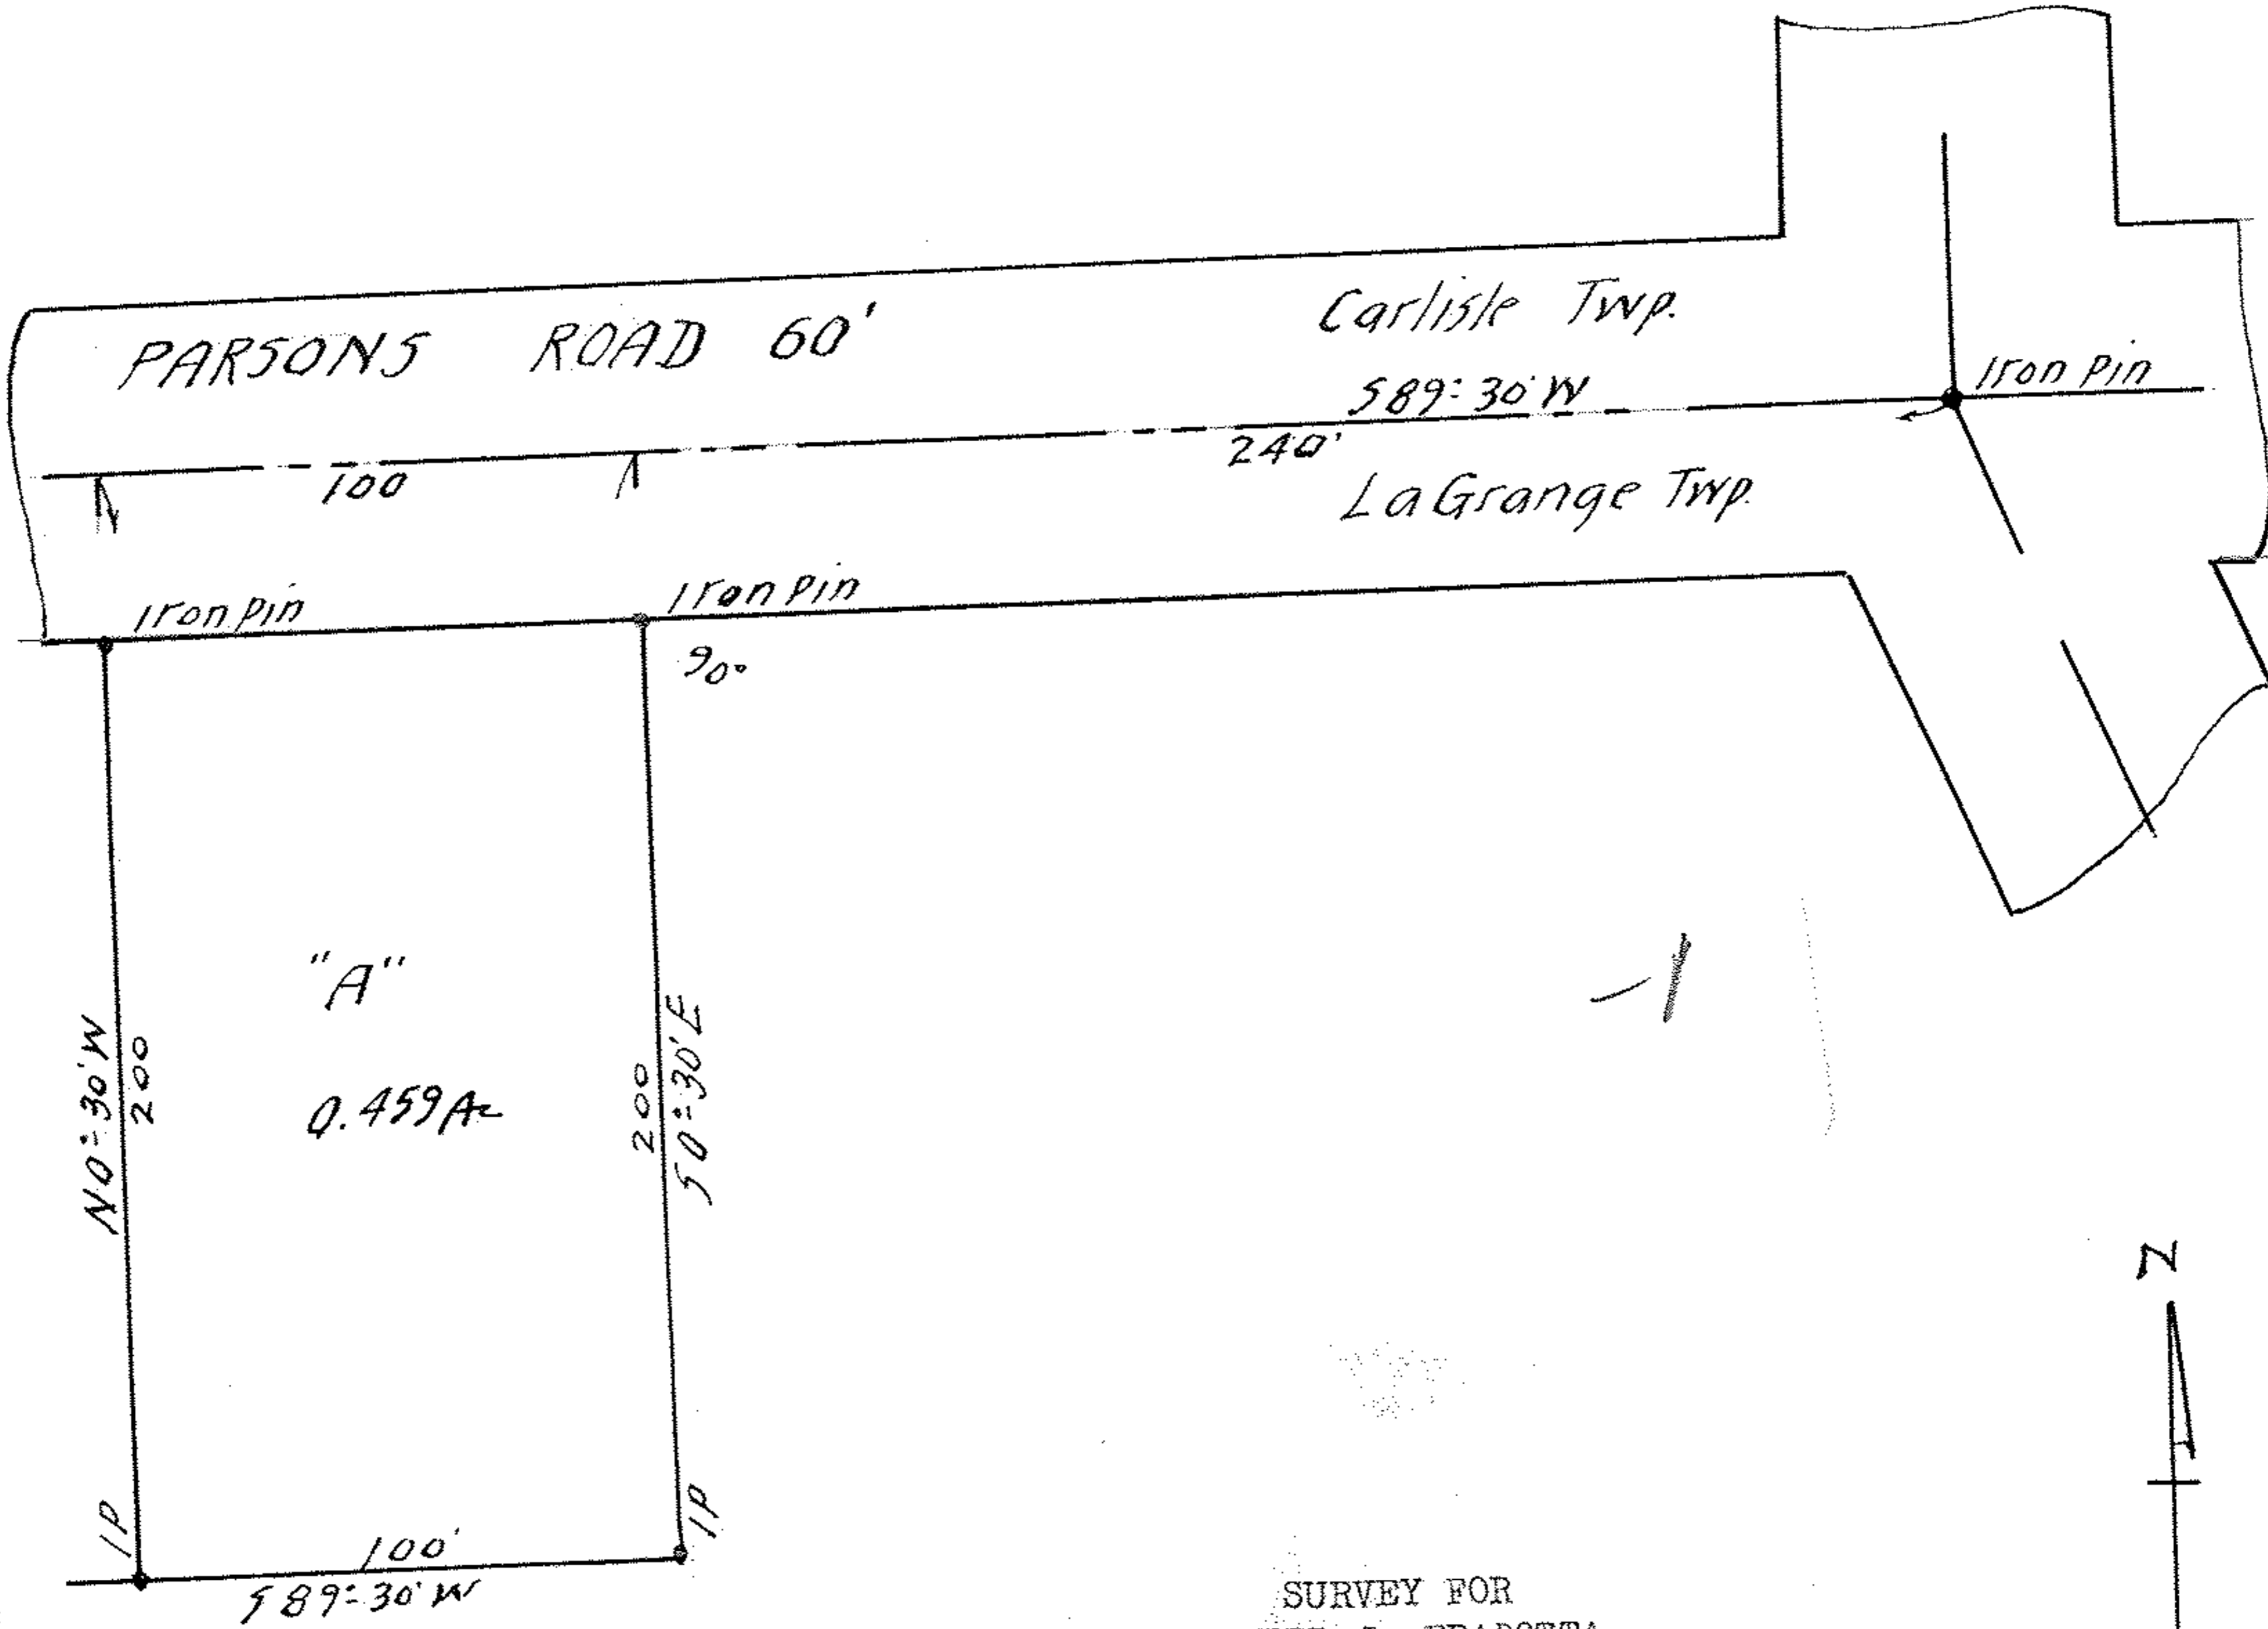

SURVEY FOR  
ALFRED J. FRABOTTA  
LOT 10 LaGRANGE TWP.  
LORAIN COUNTY OHIO  
SCALE 1" = 50' NOV 16, 1956

PPN 15-00-010-000-???

MAP PG 15-D  
~~10000~~

44989

