

# J. W. WARDEN & ASSOCIATES


CIVIL ENGINEERS AND SURVEYORS

STATE OF OHIO  
REGISTERED { PROFESSIONAL ENG.  
SURVEYOR

D. D. ANDRUS, PRESIDENT  
405 ELYRIA BLOCK  
ELYRIA, OHIO

TELEPHONES 3211  
42871

M. W. JACKSON  
SECRETARY

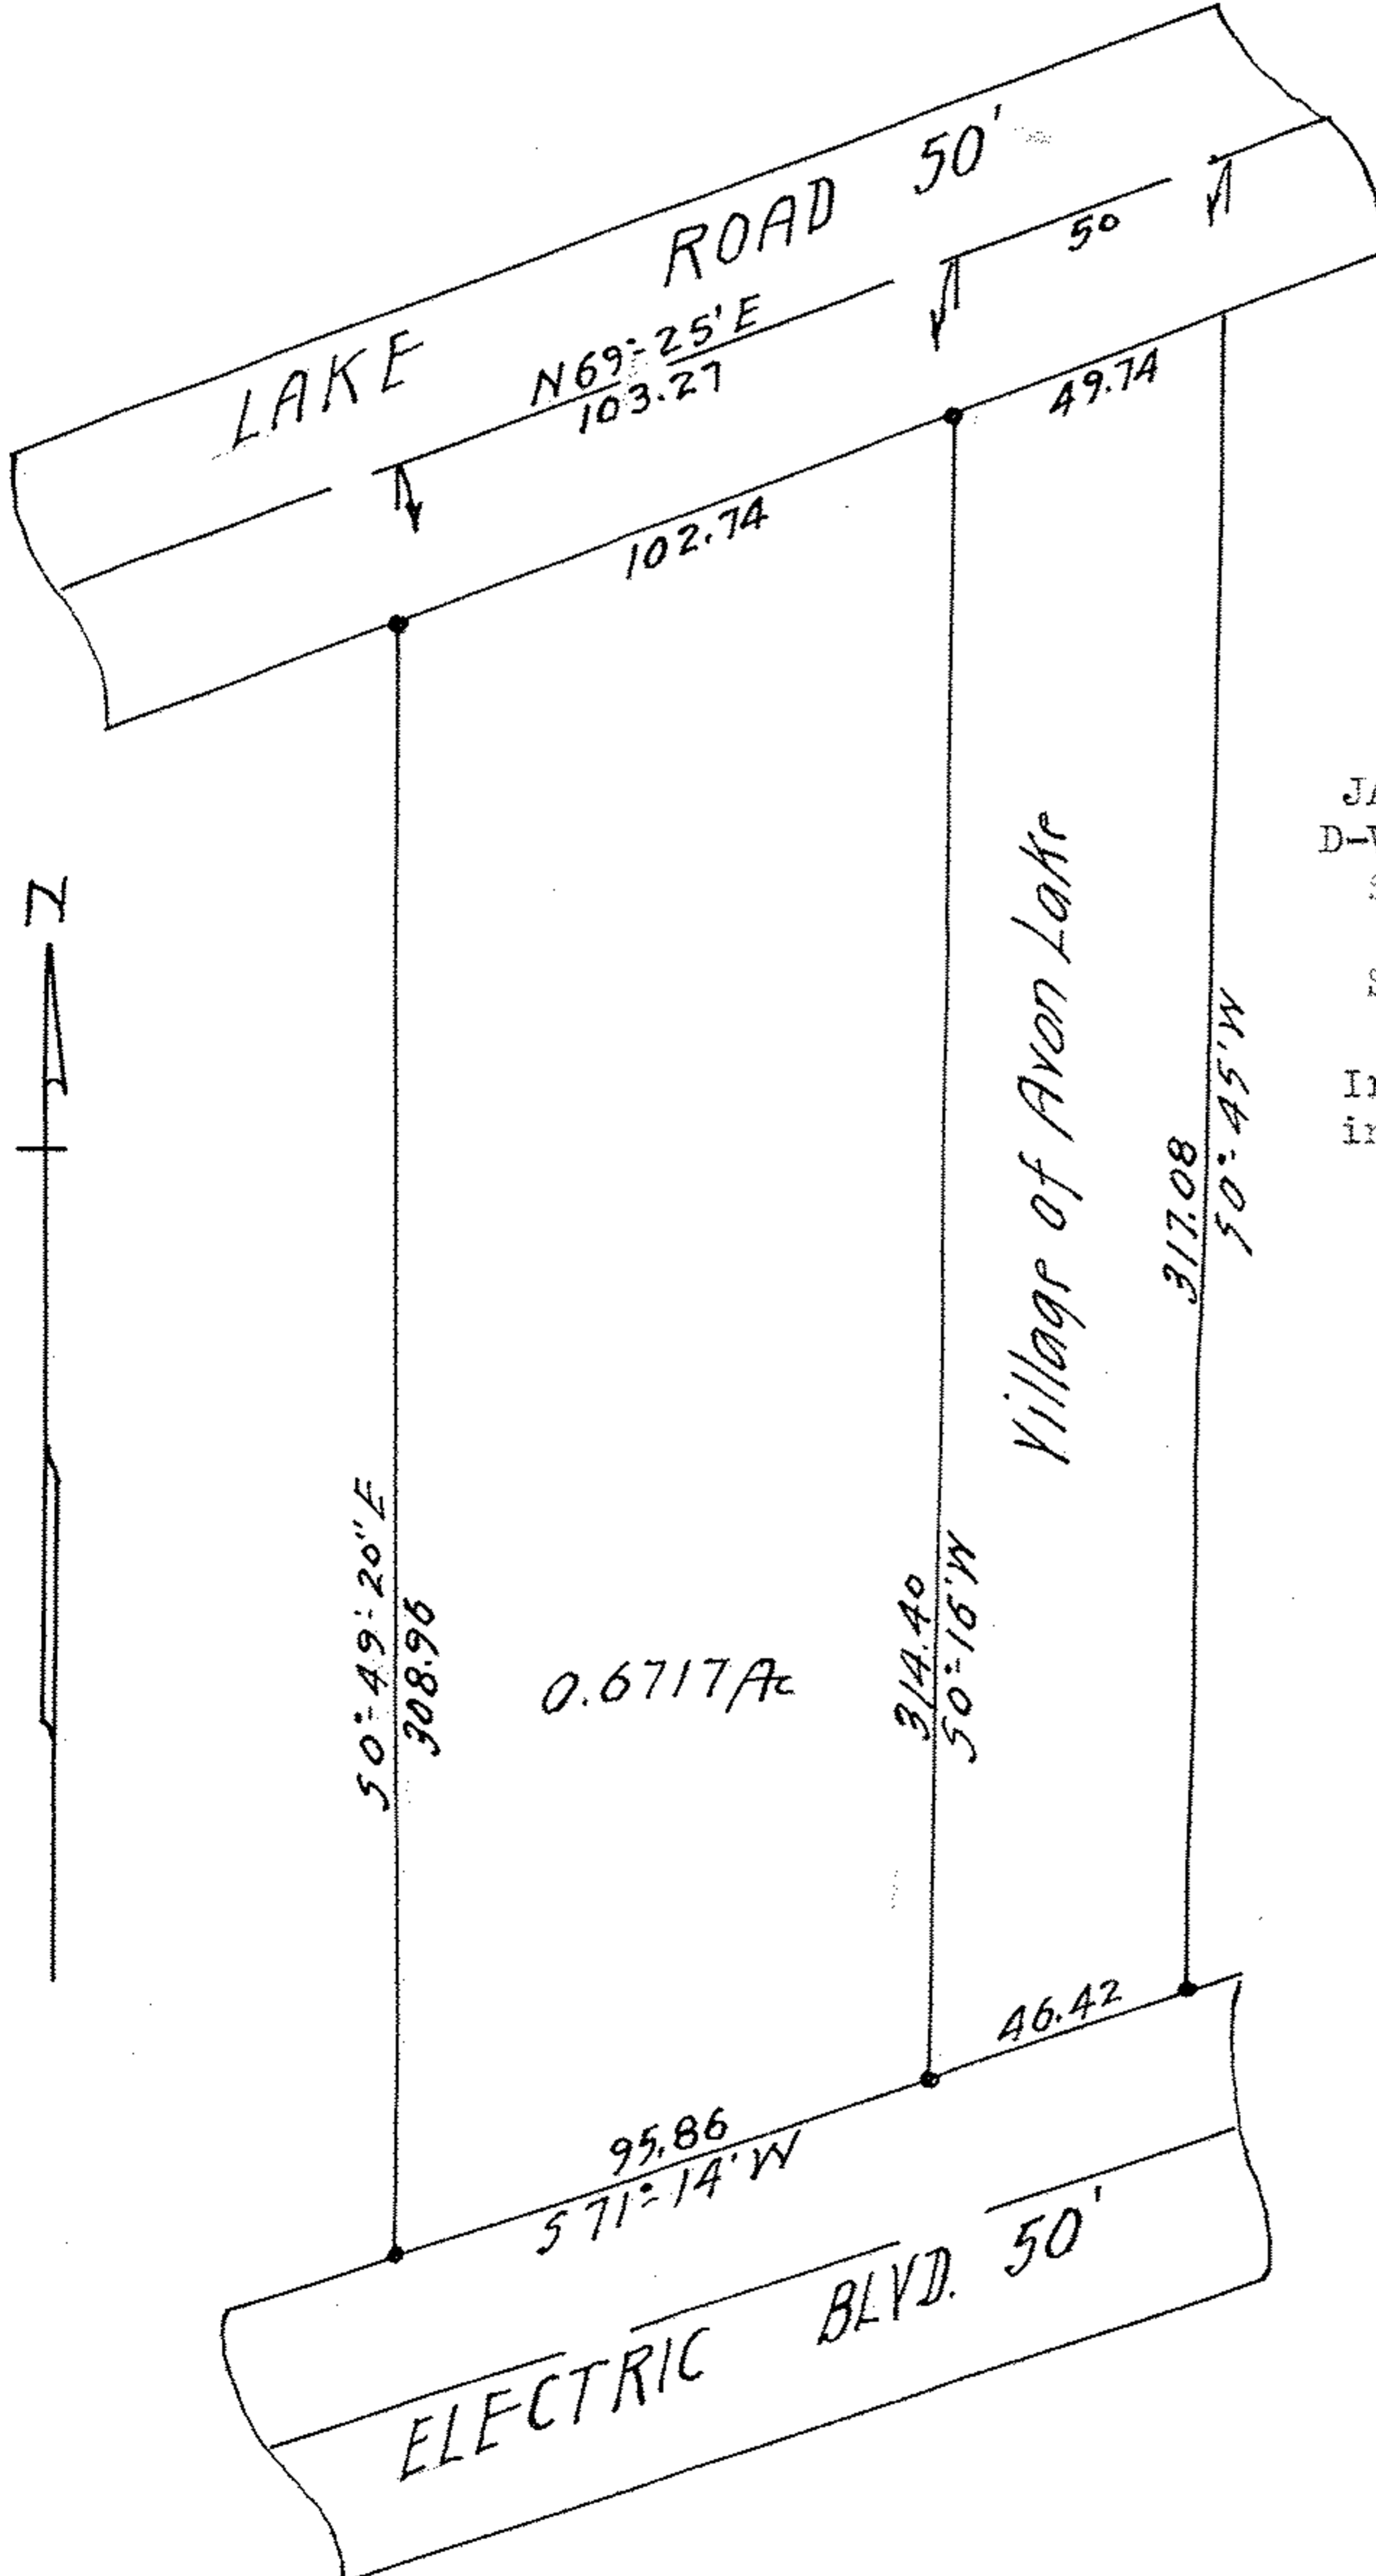

SURVEY FOR  
JACK J. AND DOROTHY M. SUKEL  
D-VOL 696 PG. 566 MAY 20, 1957  
SECTION 7 AVON LAKE VILLAGE  
LORAIN COUNTY, OHIO  
SCALE 1" = 50' OCT. 8, 1957

Iron stakes at all points indicated thus •

22-0871-1