


E-1490-ee

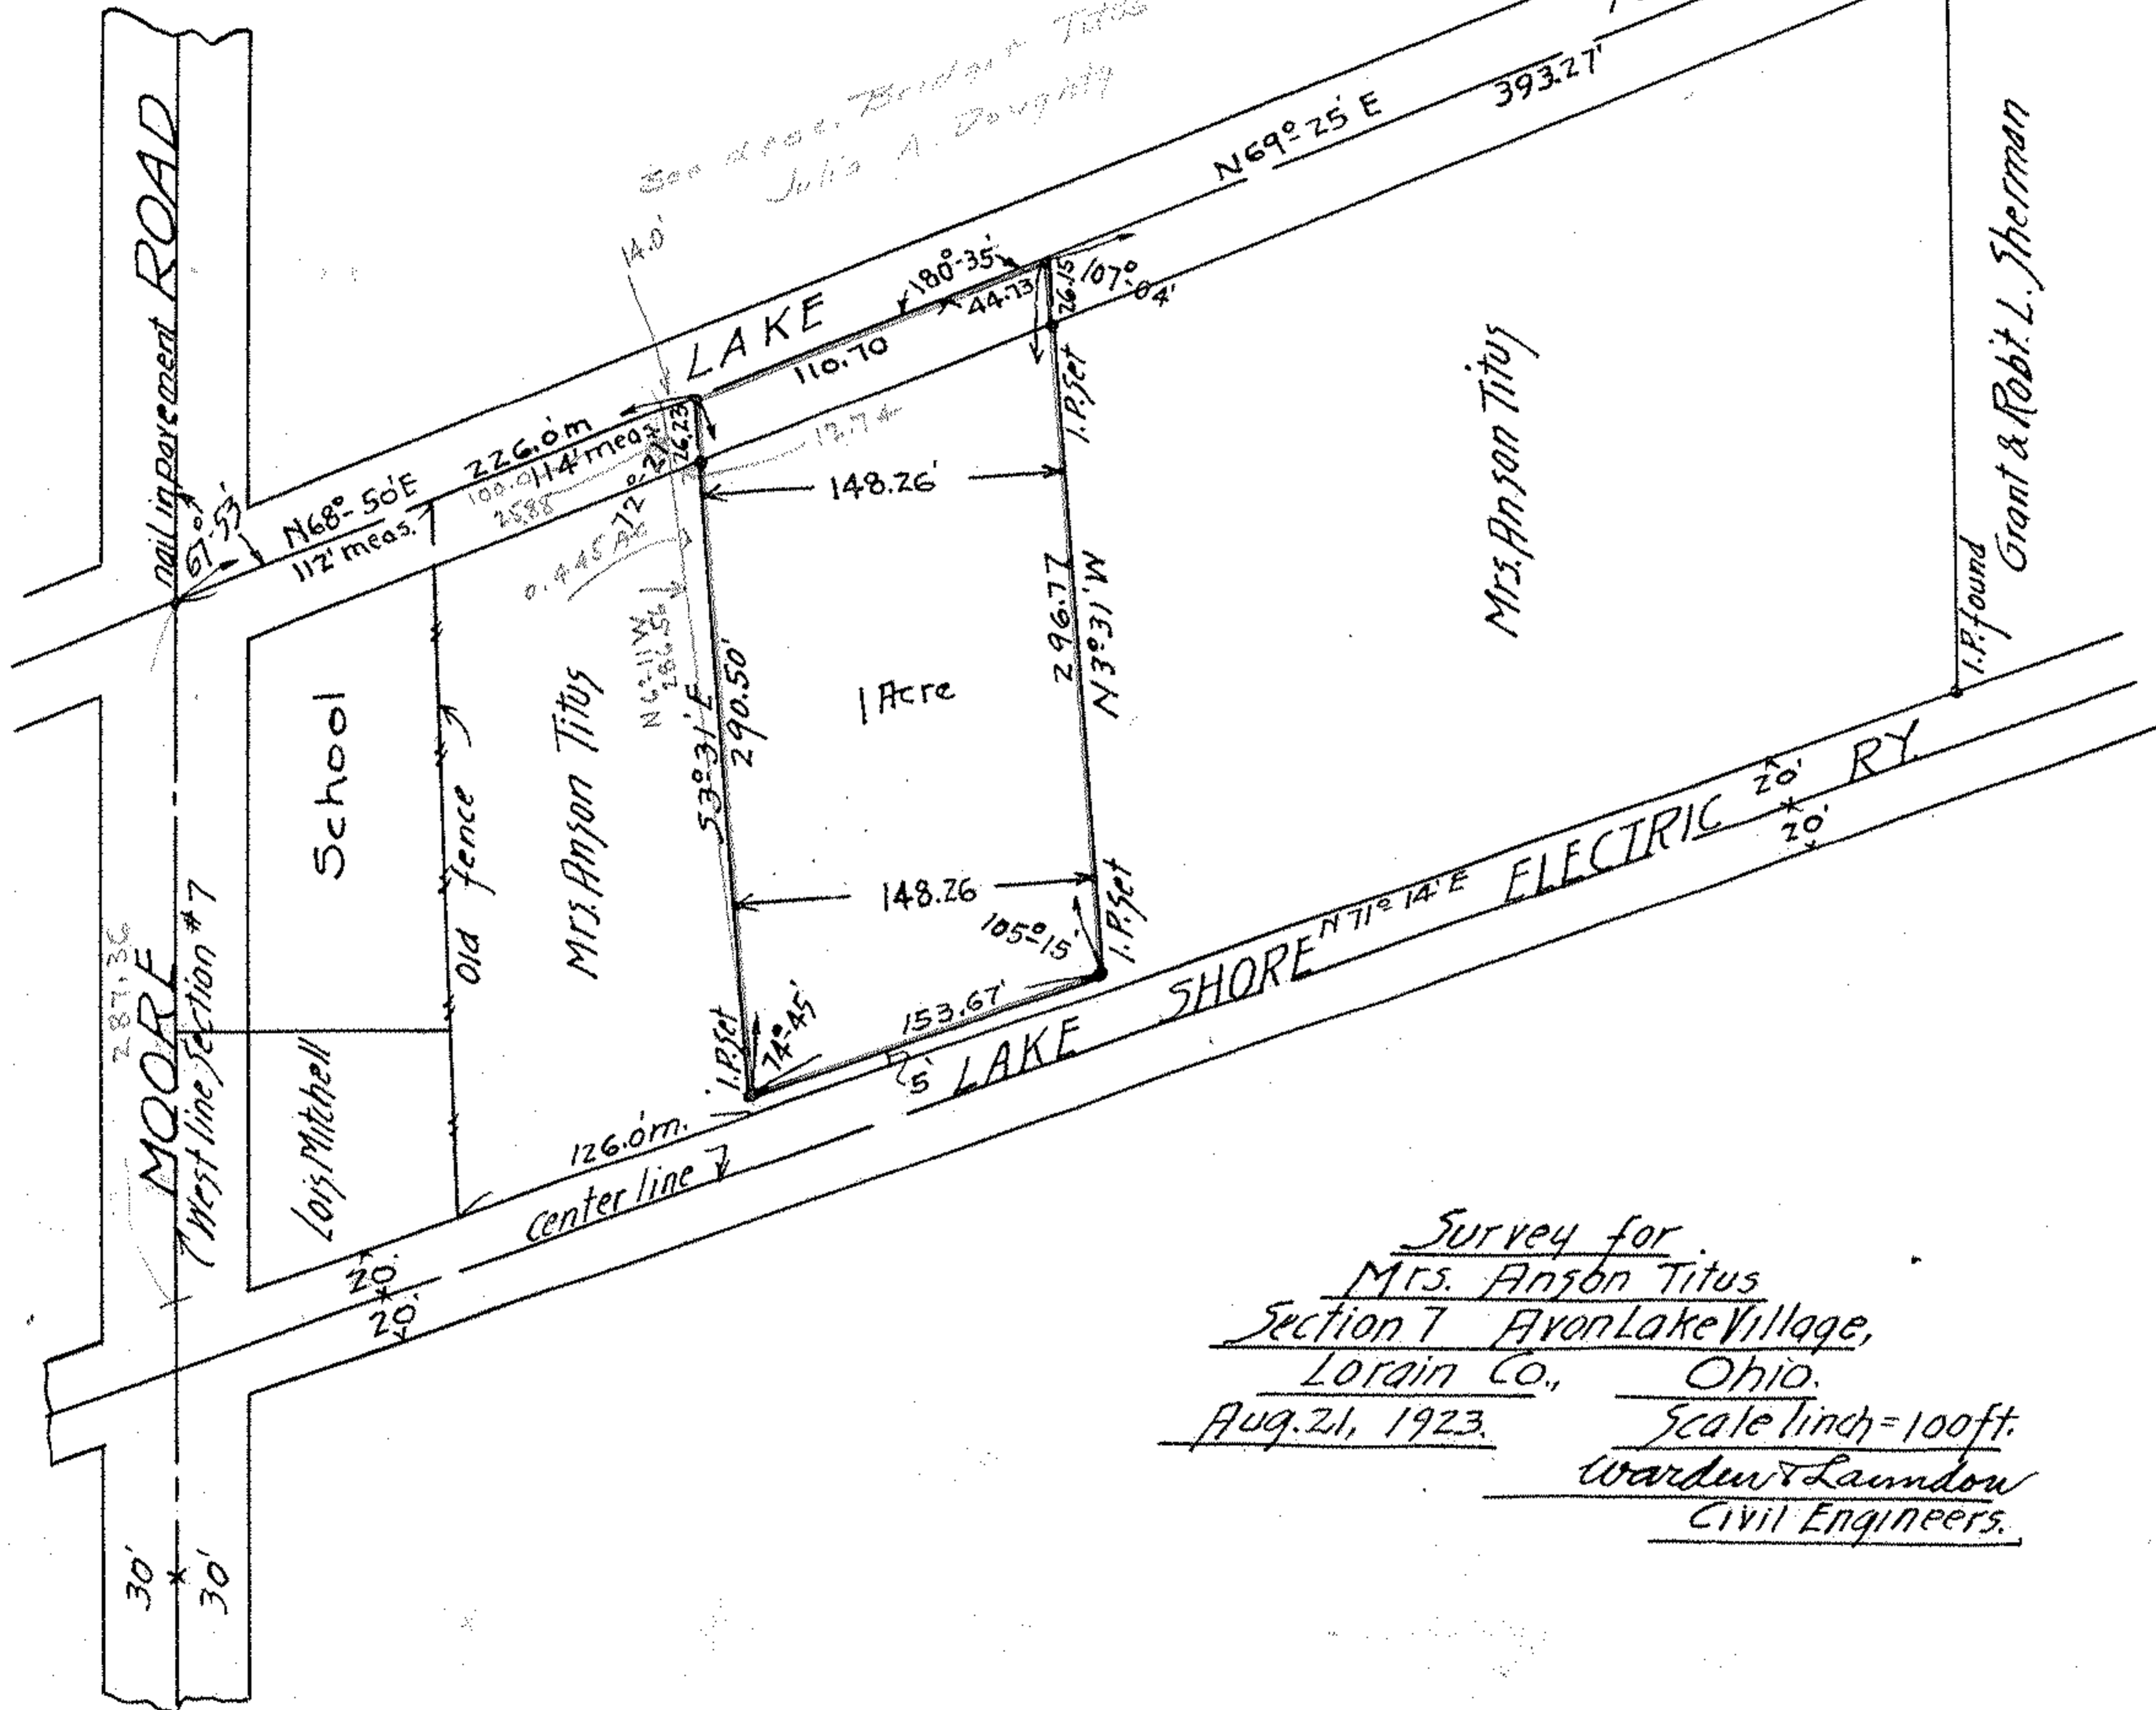

Survey for
 Mrs. Anson Titus
 Section 7 Avon Lake Village,
 Lorain Co., Ohio.
 Aug. 21, 1923. Scale 1 inch = 100 ft.
 Warden & Laundow
 Civil Engineers.