


1827 38

23-1387.2

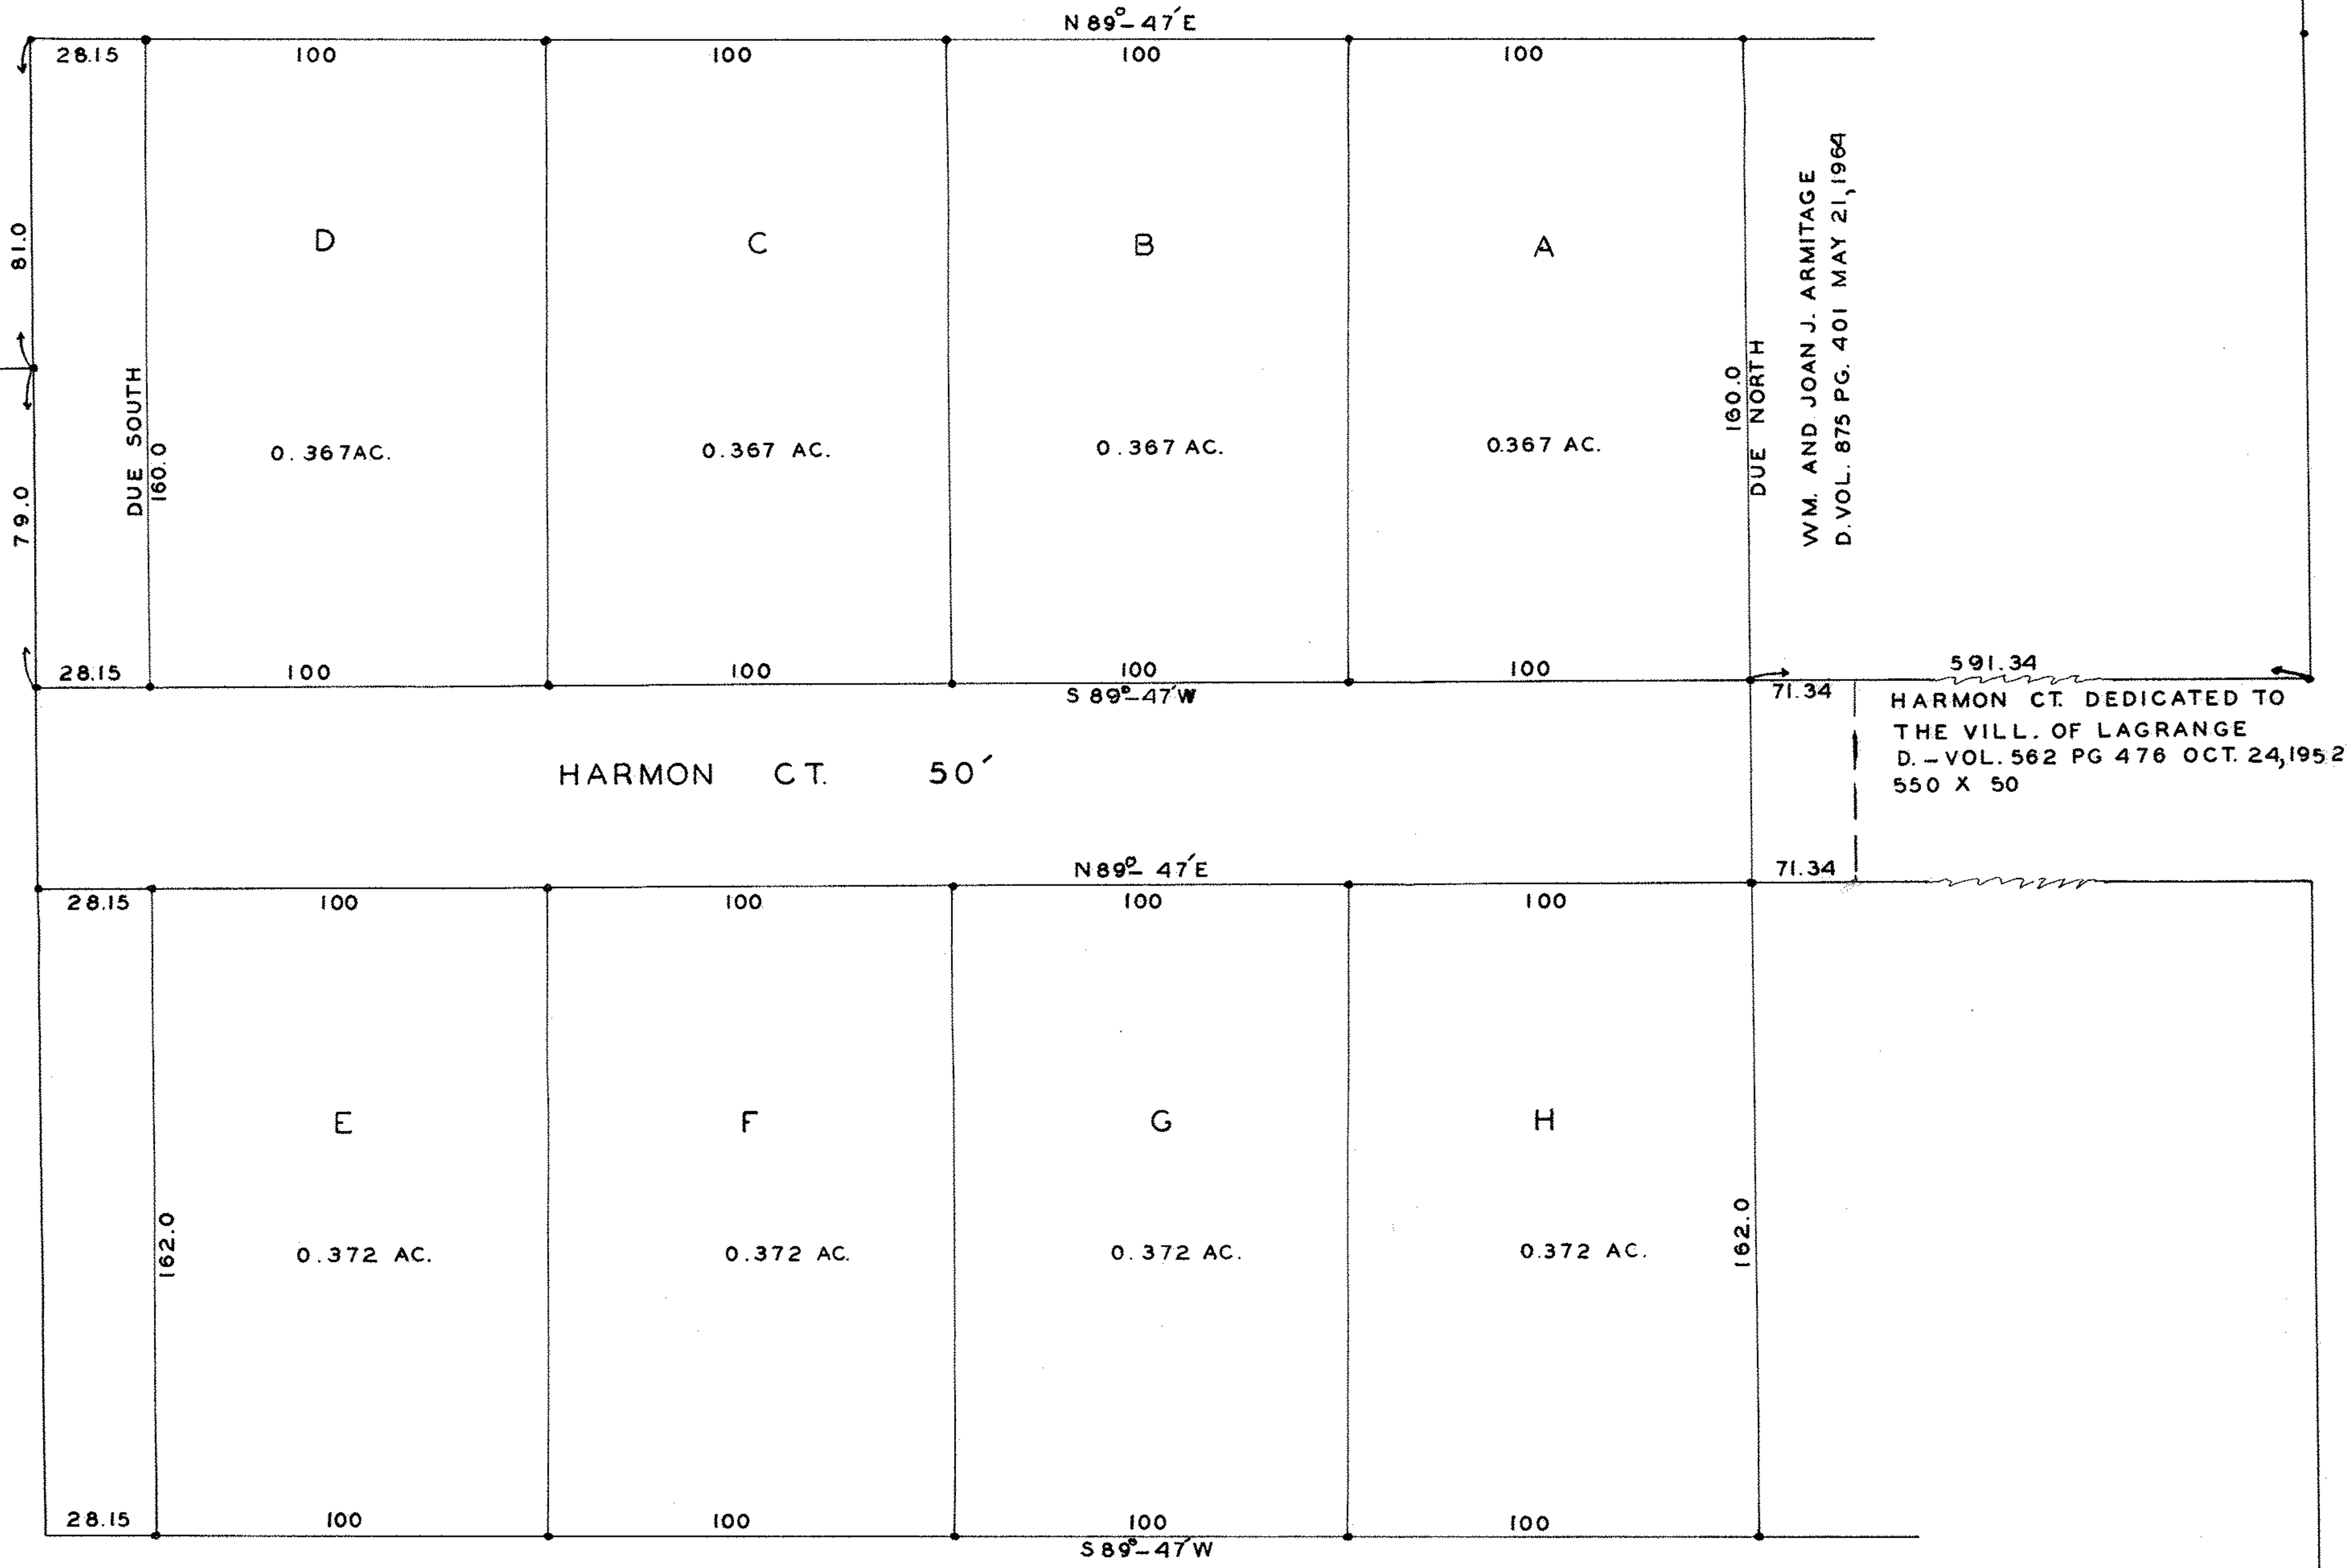

SURVEY FOR  
 DEWEY AND BESSIE ALDRICH  
 D-VOL. 831 PG. 287 SEPT. 11, 1962  
 O.L. 45 LAGRANGE TOWNSHIP  
 LAGRANGE VILL. LORAIN CO, OHIO  
 SCALE 1" = 40' MARCH 30, 1966  
 D.D. ANDRUS AND ASSOCIATES REG. SURVEYORS

● INDICATES IRON STAKES FOUND OR SET

PPN 15-00-045-101-???

MAP PG 15-00-045-B  
 44617