


701472

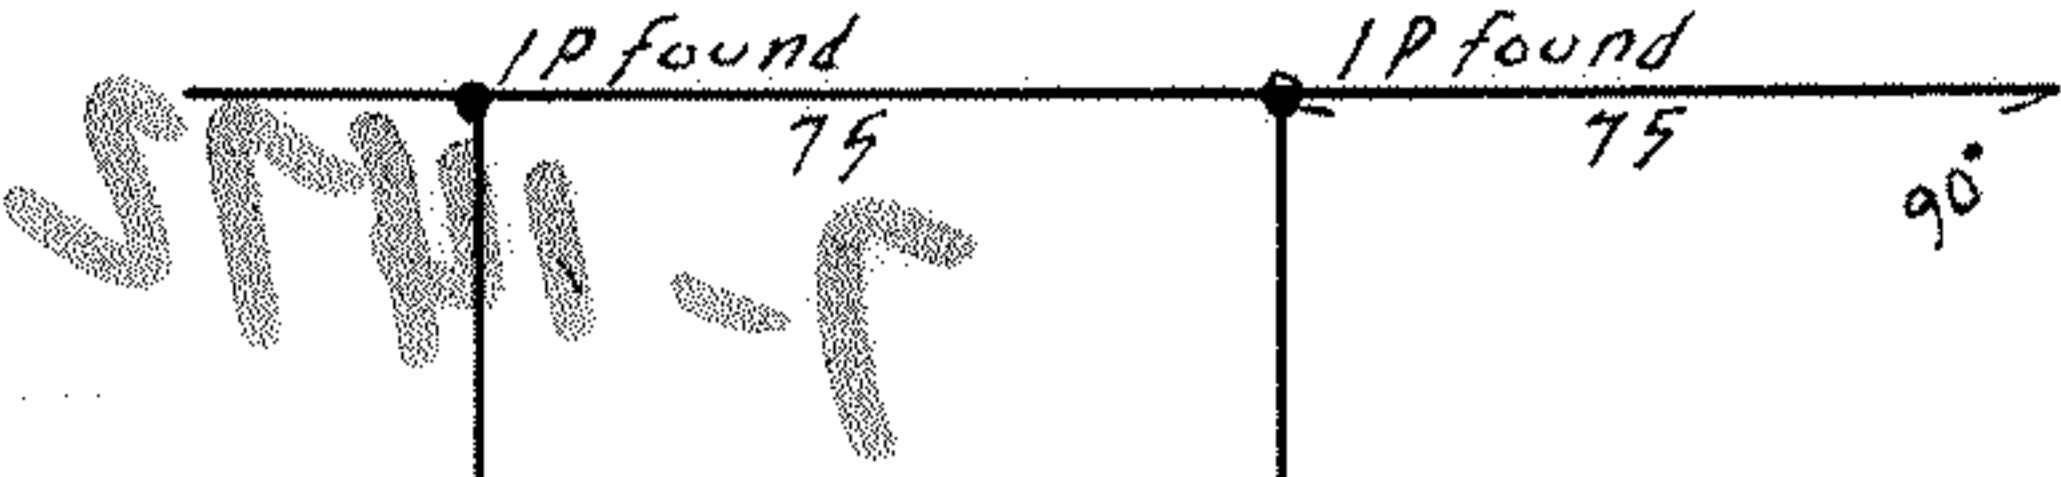

N0° 47' 20" E
393.20

IP SET
459.58

151.55

IP SET

98.40

48° 22' 8"

IP found

40.06

100.16
ROAD 60'

525.96
N0° 47' 20" E

CARLISLE TWP. SEC. 6

Eaton TWP Lot 93

DEWHURST ROAD 40'

SURVEY FOR
 W. E. AND I. G. HOWK
 D-VOL 495 PG 349 JULY 7, 1950
 SECTION 6 CARLISLE TOWNSHIP
 LORAIN COUNTY, OHIO
 SCALE 1" = 50' JUNE 15, 1965
 D. D. ANDRUS AND ASSOCIATES
 REG SURVEYORS