


MIDDLE AVENUE 99'

NINTH ST 66'

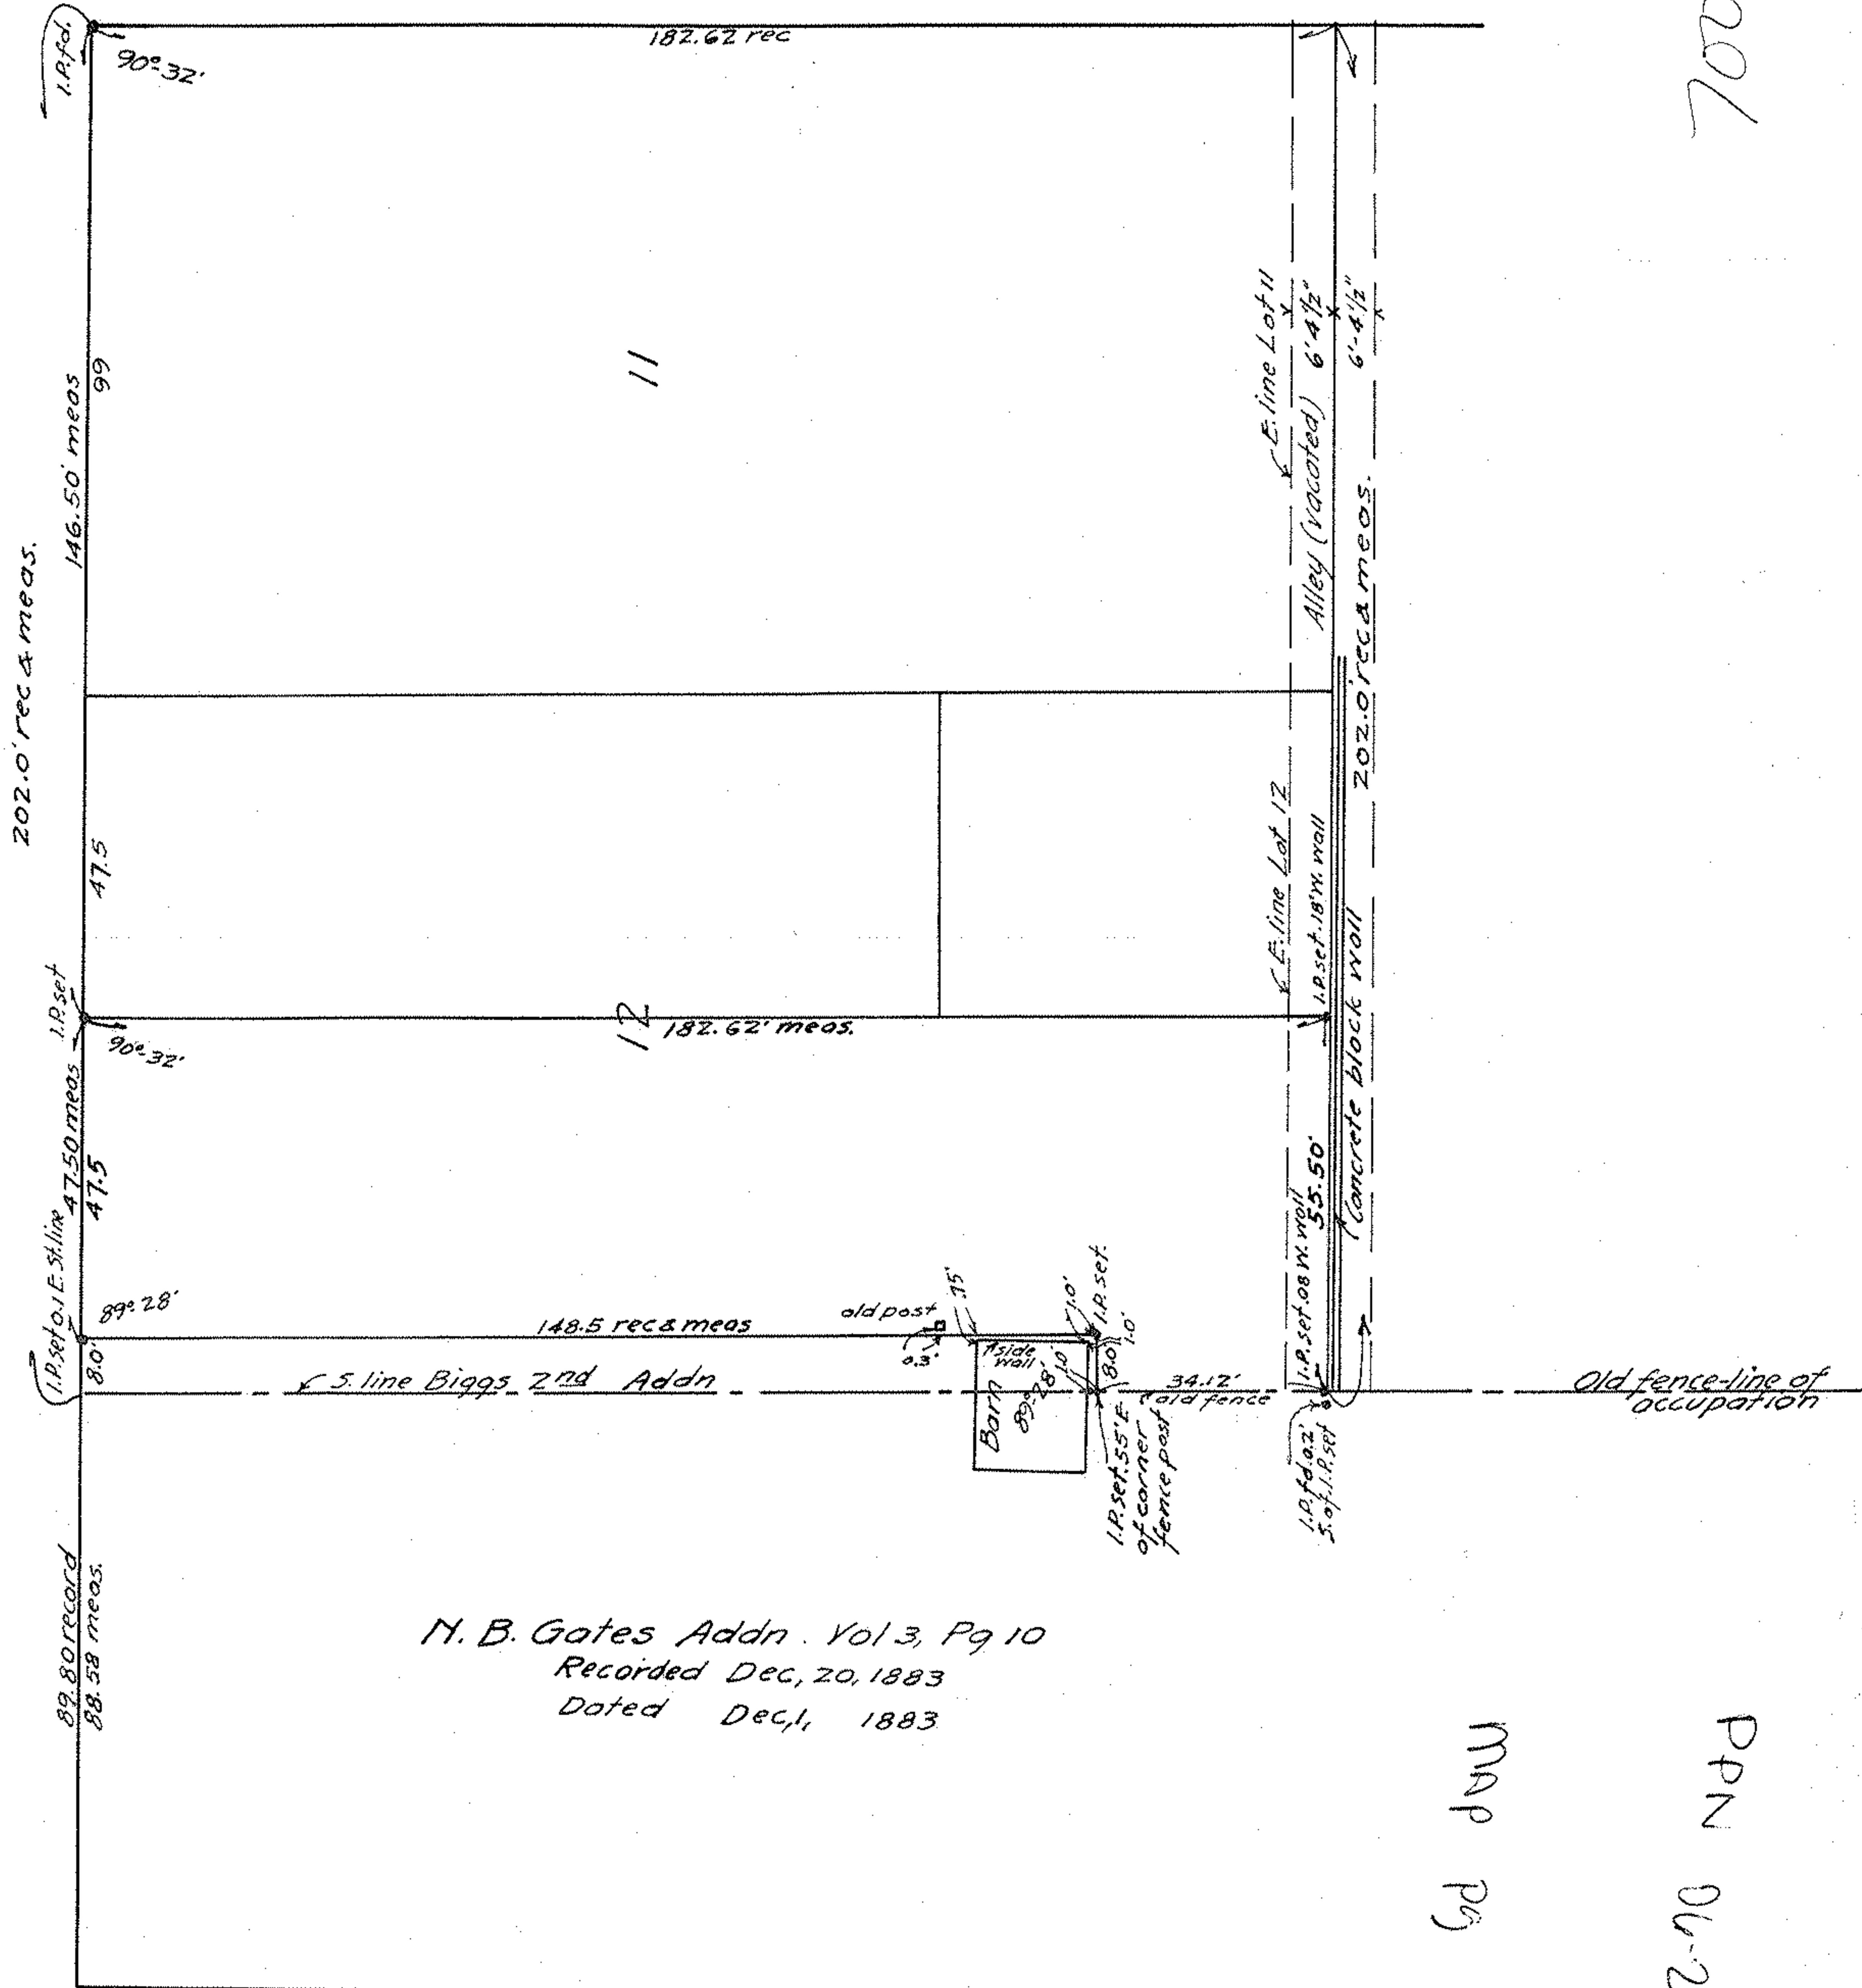

GATES AVE 50'

SURVEY FOR HENRY J. HART
PART OF LOT #12 BIGGS 2ND ADDN.
RECORDED VOL 3, PG 19, NOV, 23, 1882
ELYRIA, LORAIN CO. OHIO. SCALE
WARDEN & FAUNDRE.
ENGINEERS.