

JOHN W. WARDEN

CIVIL ENGINEER AND SURVEYOR

405 ELYRIA BLOCK

ELYRIA, OHIO

STATE OF OHIO


REGISTERED } PROFESSIONAL ENG.
SURVEYOR

PHONES

BUSINESS 3211

RESIDENCE 38633

*George Charles Hollstein
D-Vol. 409-Pg. 348 March 11 1947.*

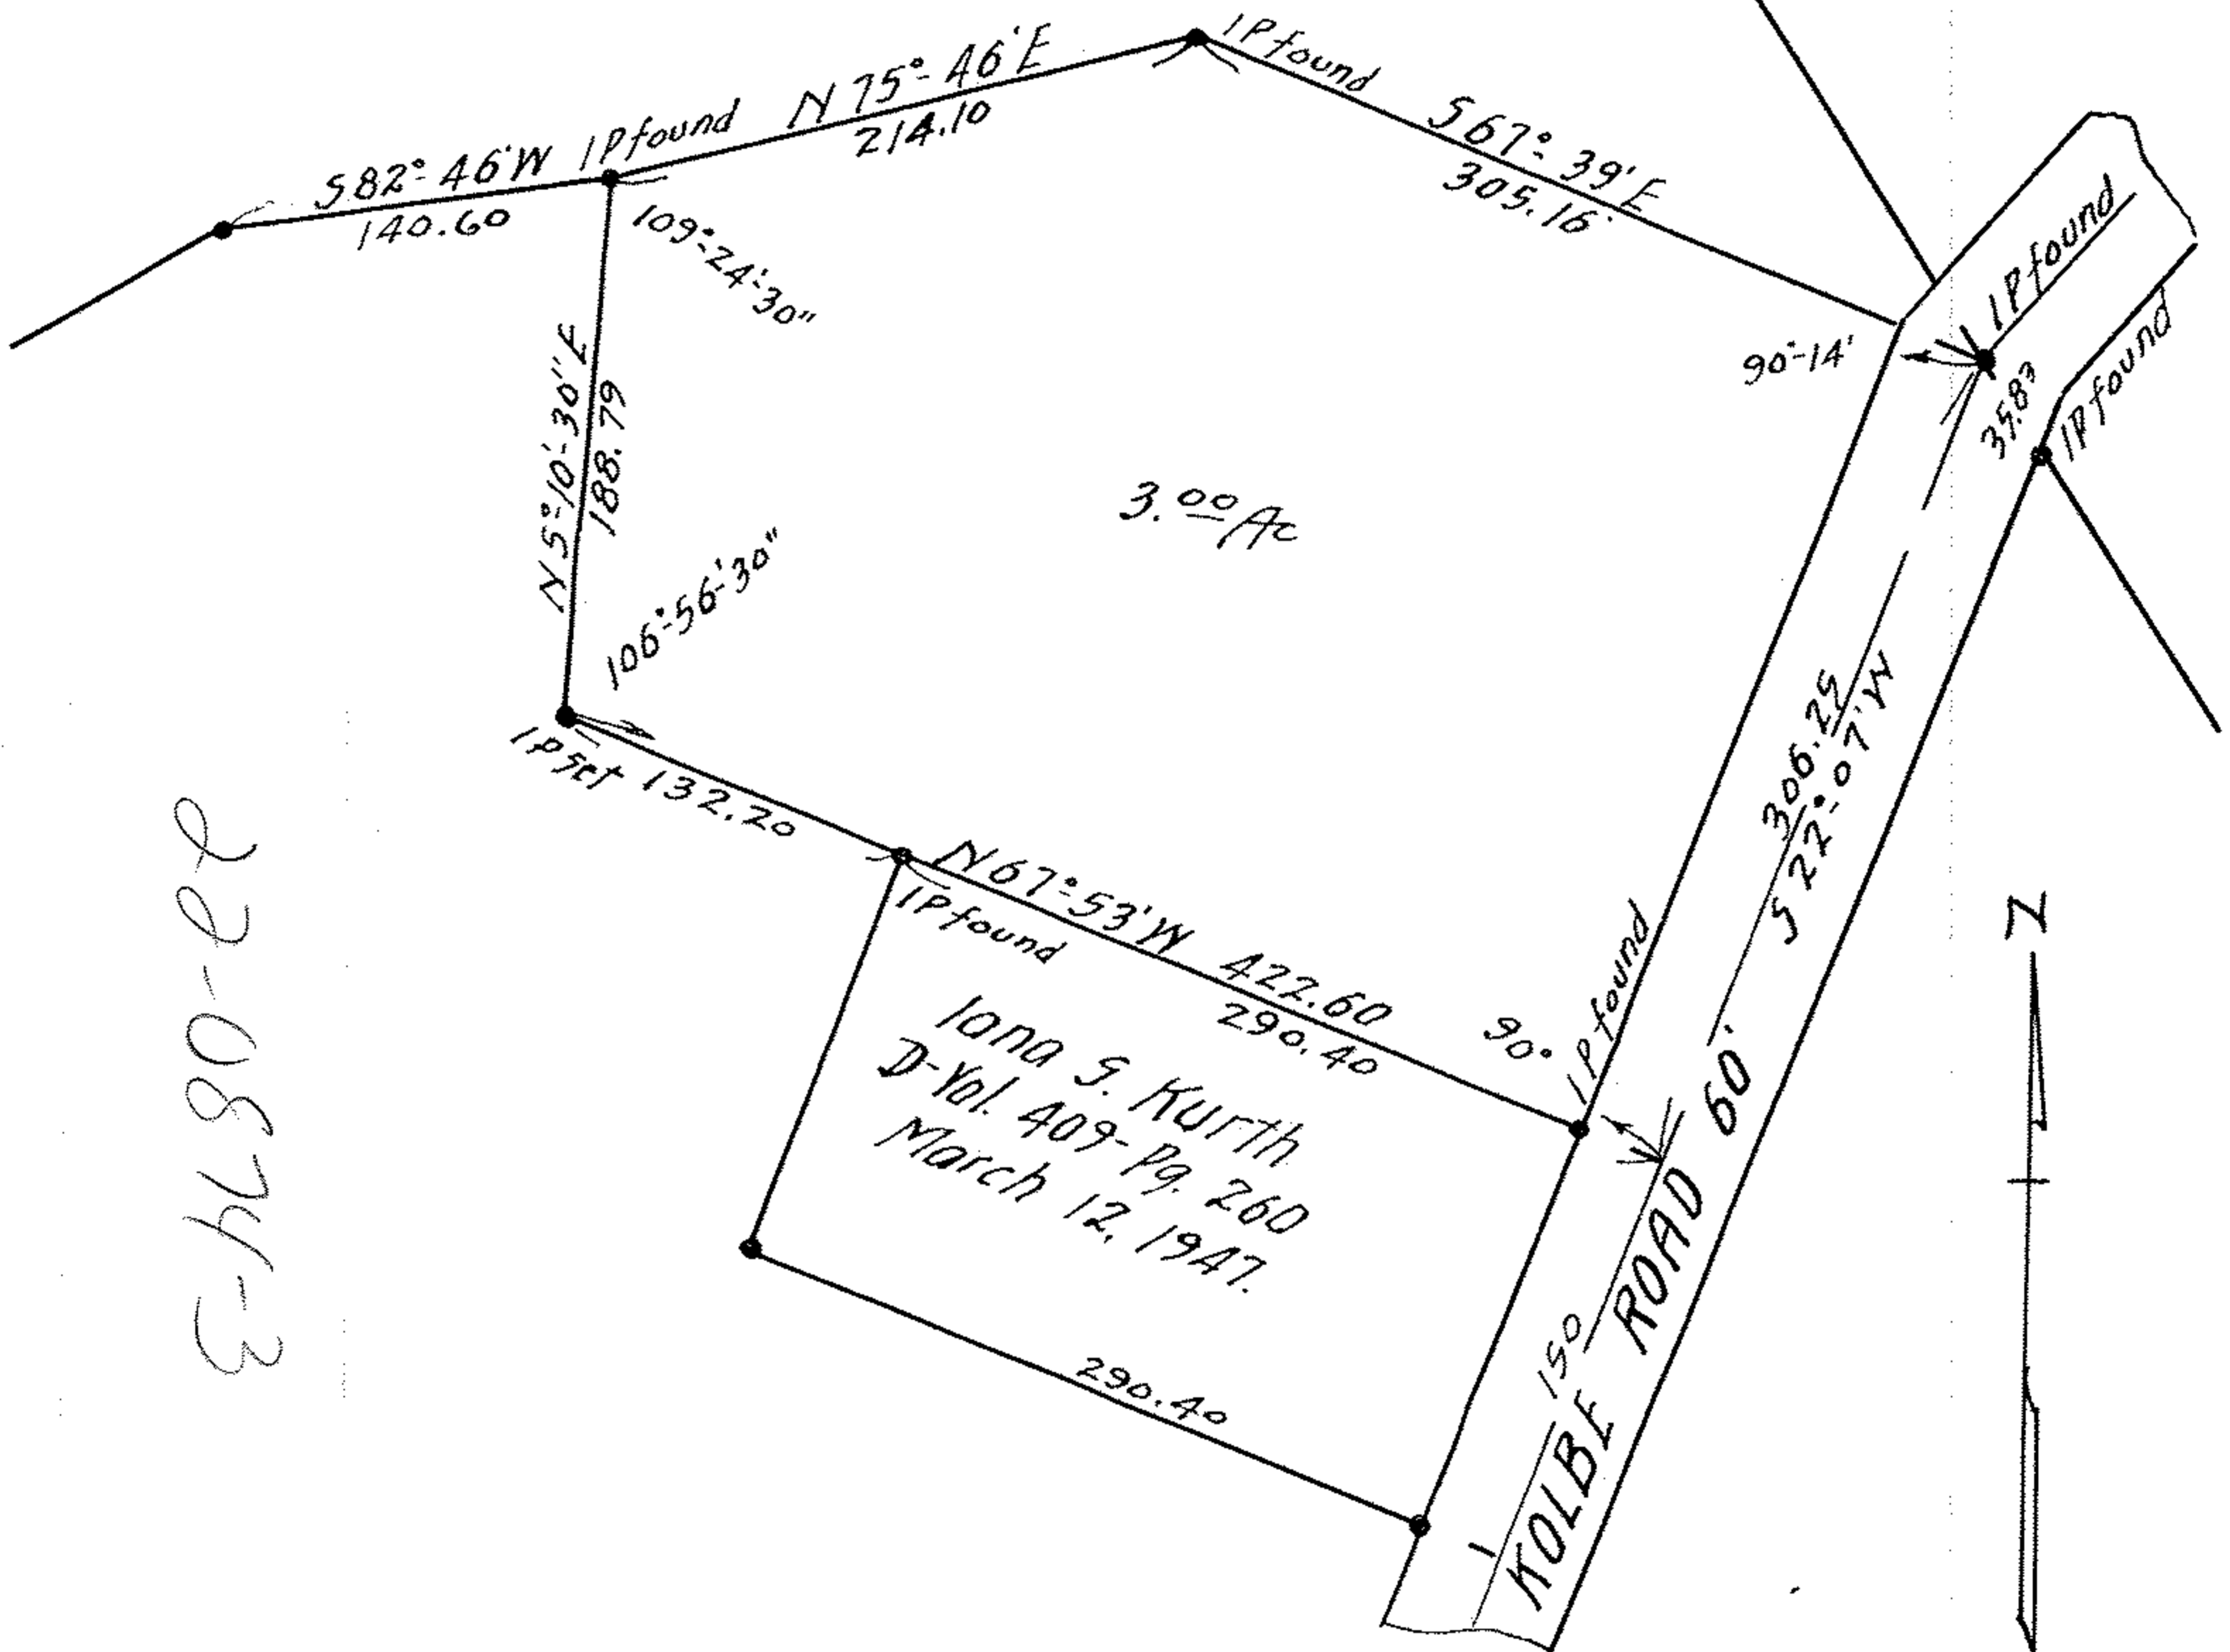

22-0874-3

*Survey for
EDWIN A. & TULSA M. SEGERT
D-Vol. 343-Pg. 438 Feb. 6. 1945.
Lot 21 Amherst Township
Lorain County Ohio.
Scale 1" = 100' Feb. 24. 1949.*