


700141

111-7

Survey of
 Lots 86 & 89 Block #2
 Wellington Village Lorain Co.,
 December 17-1910. Scale 1" = 30 ft.
 C. H. Lawrence C.E.

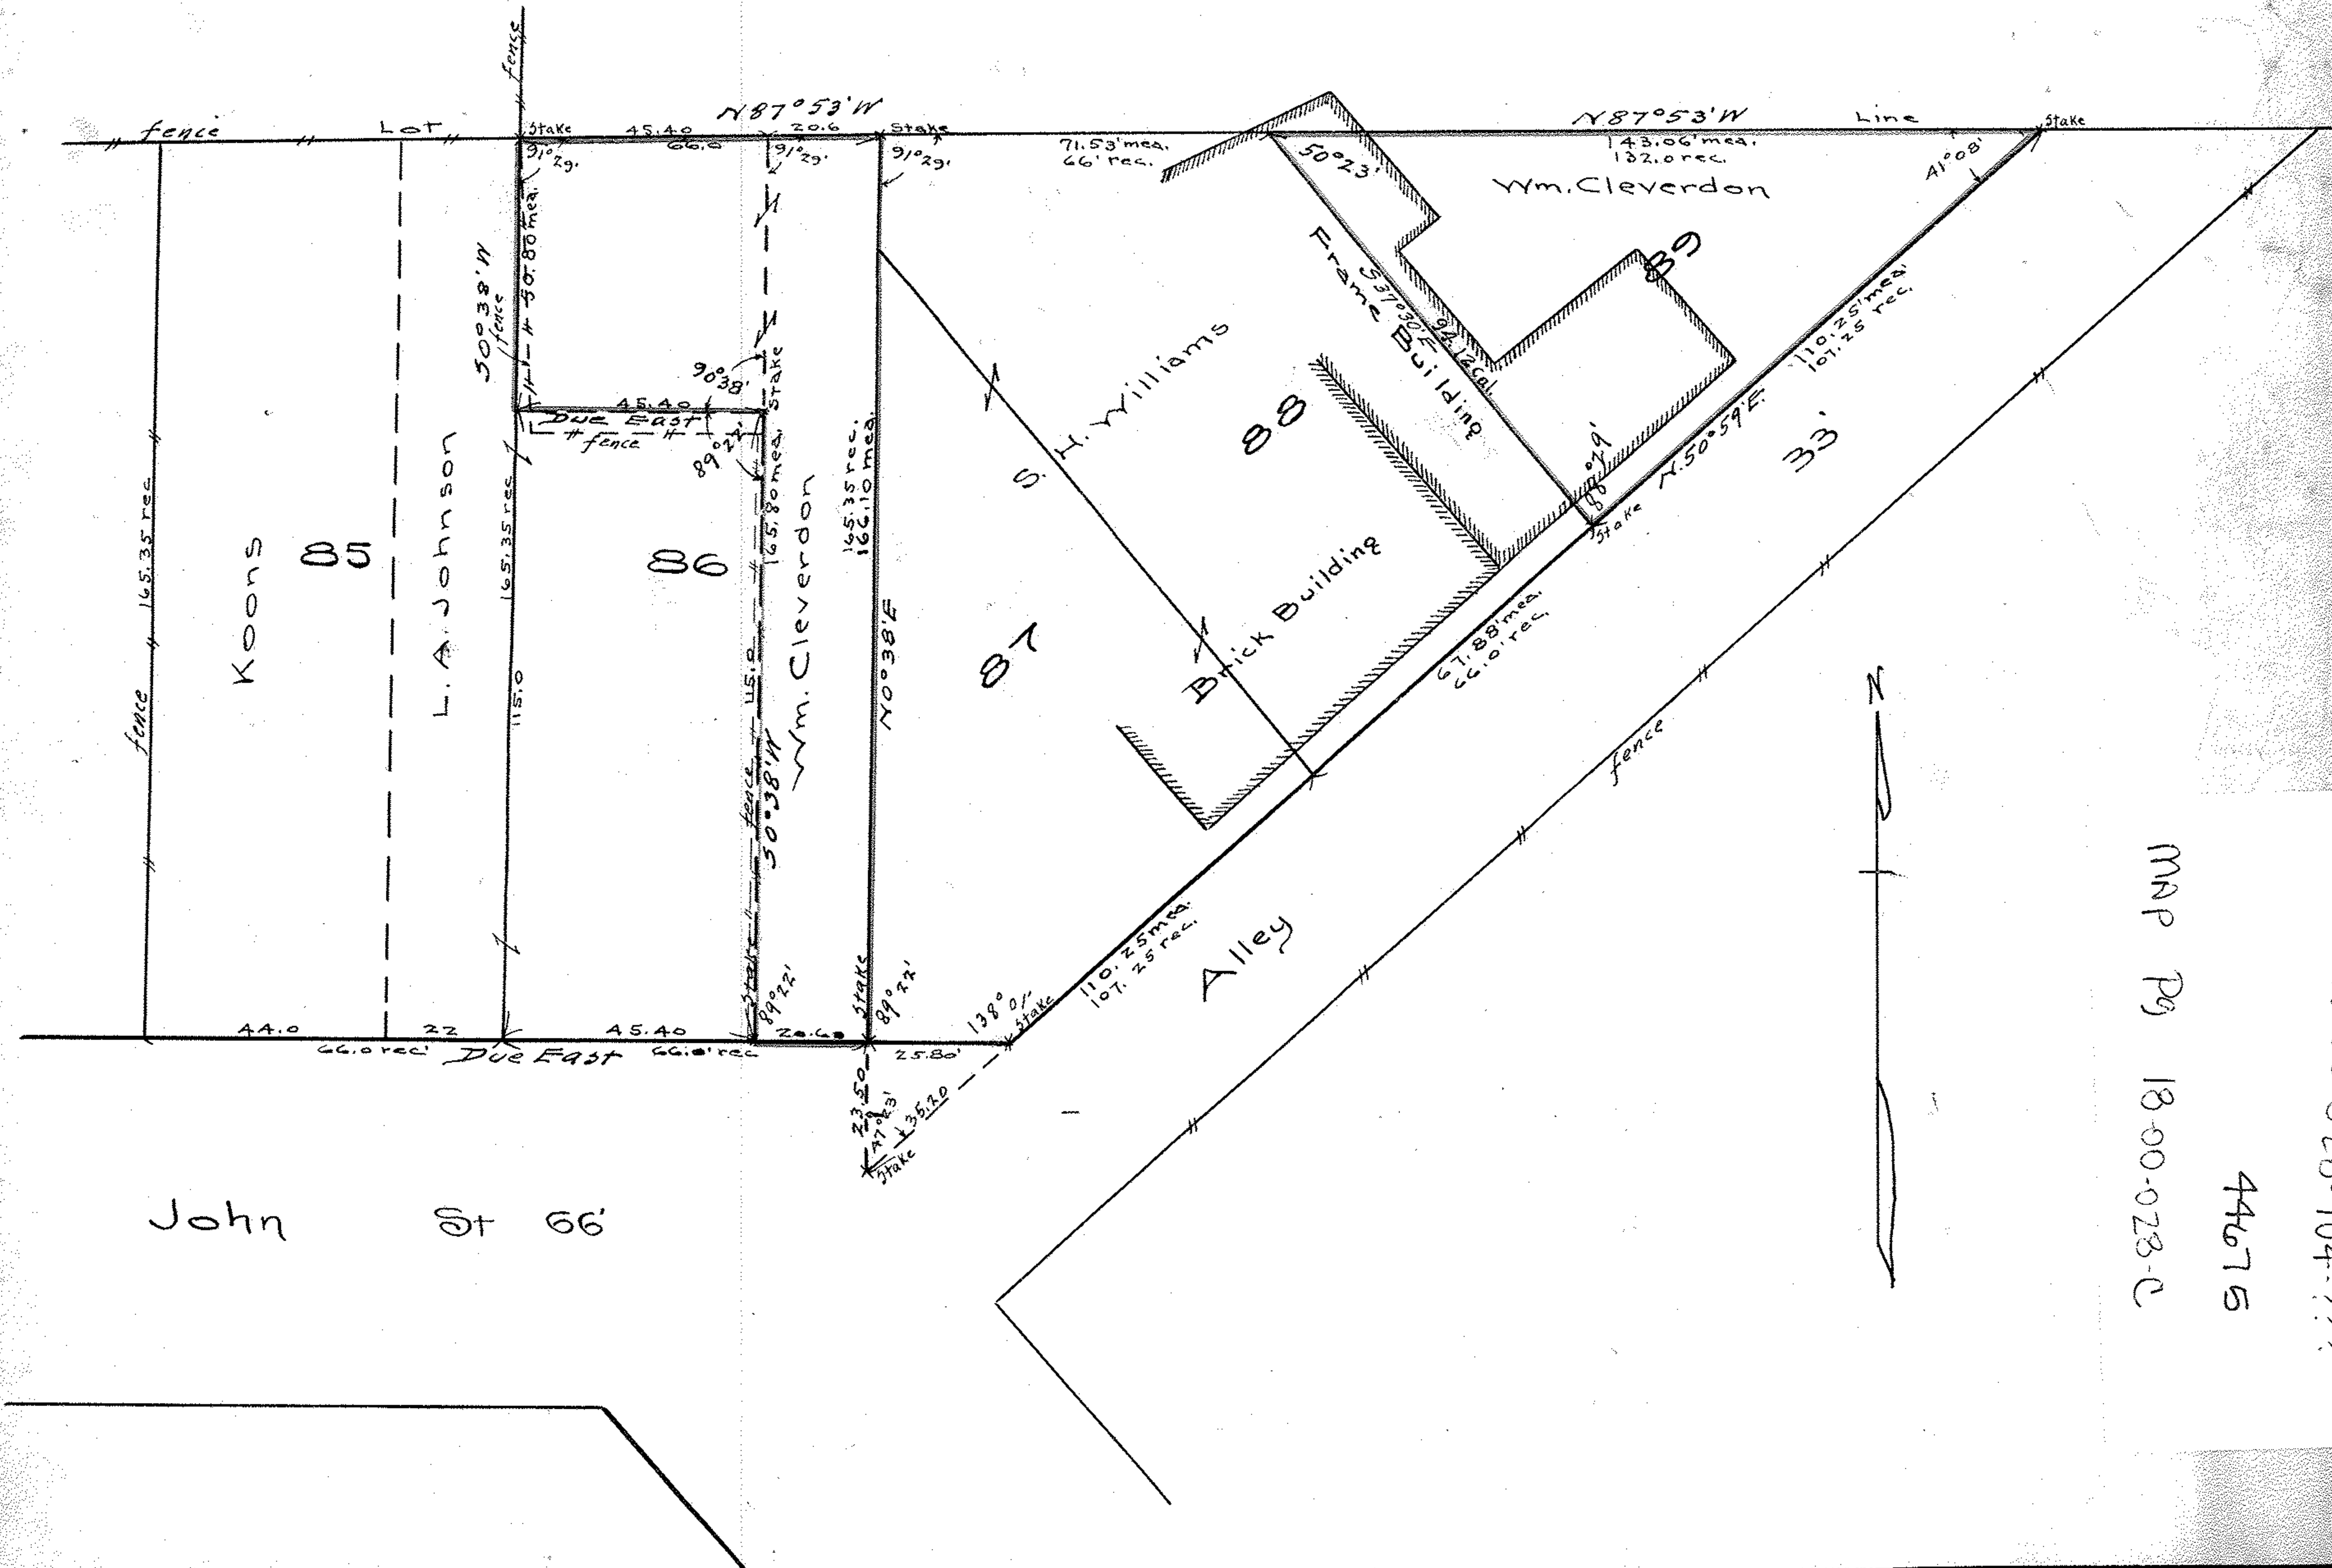

PPN 18-00-028-104-???
 44675
 MAP P9 18-00-028-C