

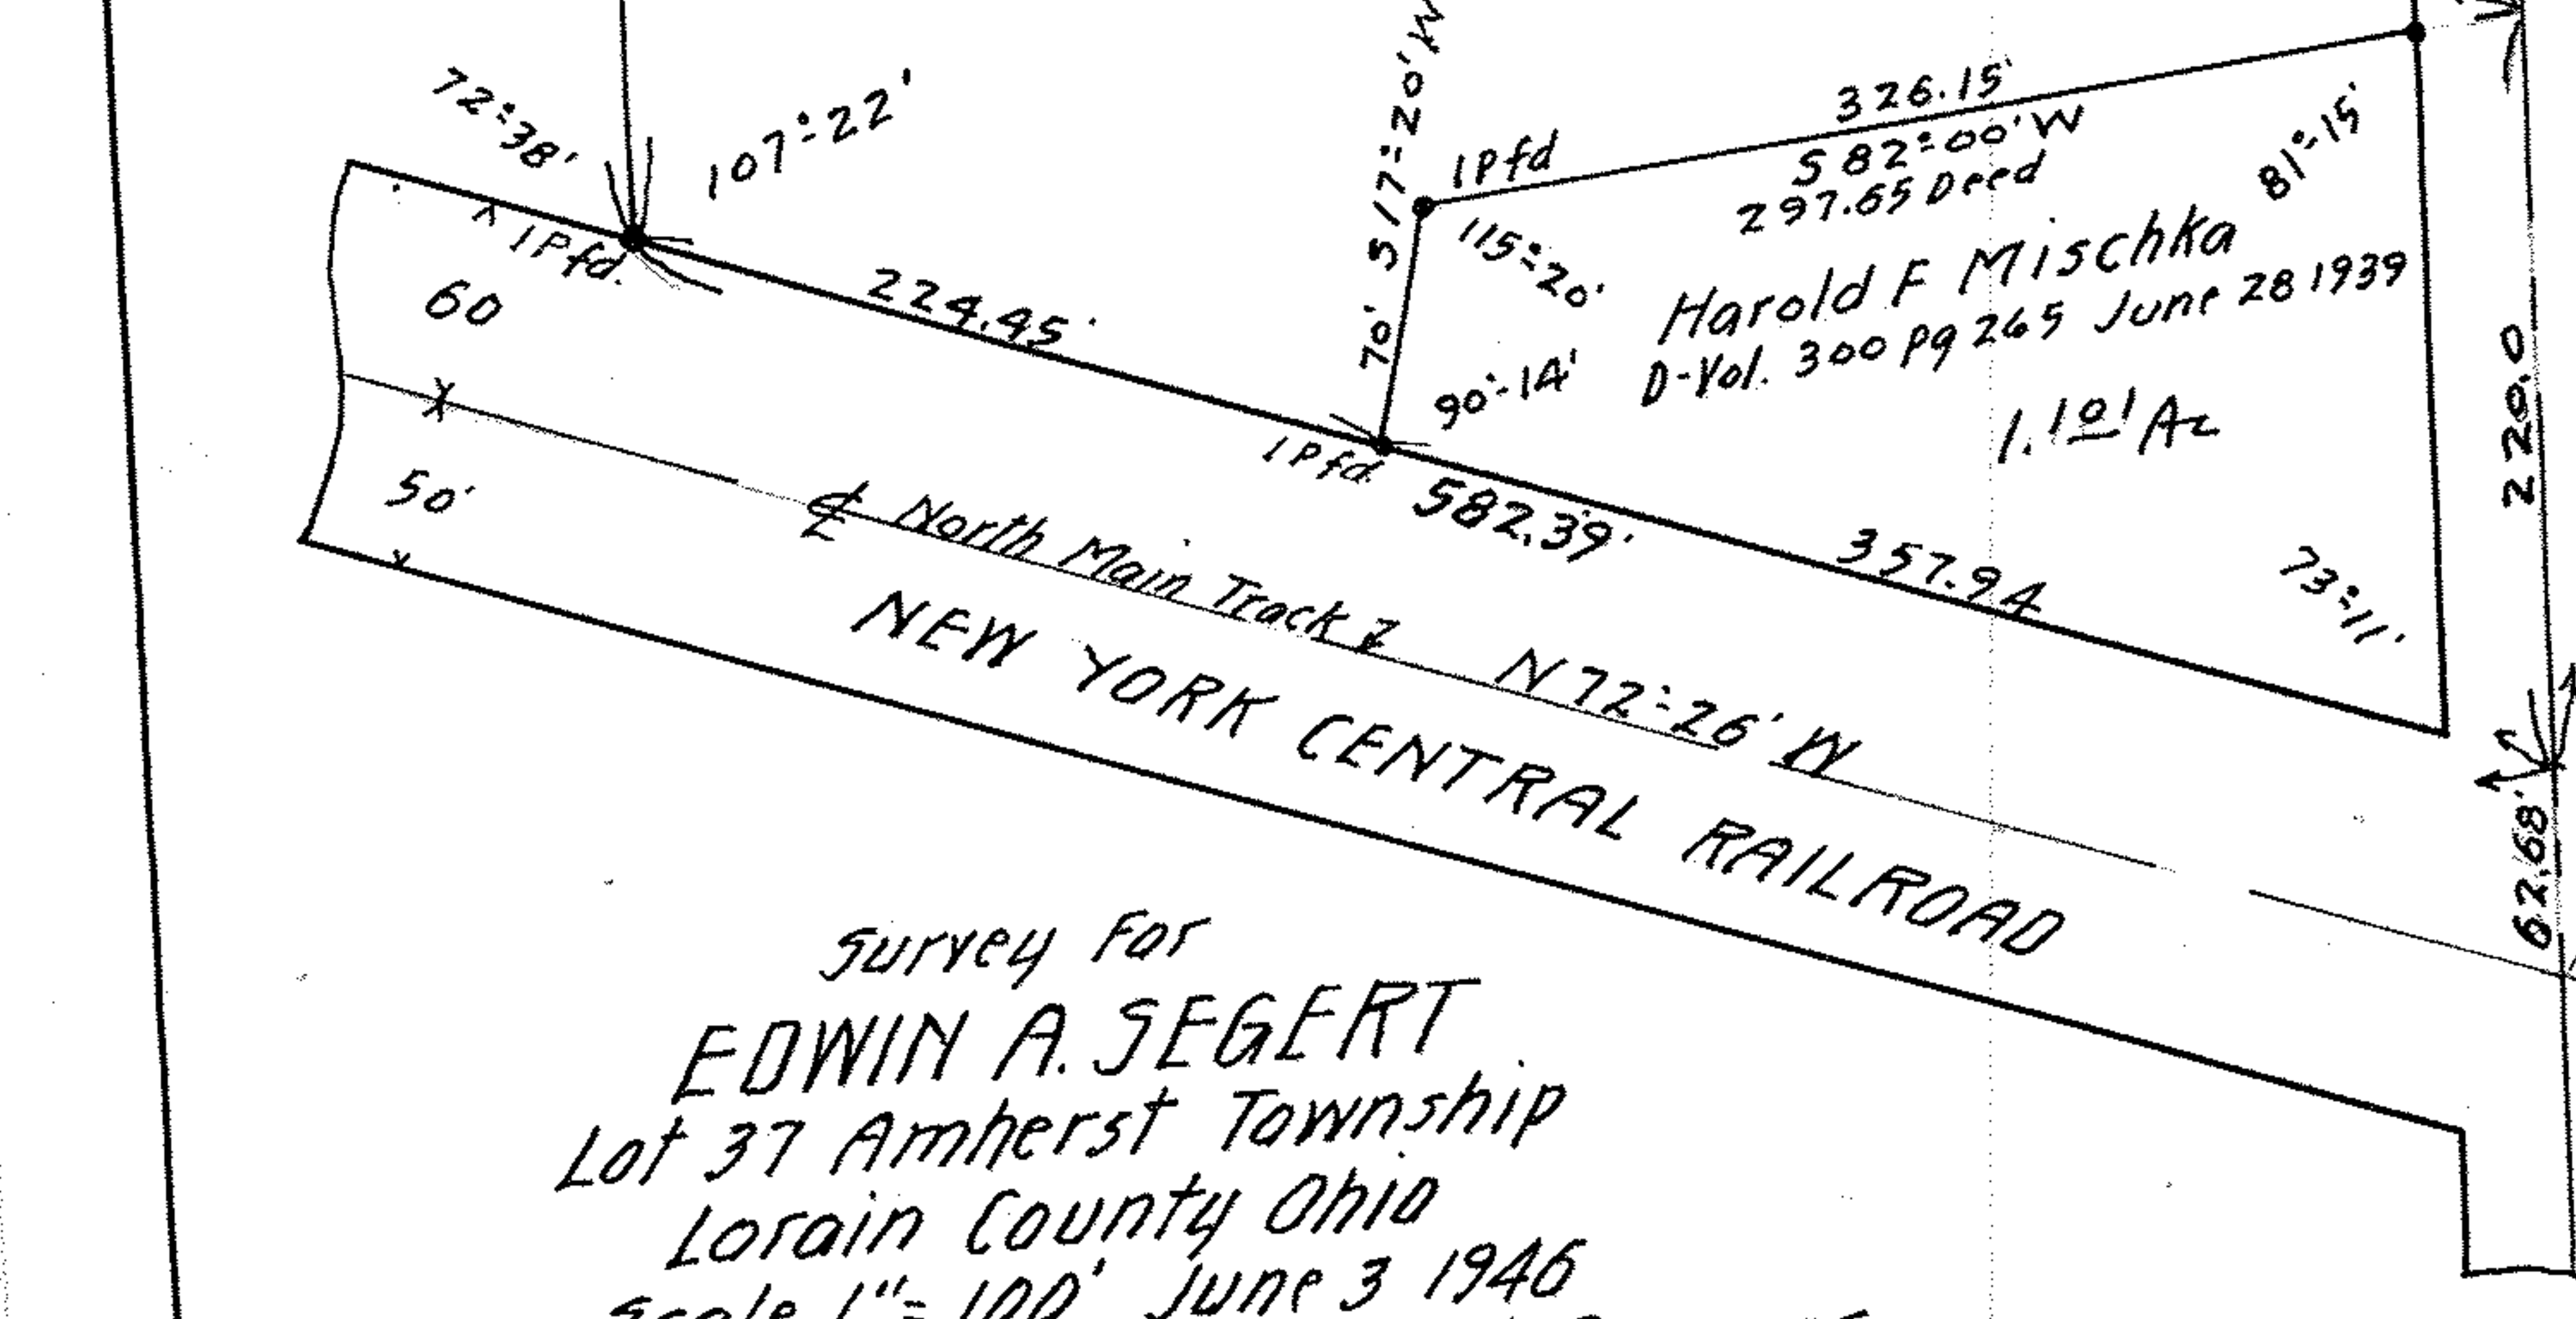
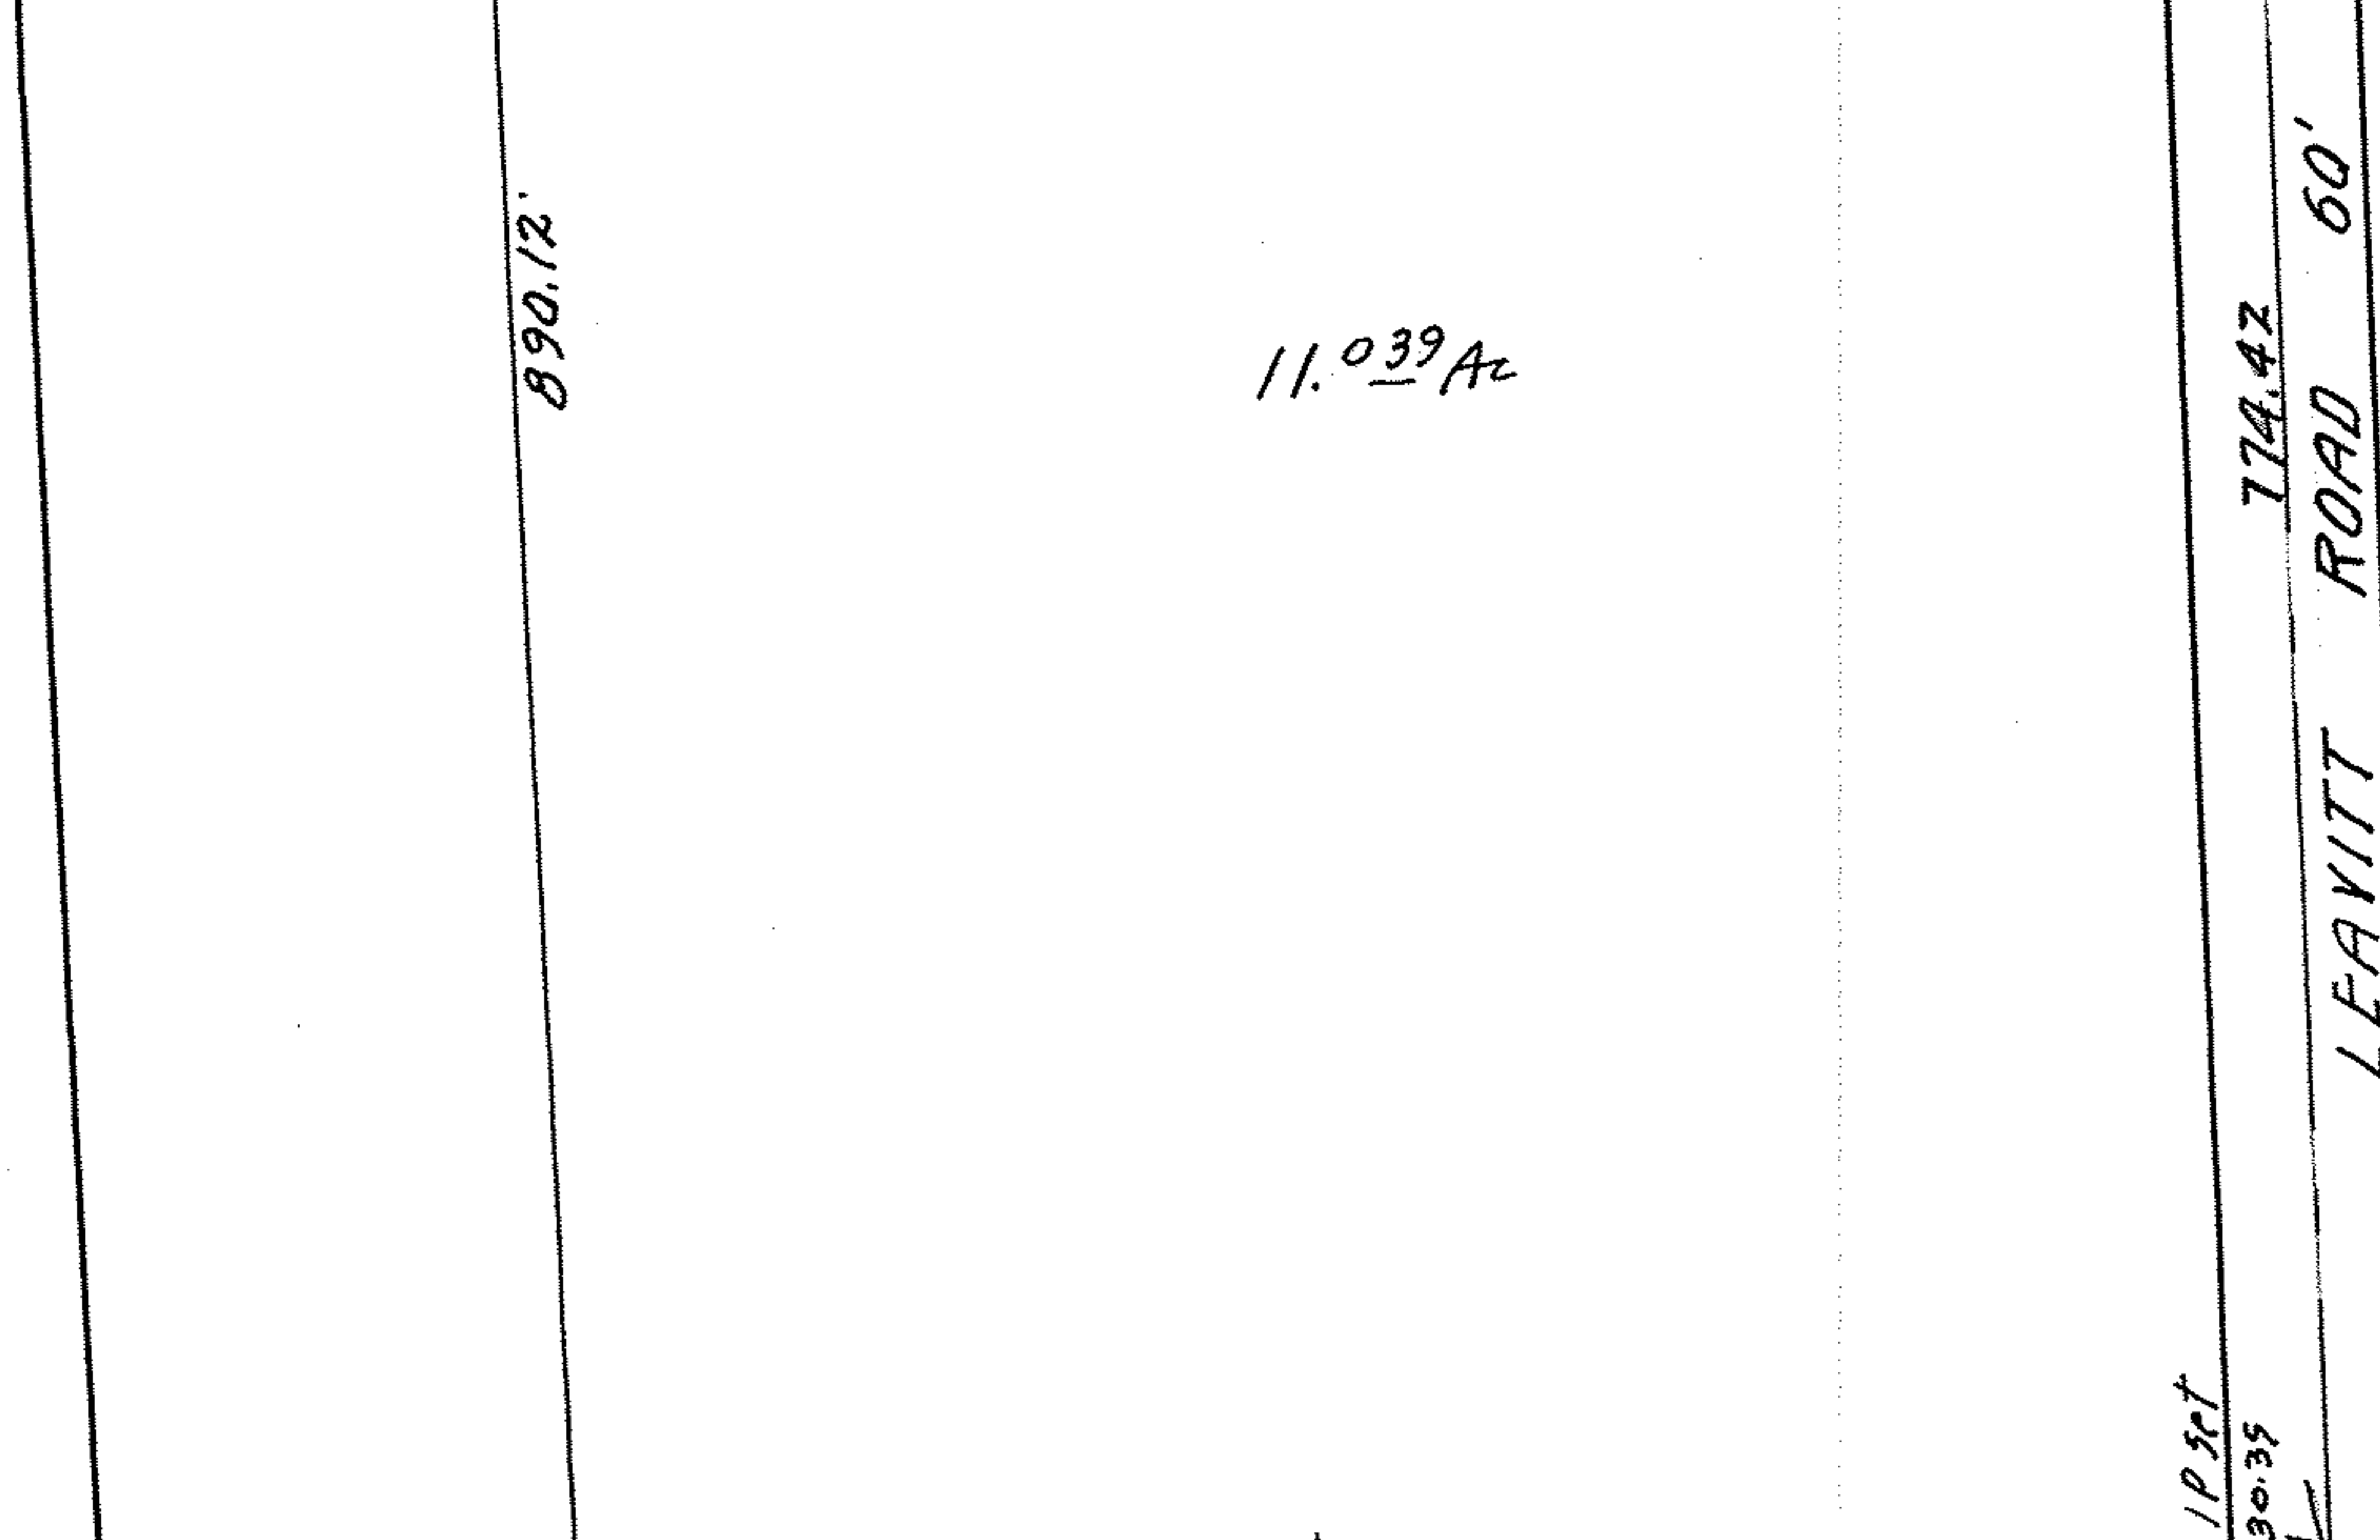
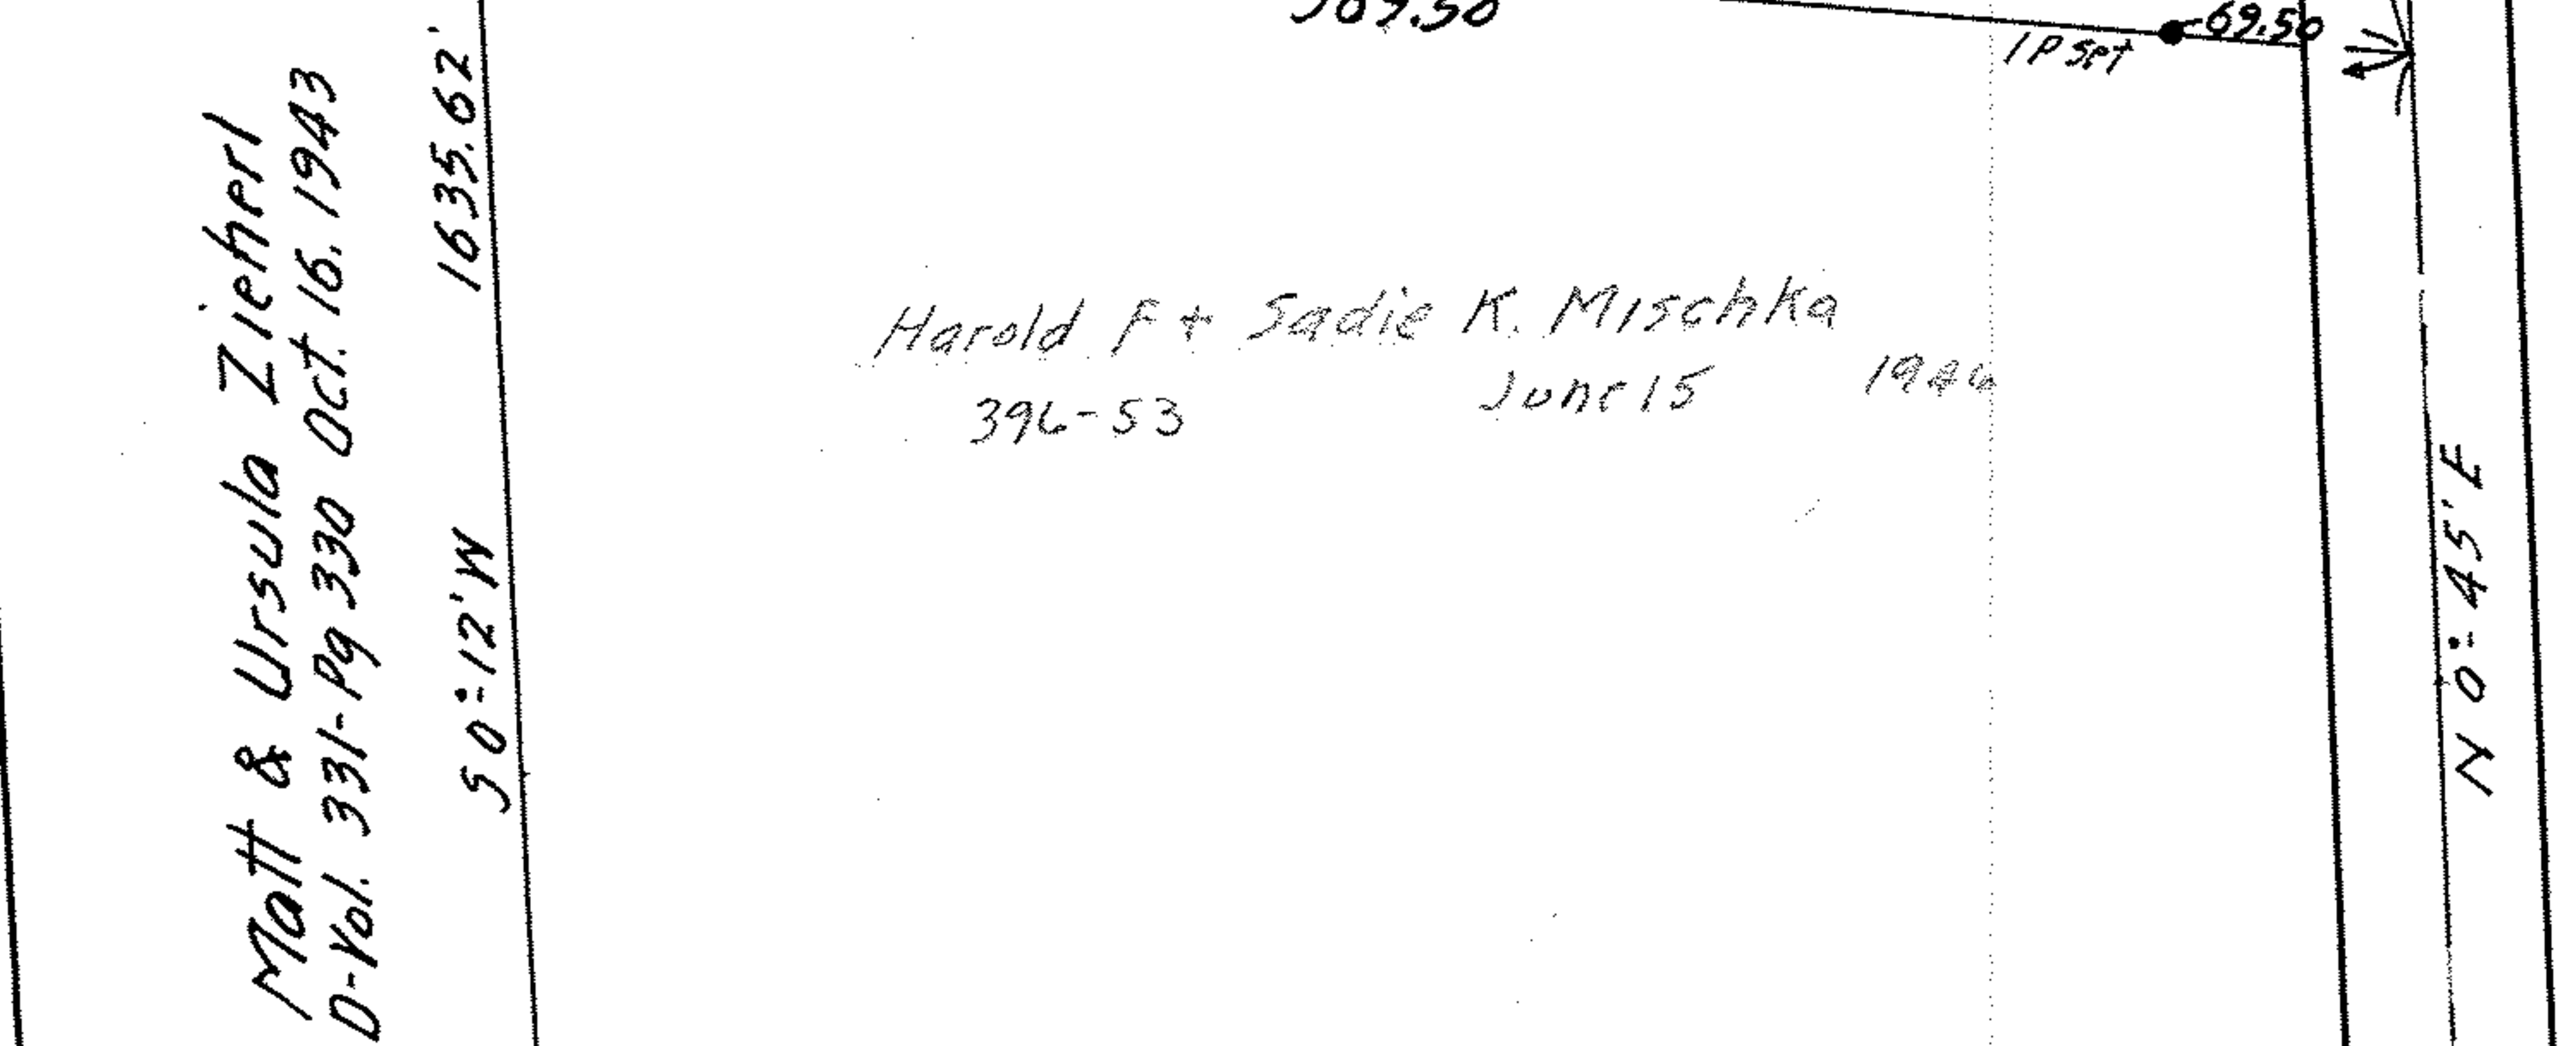
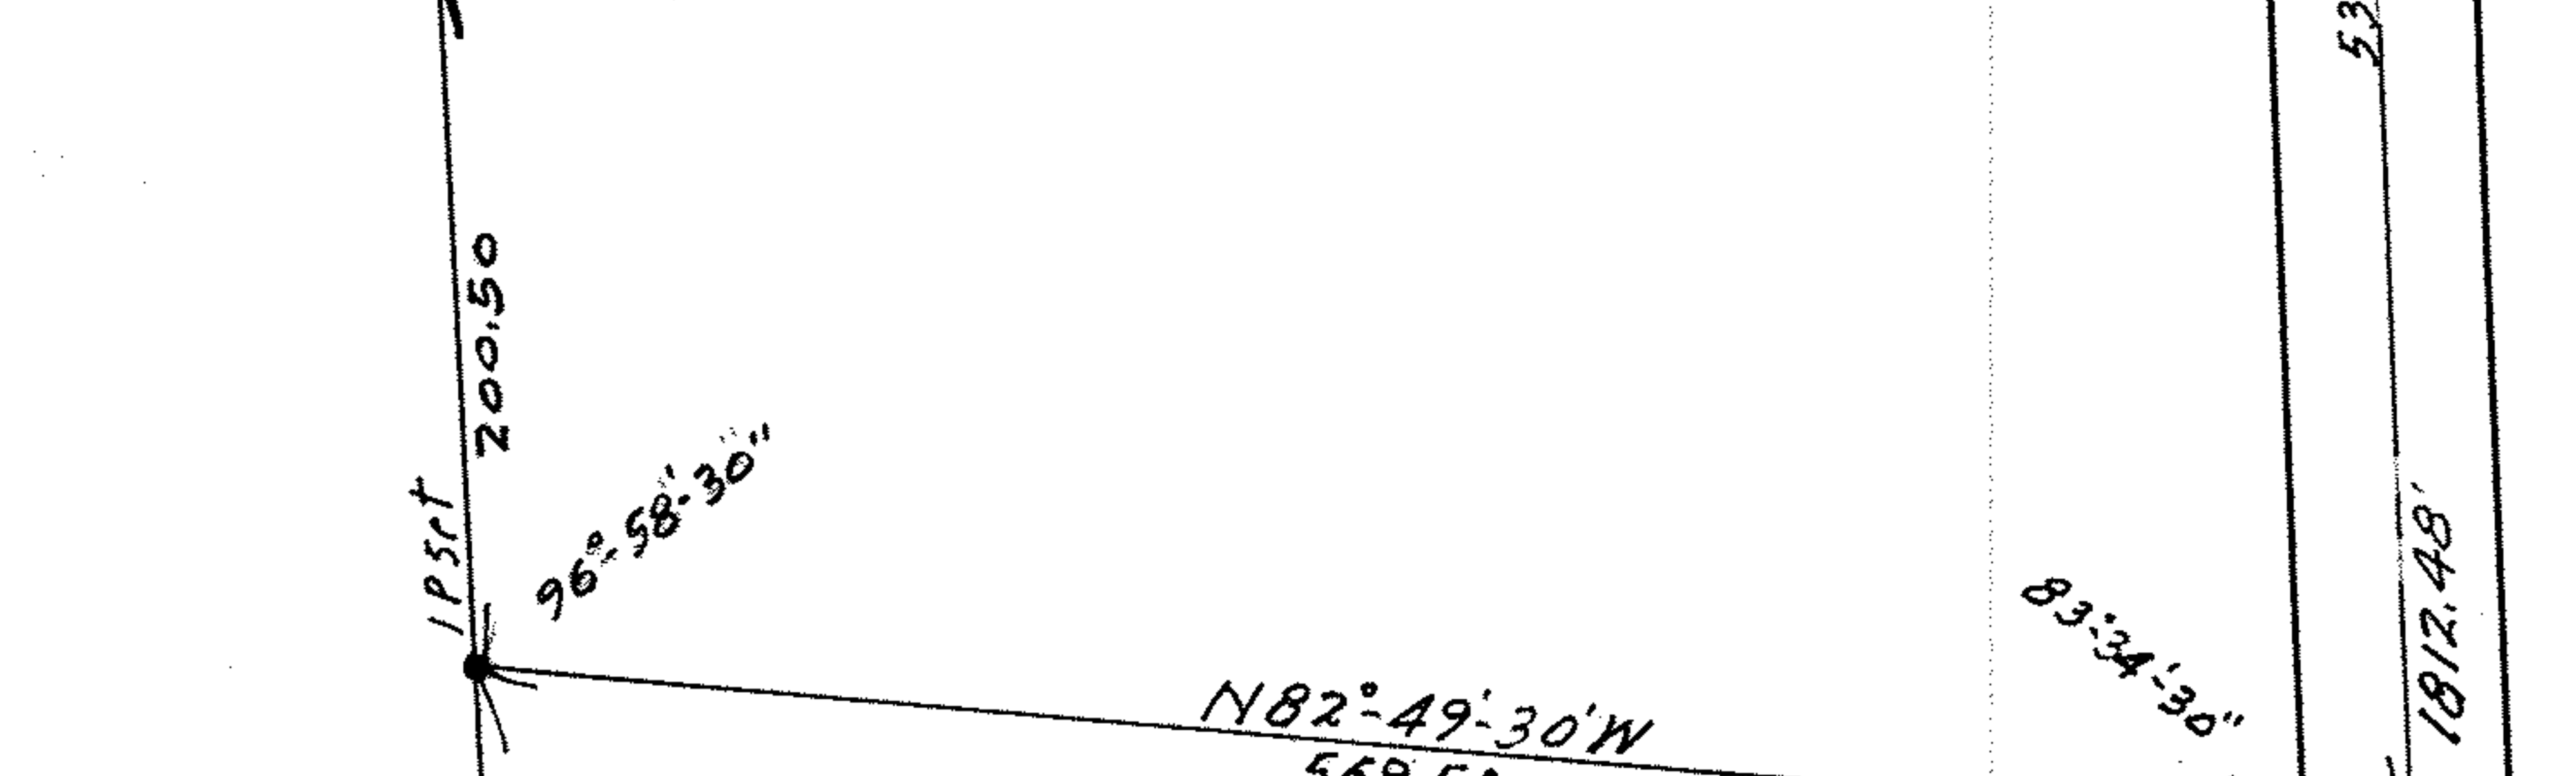


PARK AVE 60' 573.40 N89°52'E 308.03

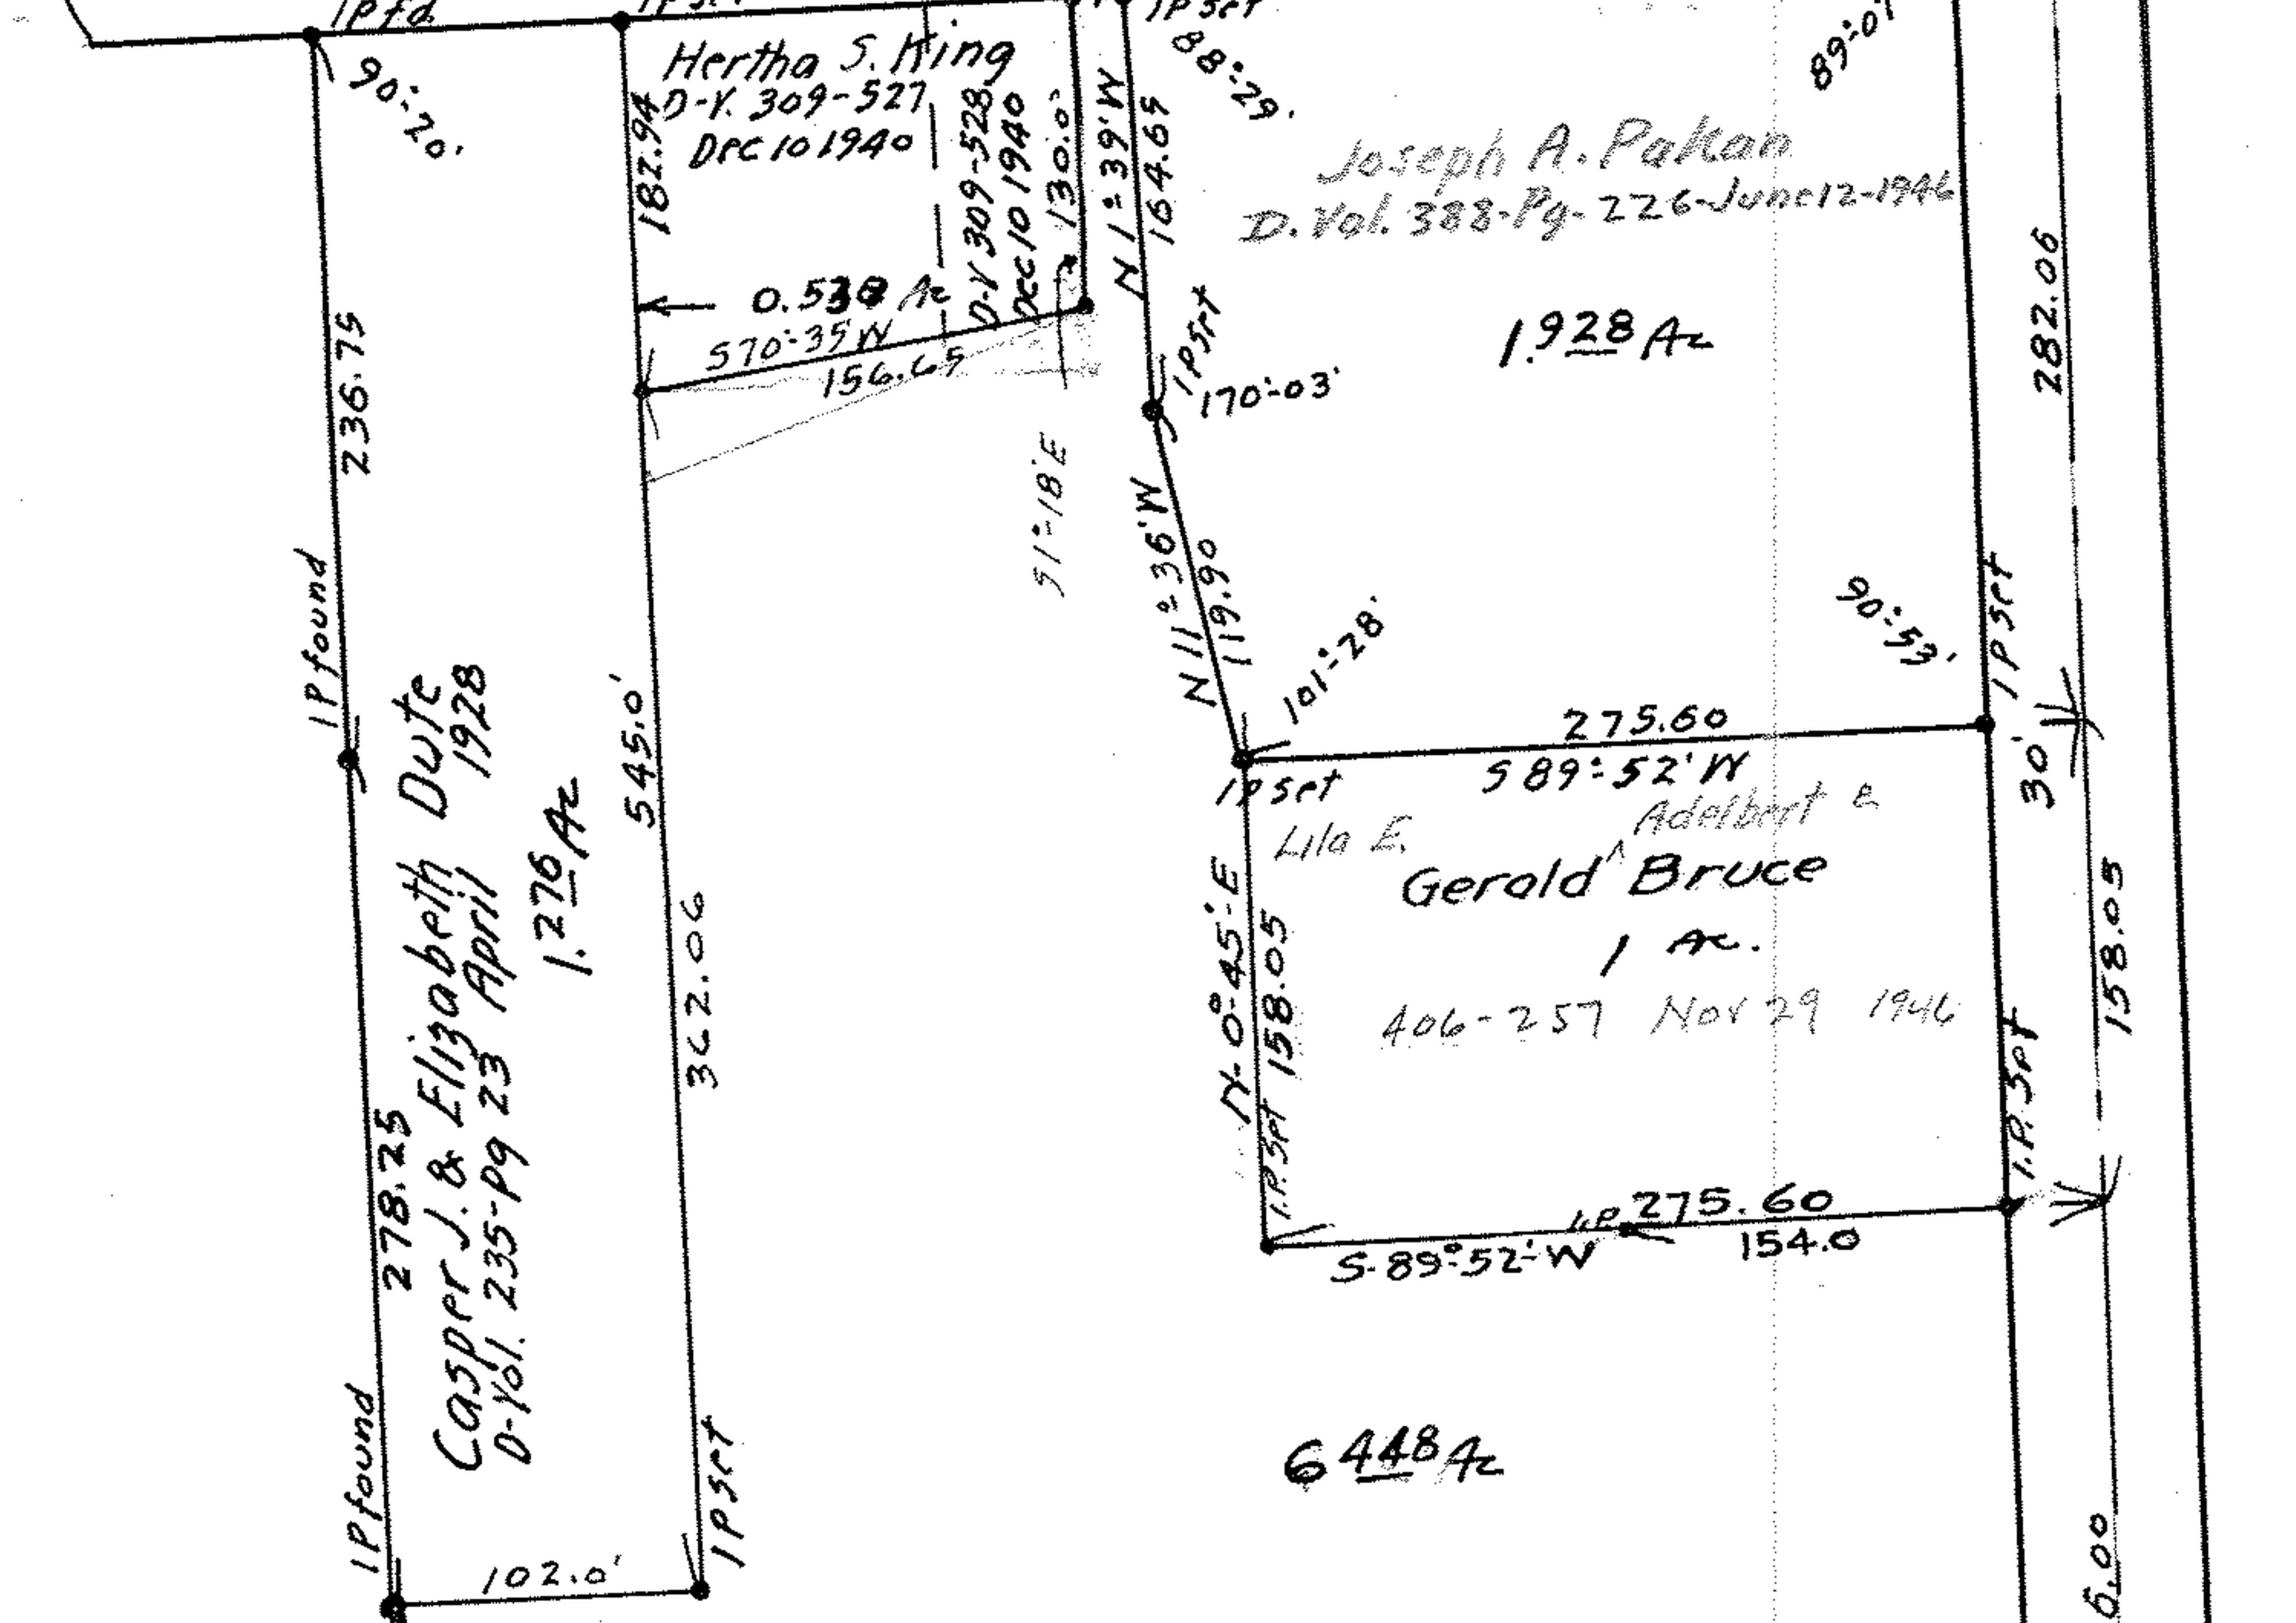

Survey for
EDWIN A. SEGERT
Lot 37 Amherst Township
Lorain County Ohio
Scale 1" = 100' June 3 1946
J. W. Warden, Registered Surveyor.
Revised July 17 1946.

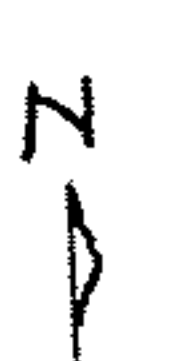

22-0874-2