


700110

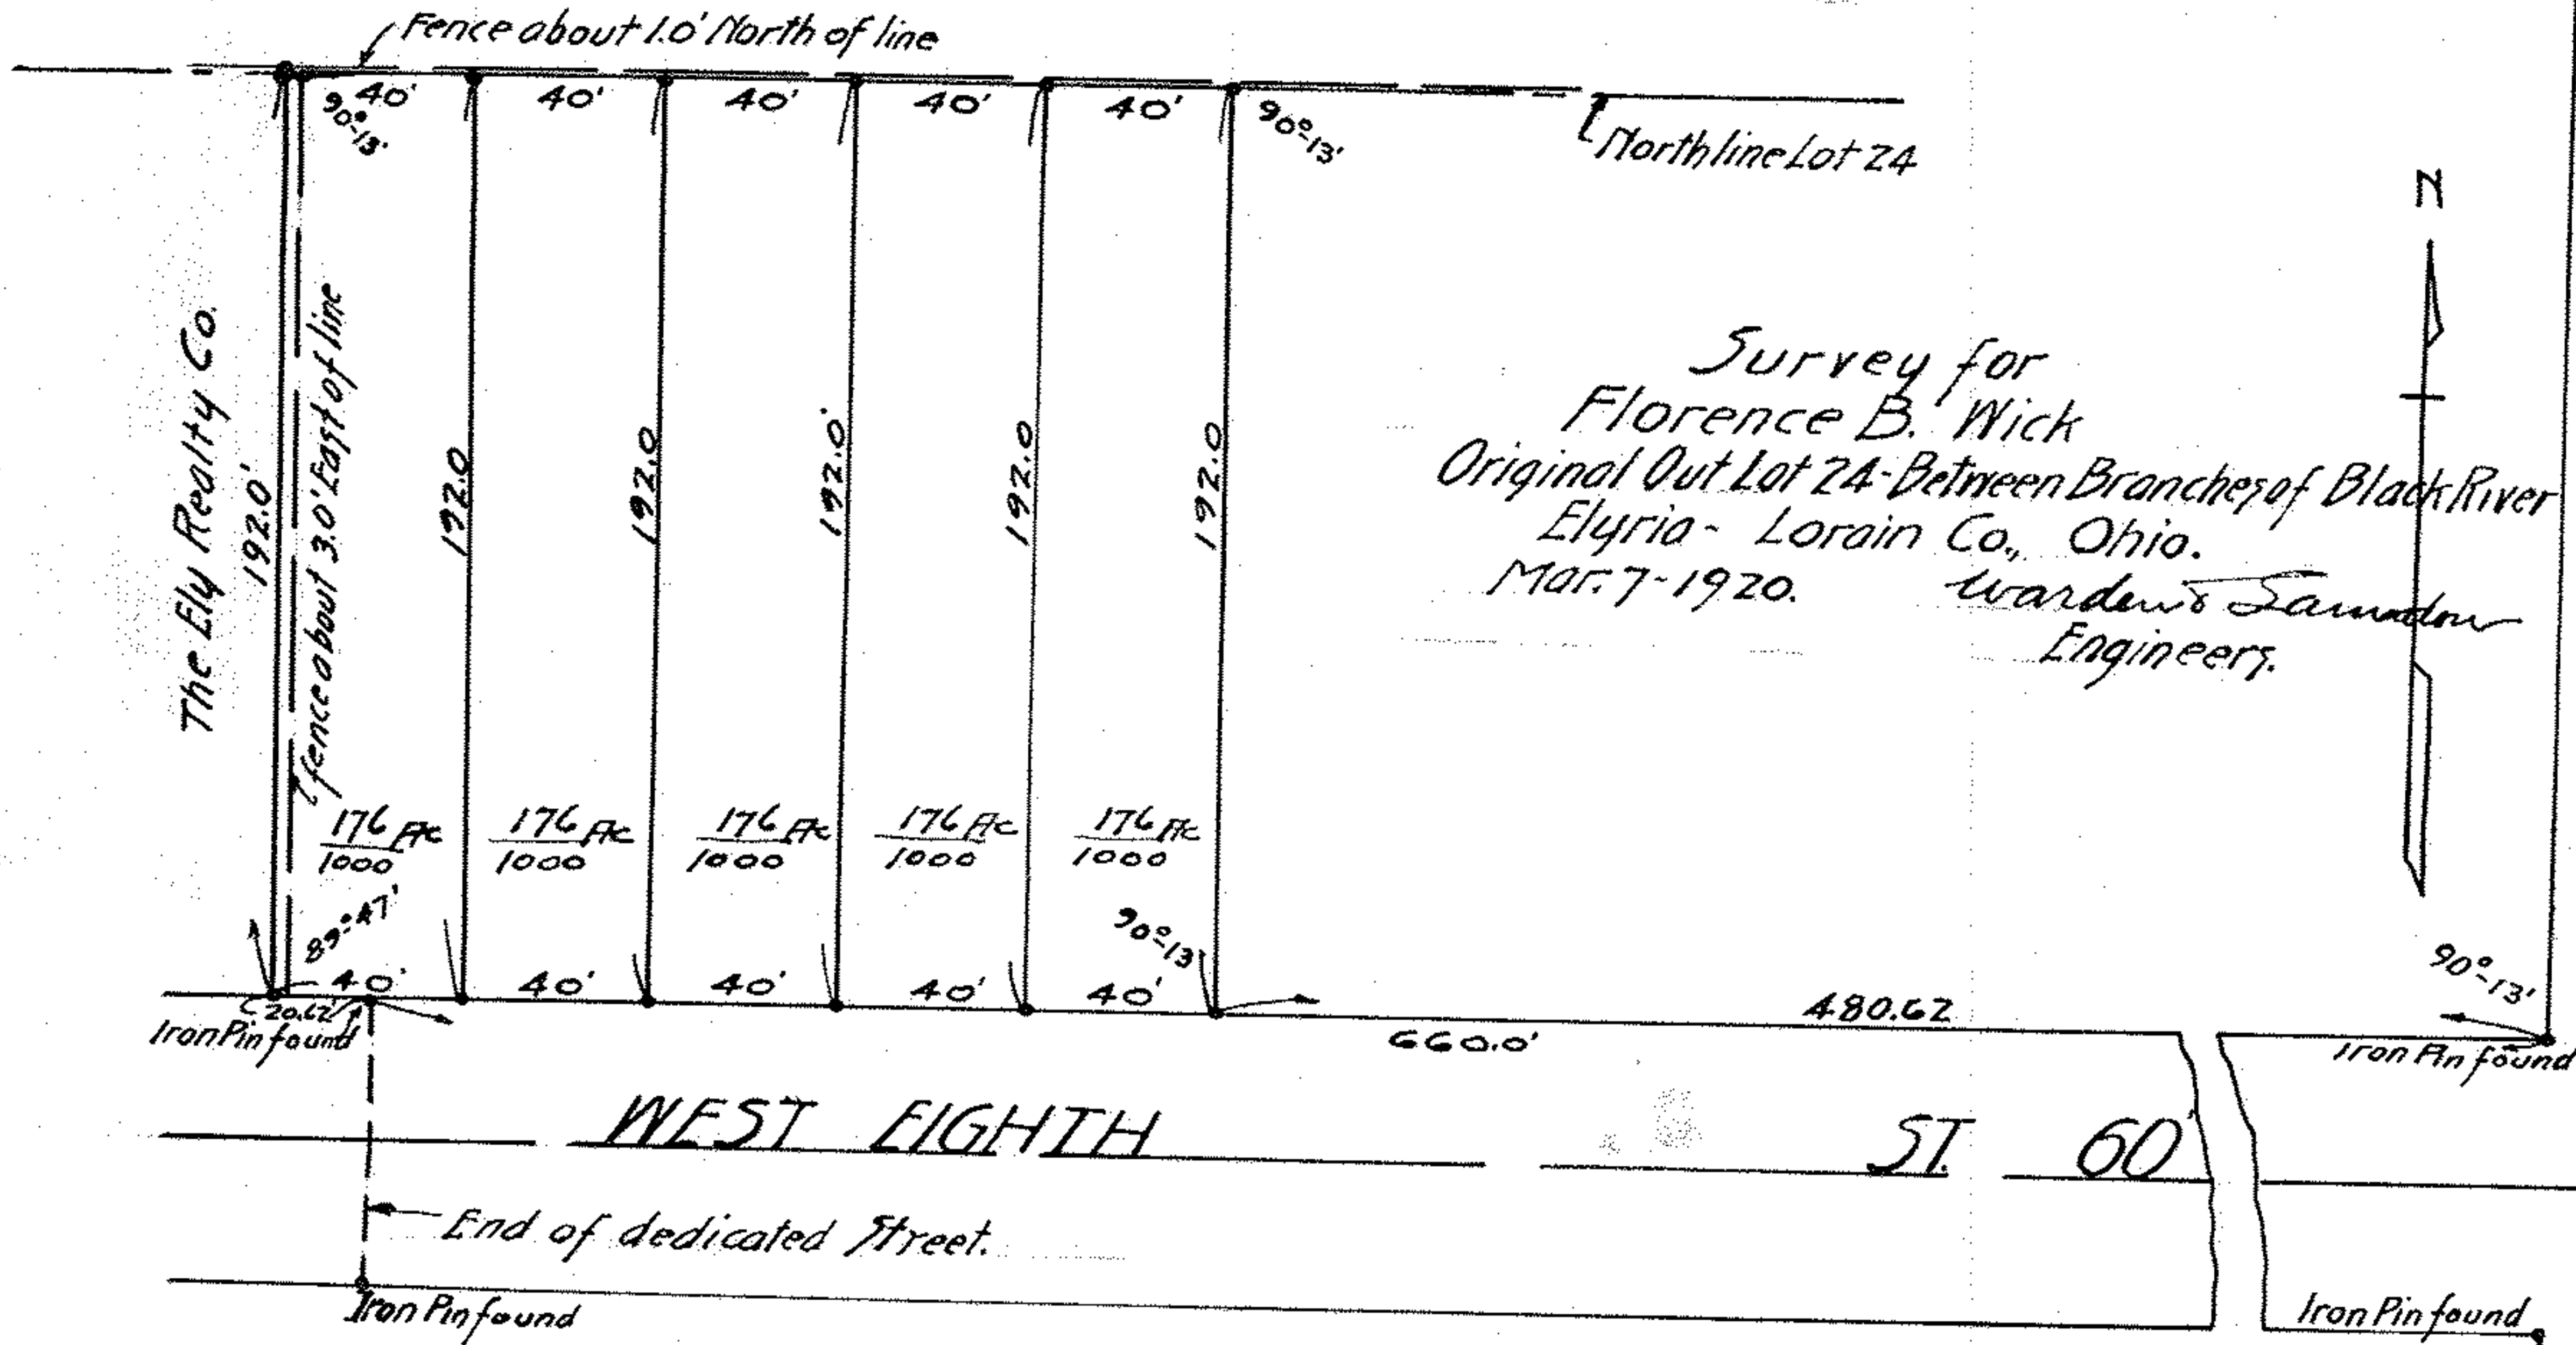

Survey for
 Florence B. Wick
 Original Out Lot 24 - Between Branches of Black River
 Elyria - Lorain Co., Ohio.
 Mar. 7 - 1920. Warden & Sawdon
 Engineers.

PPN 06-26-025-101-???

Map PG 6-137

44680