


01-80-001-104-054,053

44689

Dorothy F. Burke

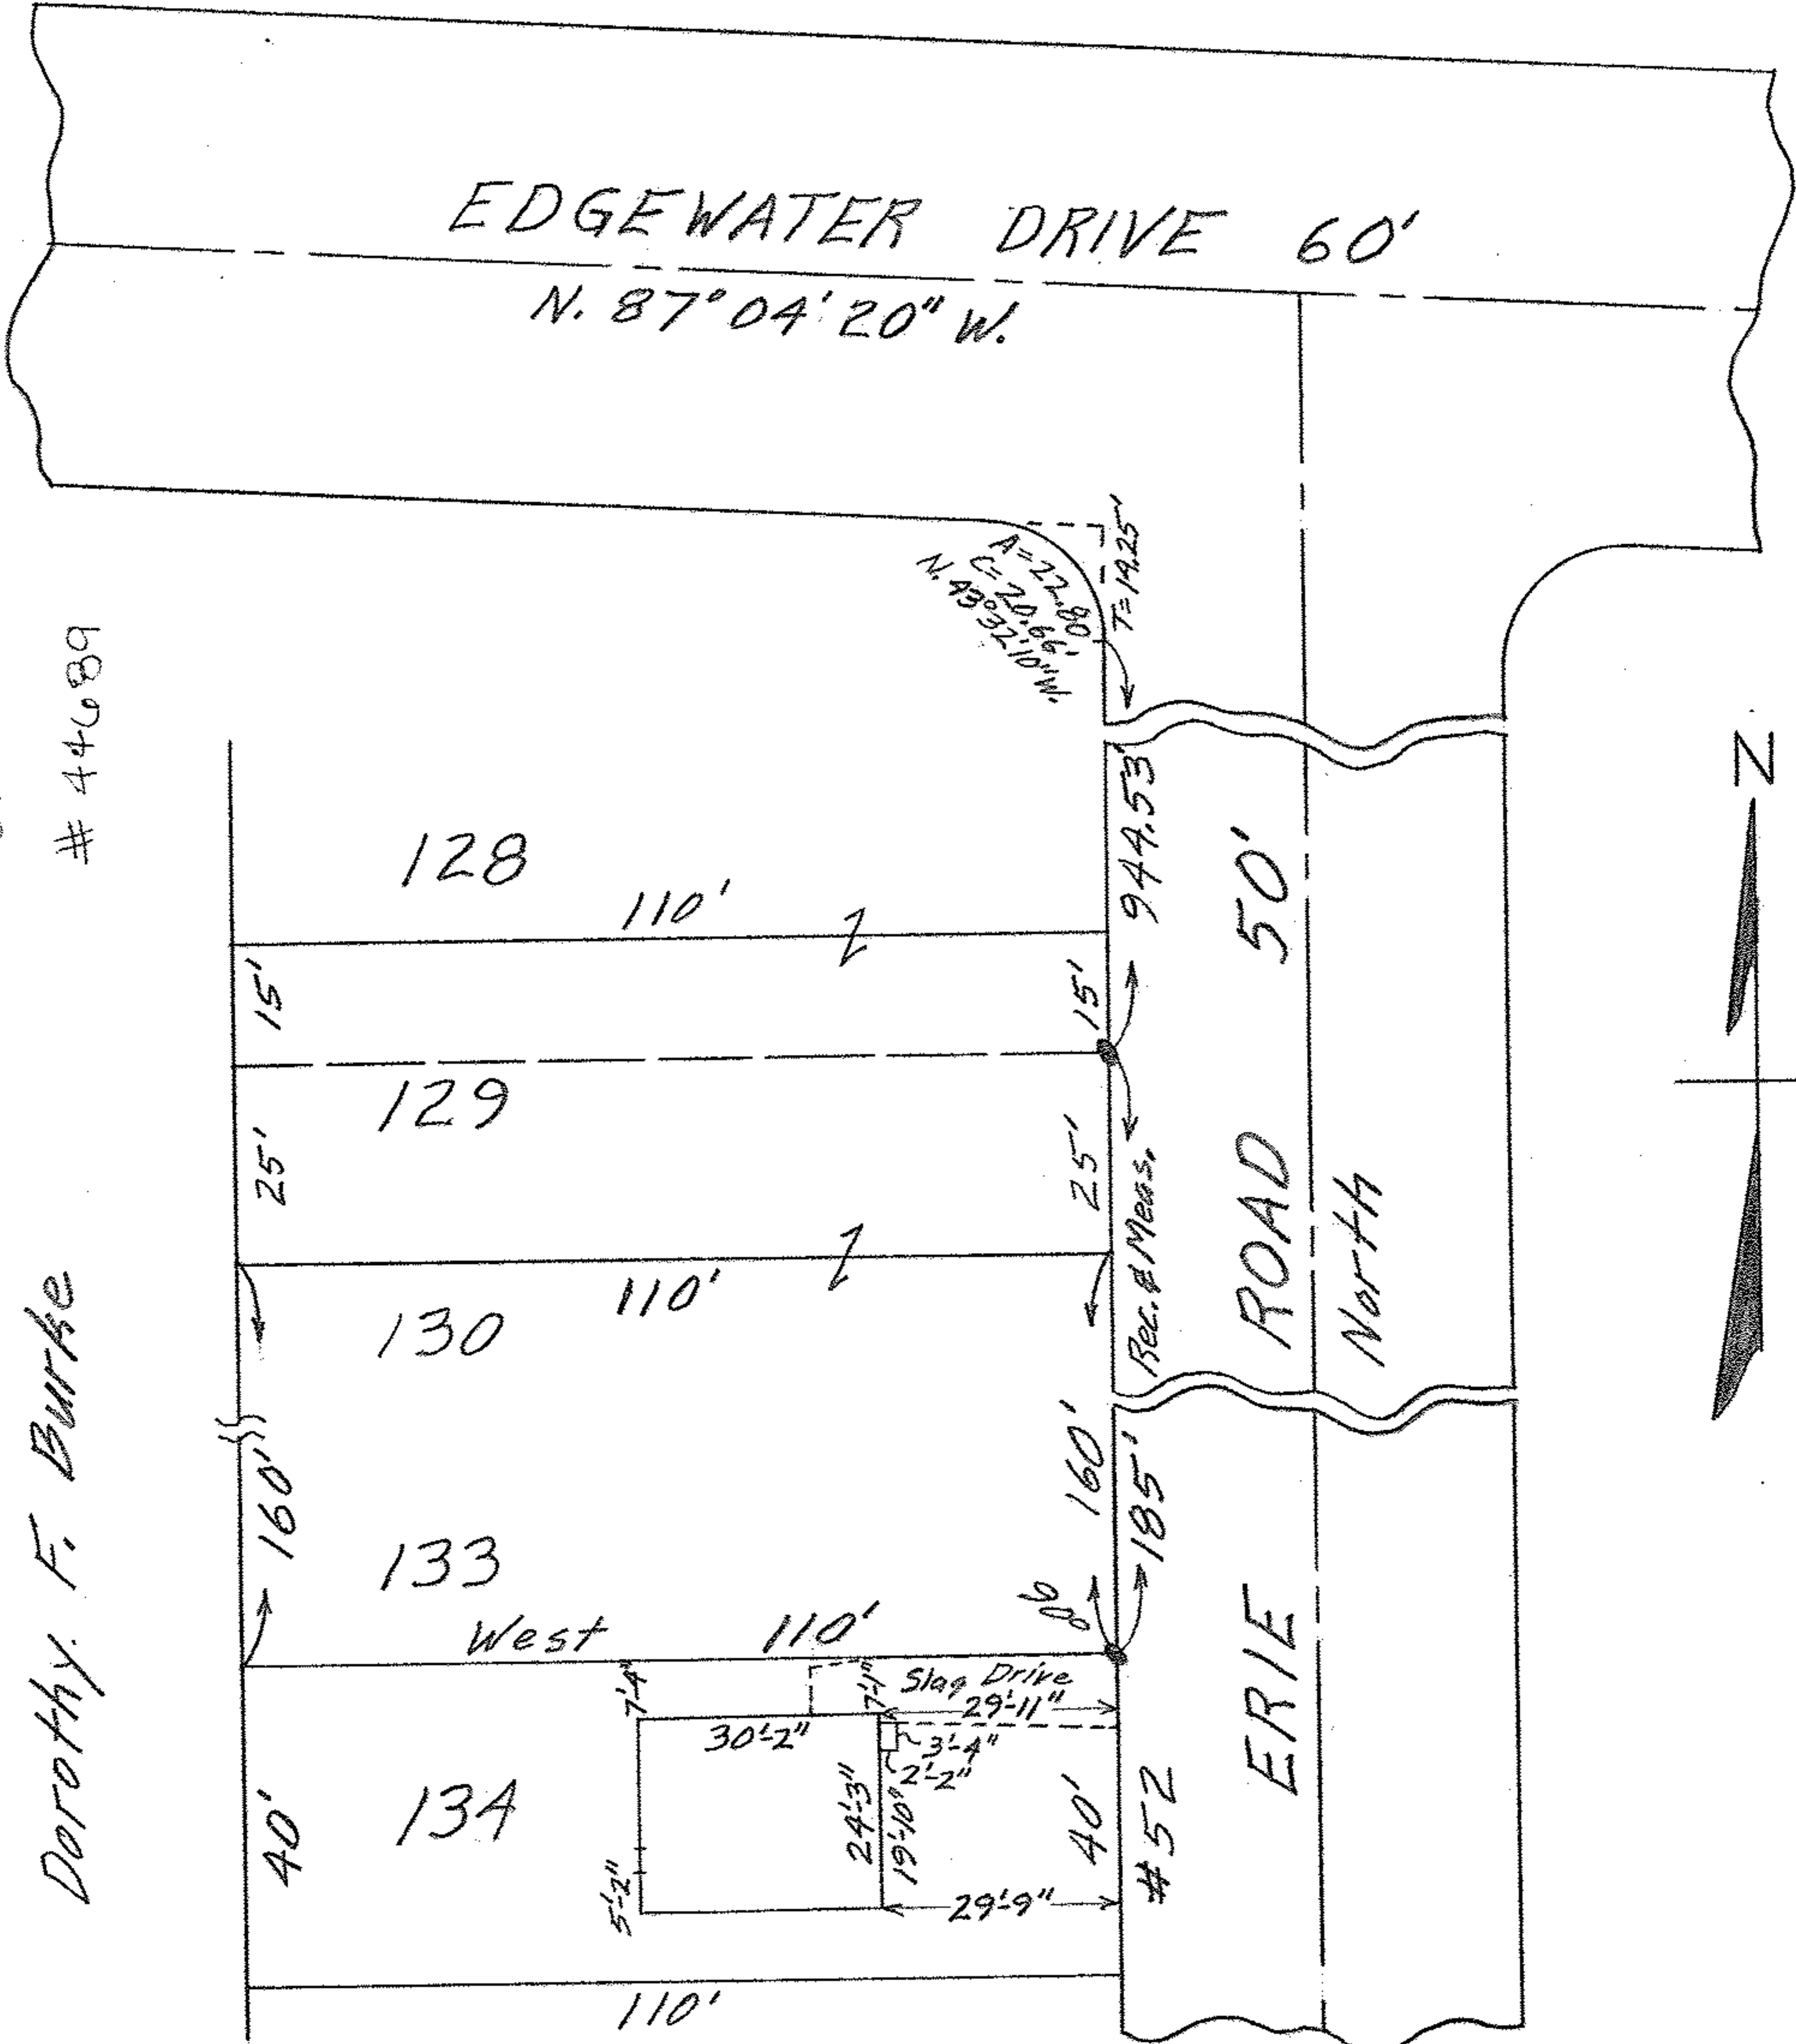

MAP OF SUB-LOT NO. 134

ELBERTA BEACH SUB'N. Vol. 10 Pgs. 13 & 14

ORIG. LOT NO. 1 BROWNHELM TWP.

VERMILION CITY - LORAIN COUNTY - OHIO

SCALE: 1" = 30' FEB. 12-1963 11:00 A.M.

Gary E. Perfound REG. SURVEYOR

BH