


01-00-001-105-034

# 44690

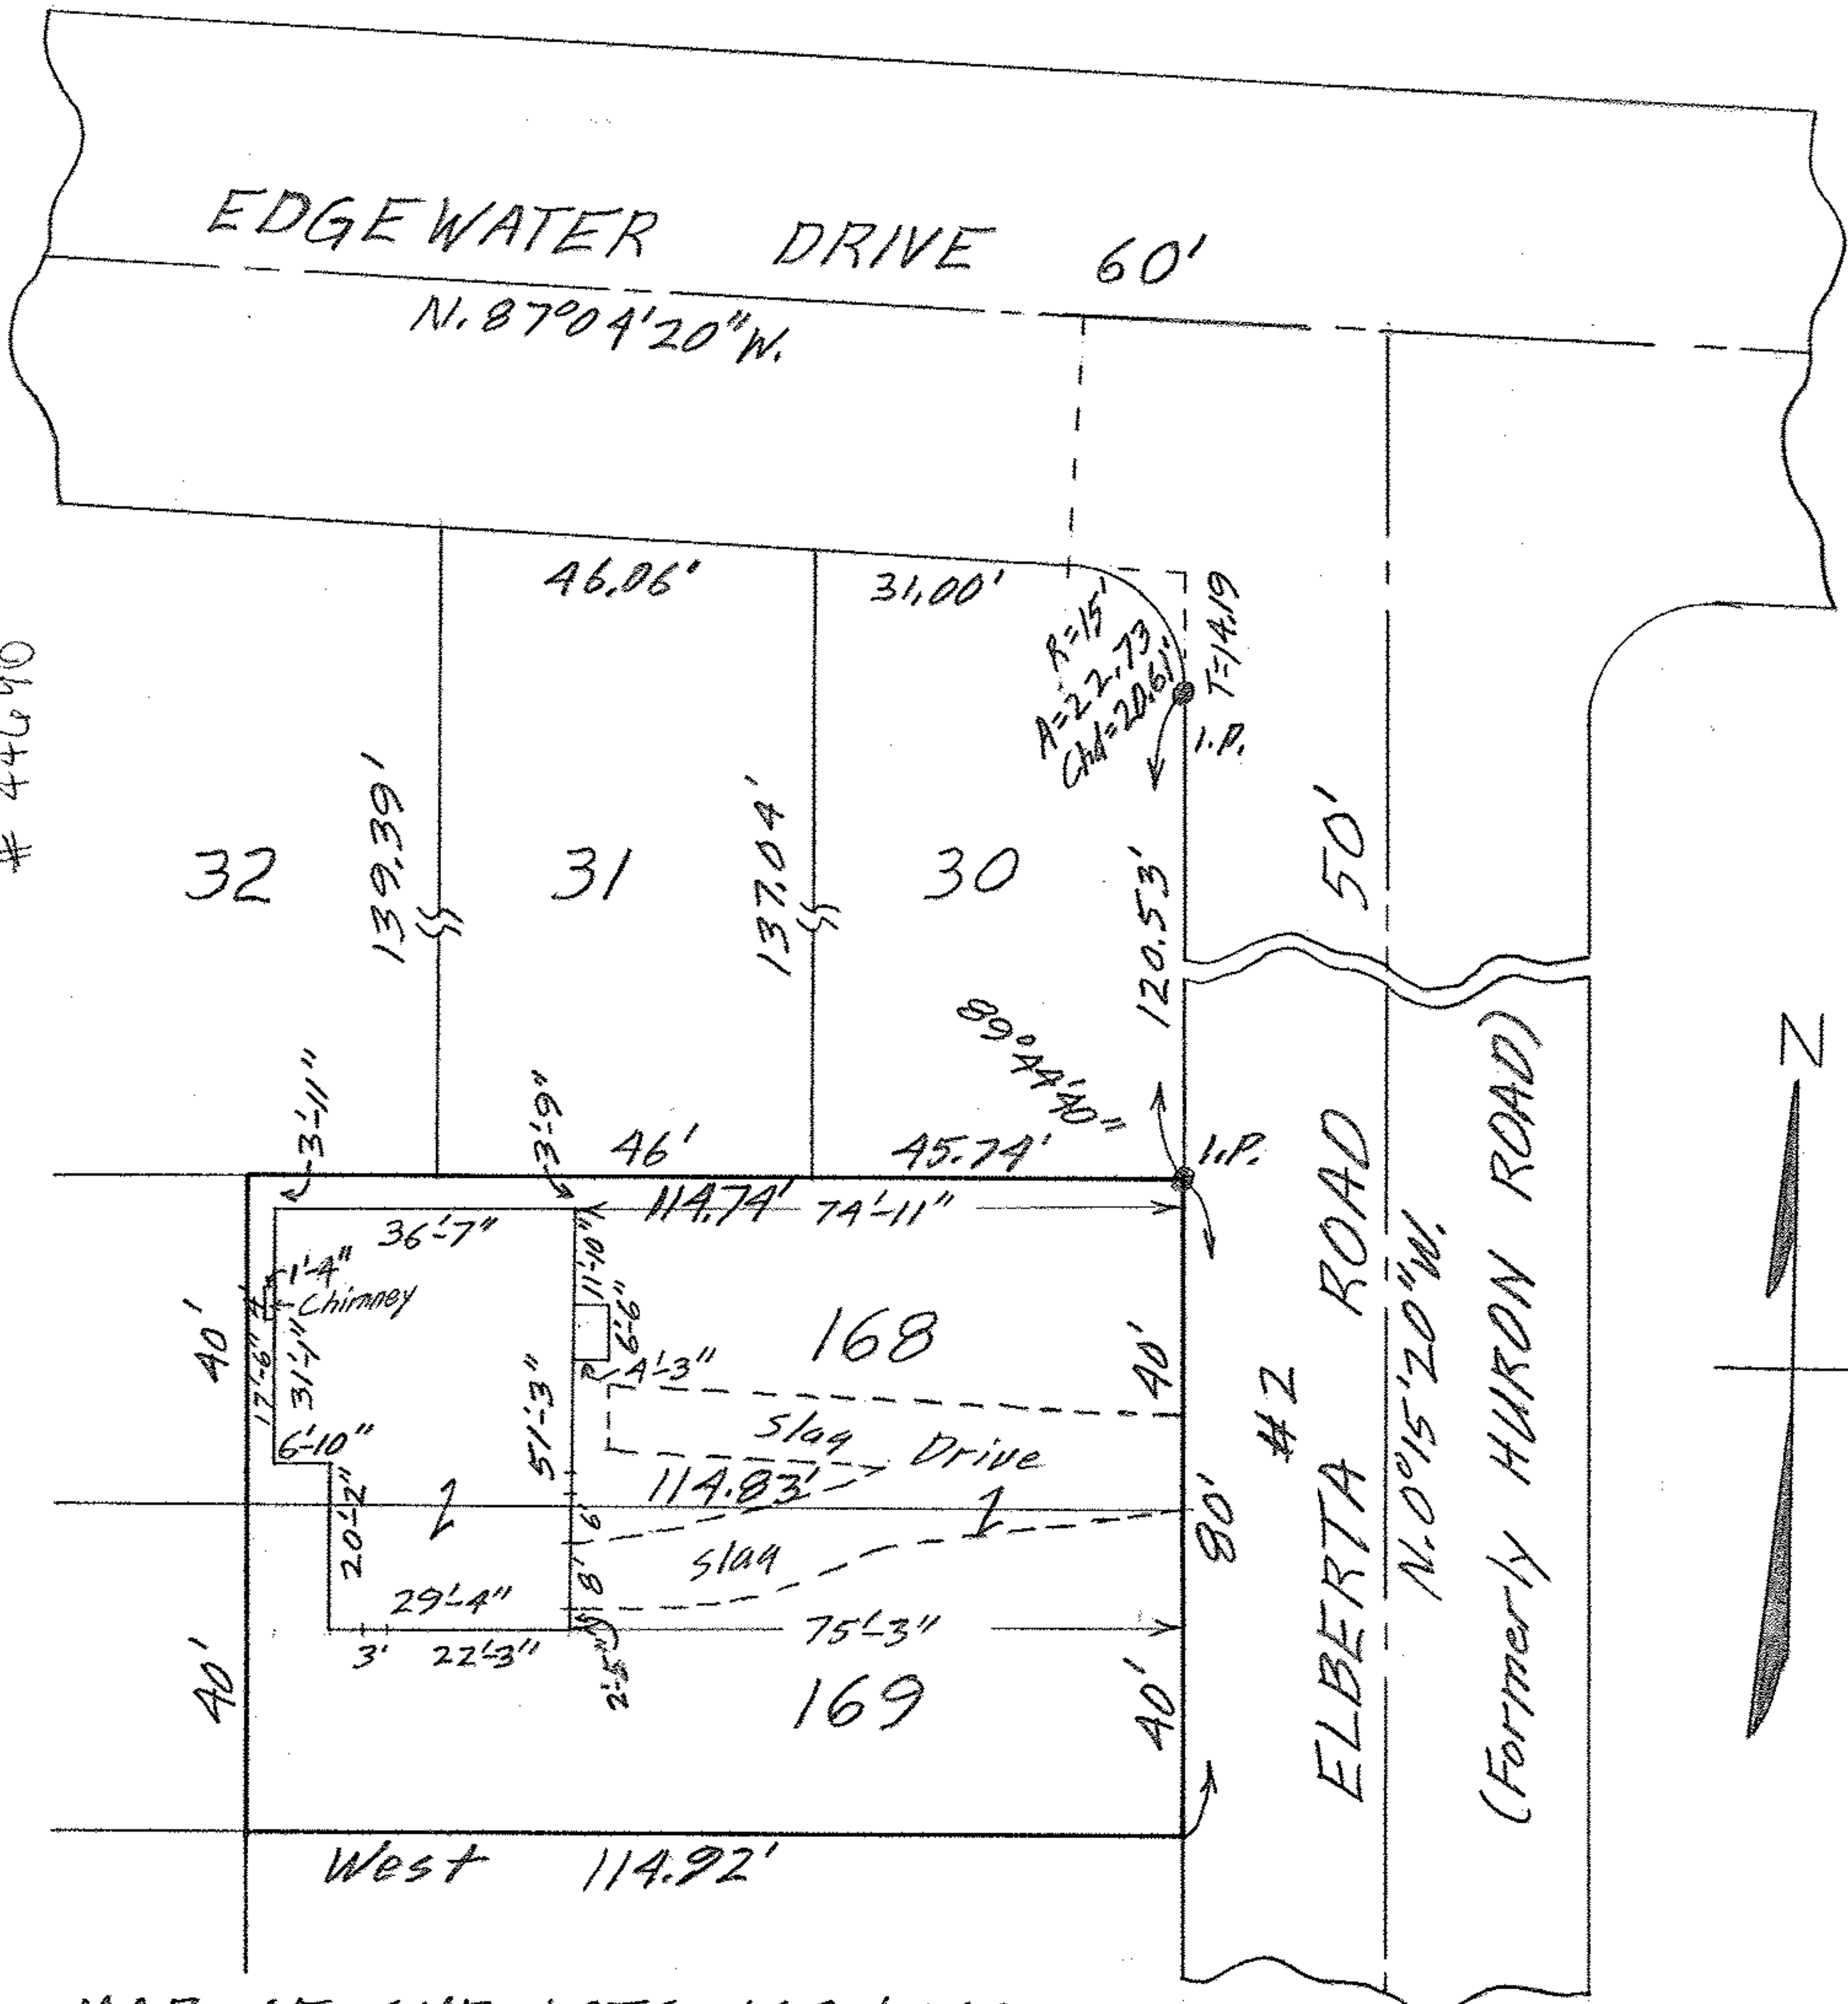

MAP OF SUB-LOTS 168 & 169  
 ELBERTA BEACH SUB'N. VOL. 10 Pgs. 13 & 14  
 ORIGINAL LOT NO. 1 BROWNHELM TWP  
 VERMILION CITY - LORAIN COUNTY - OHIO  
 SCALE: 1"=30' MAY 6-1965 5:30 P.M.  
 Gary E. Penfound REG. SURVEYOR  
 Evan F. & Edna D. AKERS