


01-00-001.105-046-7049

Carl G. & Lois Ann Phillips #44991

EDGEWATER DRIVE 60'

N. 87°04'20"W.

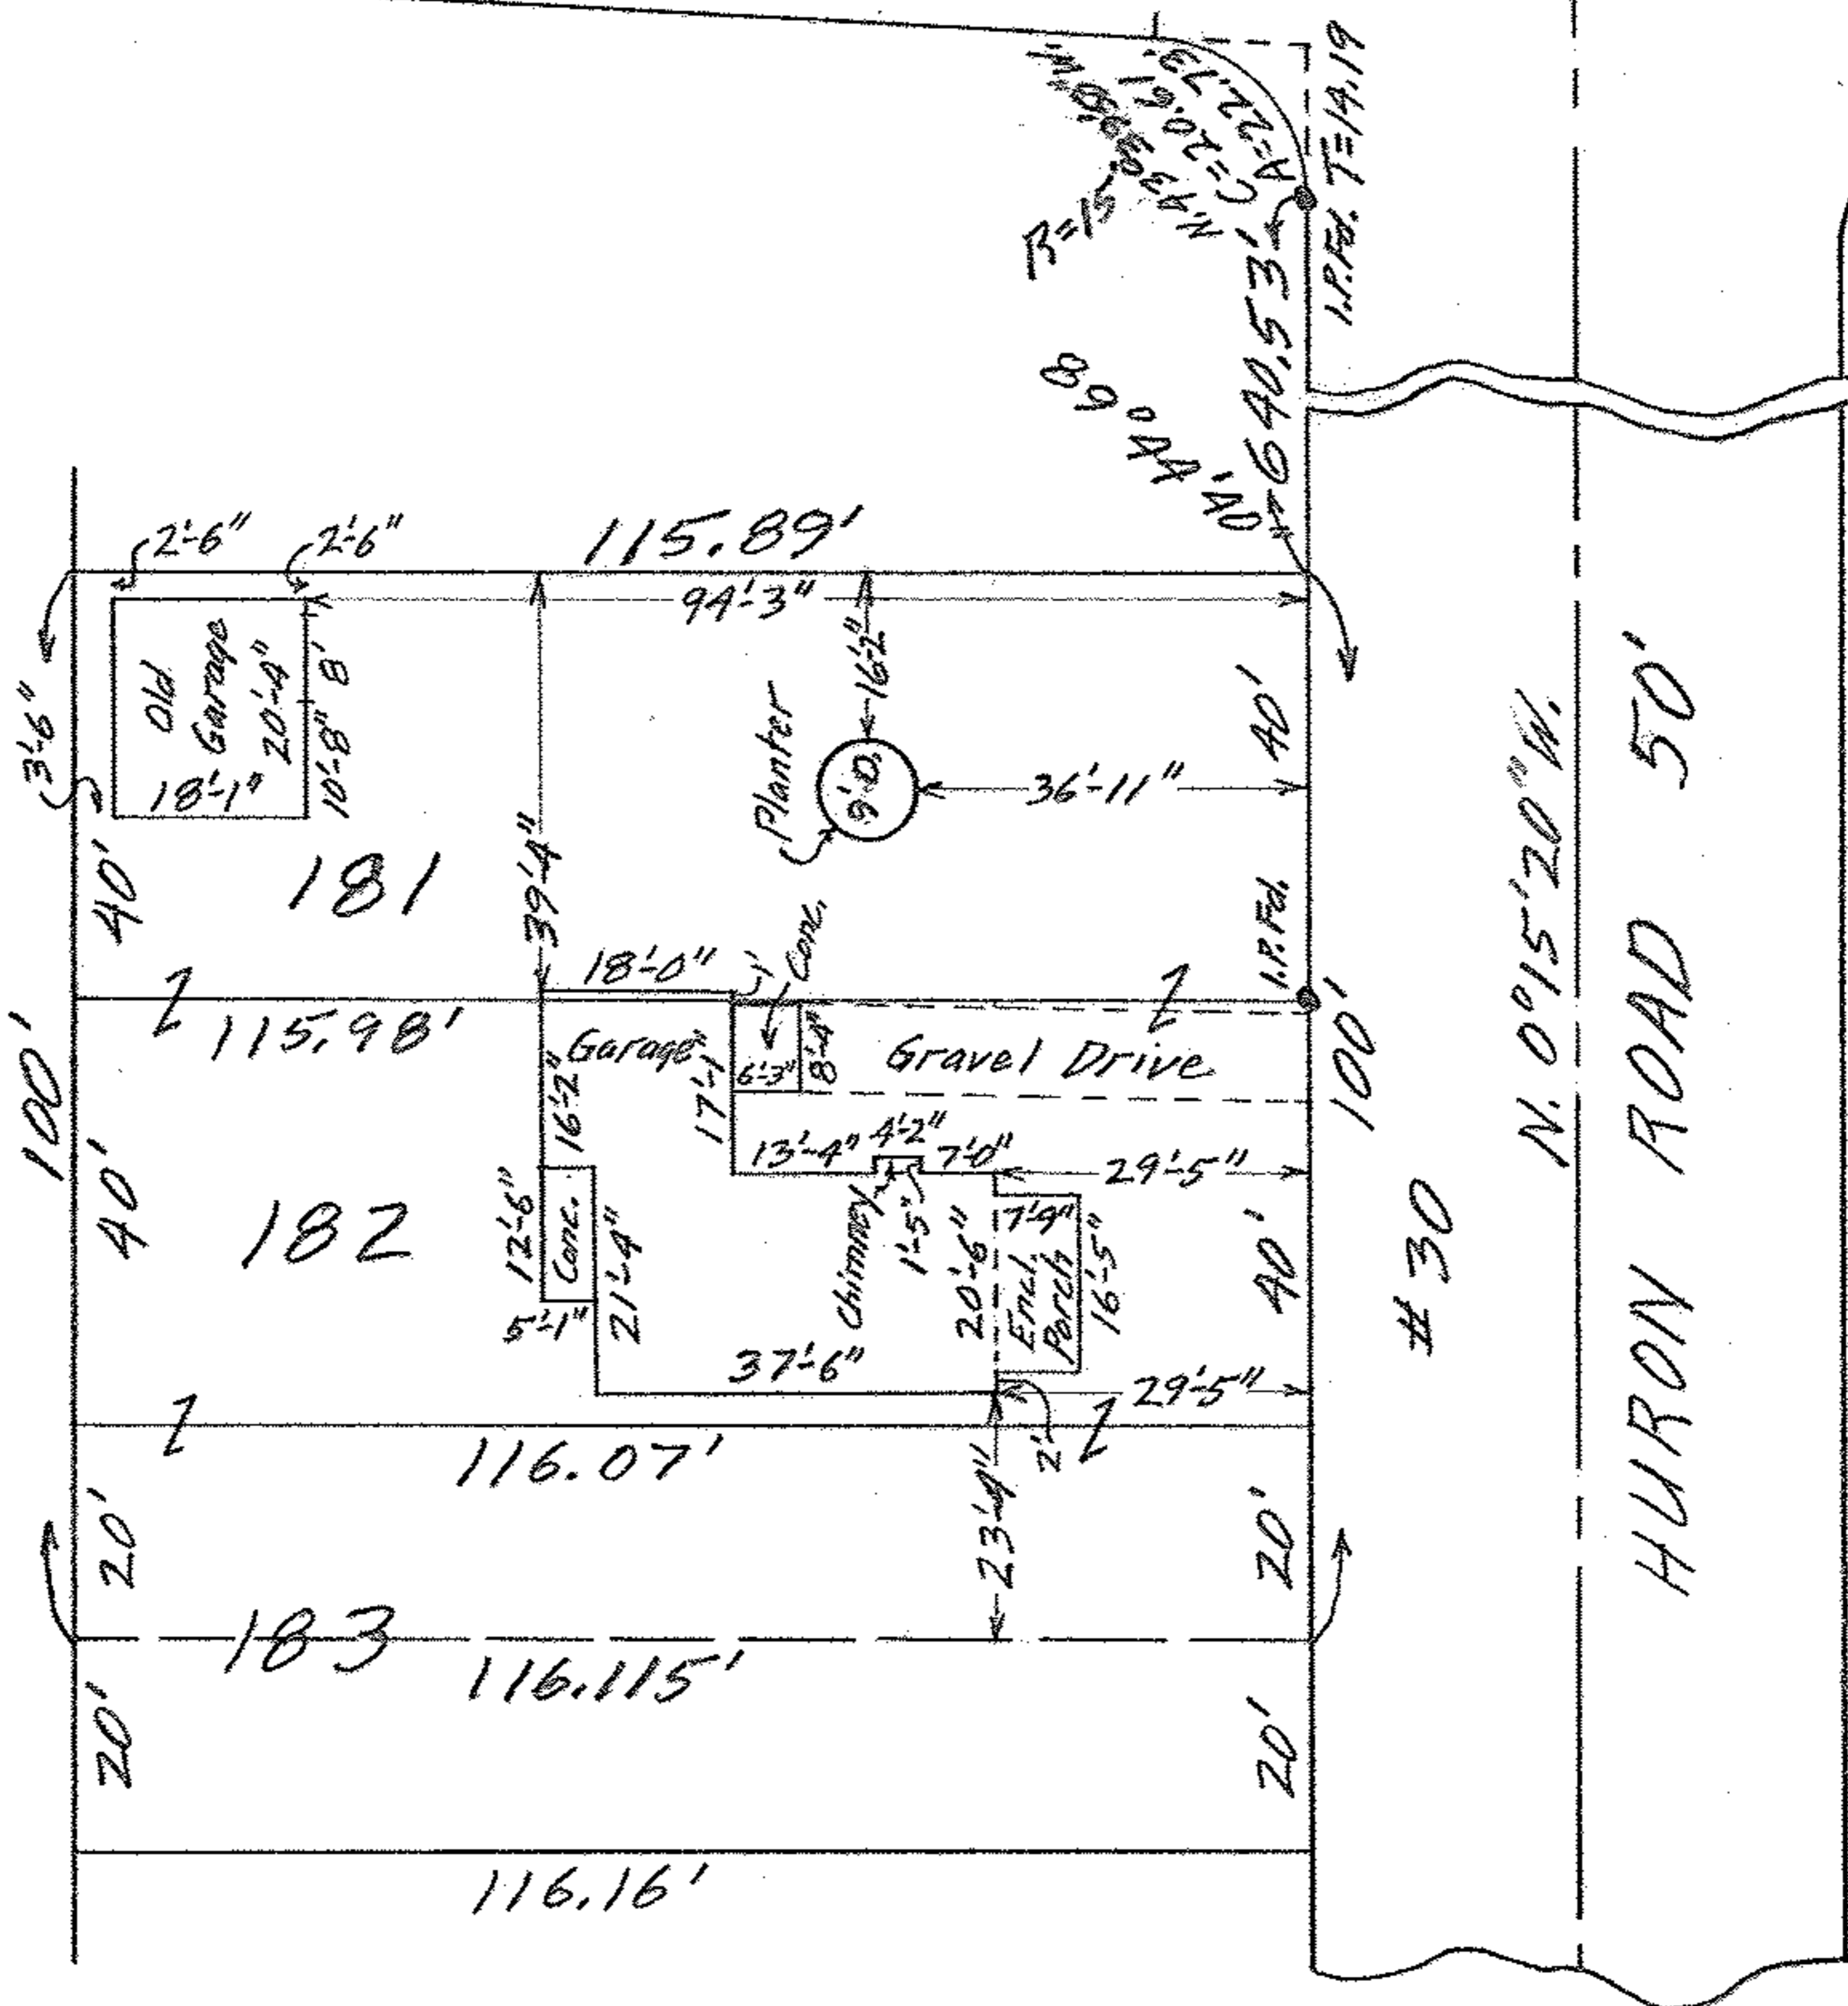

MAP OF SUB-LOTS 181 & 182 & NORTHERLY  
 ONE-HALF OF SUB-LOT 183 IN ELBERTA  
 BEACH SUB'N. VOL. 10 PGS. 13 & 14 PLATS  
 ORIG. LOT NO. 1 BROWNHelm TWP.  
 LORAIN COUNTY OHIO  
 SCALE: 1" = 30' JANUARY 2-1963 2:30 P.M.

Gary E. Penfound REG. SURVEYOR BH