


01-00-002-110-004 # 44697
01-00-002-B

1125

127.72'

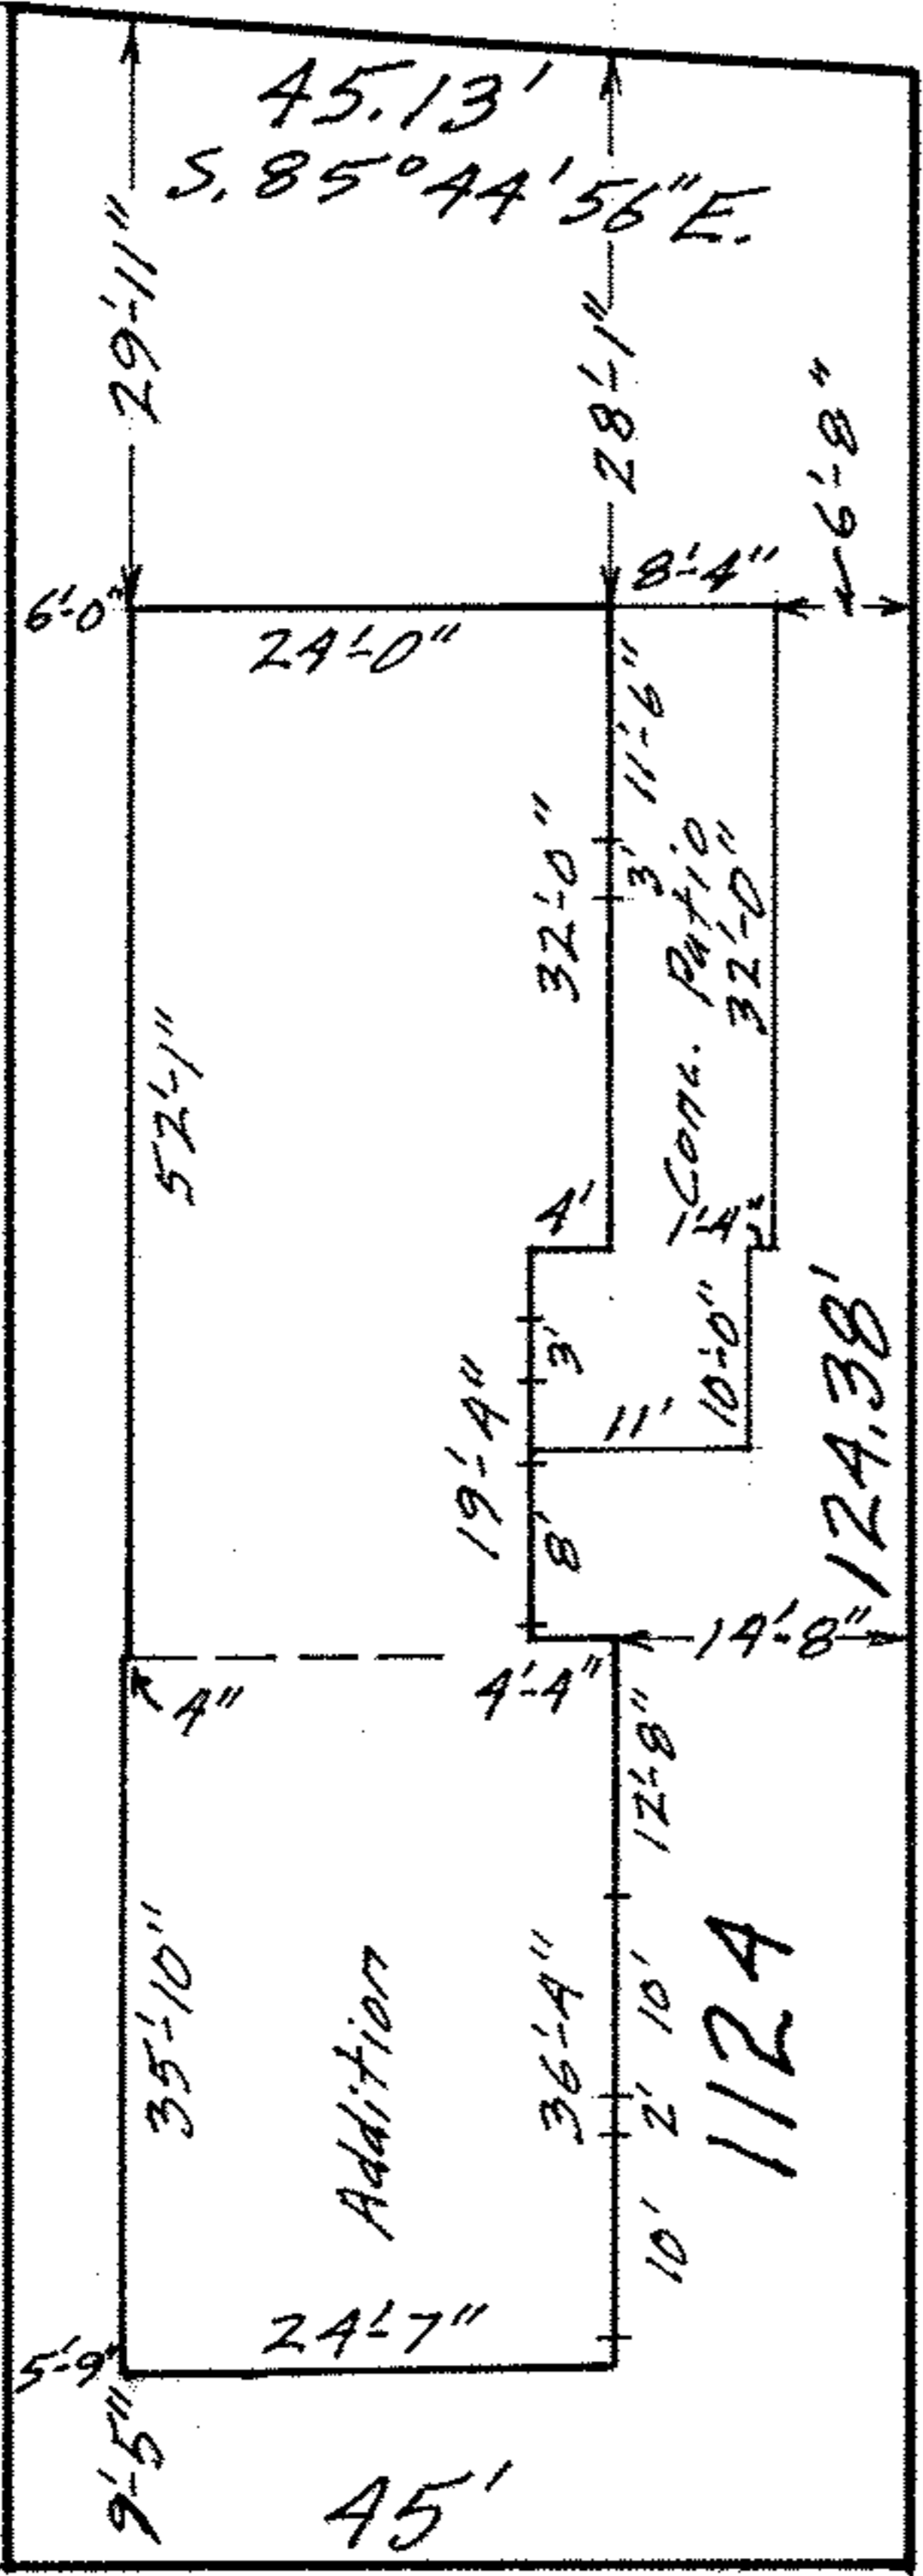

45' East

1123

ROXBORO ROAD 40'

Due North

60'

EDGEWATER BLVD.
Tangent \pm $S. 85^{\circ} 00' 17'' E.$


I.P.

MAP OF SUB-LOT NO. 1124
VERMILION-ON-THE-LAKE SUBN. NO. 1 - Vol. 10 Pg. 18
ORIG. LOT 2 - BROWNHELM TWP. - VERMILION CITY

LORAIN COUNTY OHIO

SCALE: 1" = 20' JULY 11-1966 12:15 P.M.

Gary E. Penfound REG. SURVEYOR

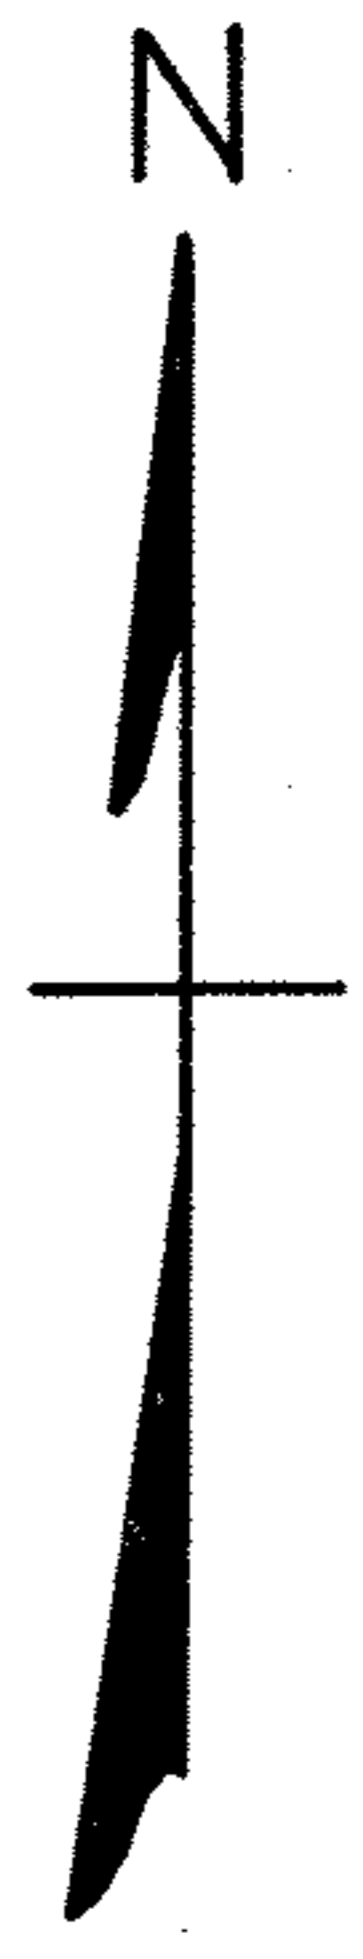

Harold & Jeanette Brumbach