


01-00-003-110-035, 036  
 01-00-003-A # 44711

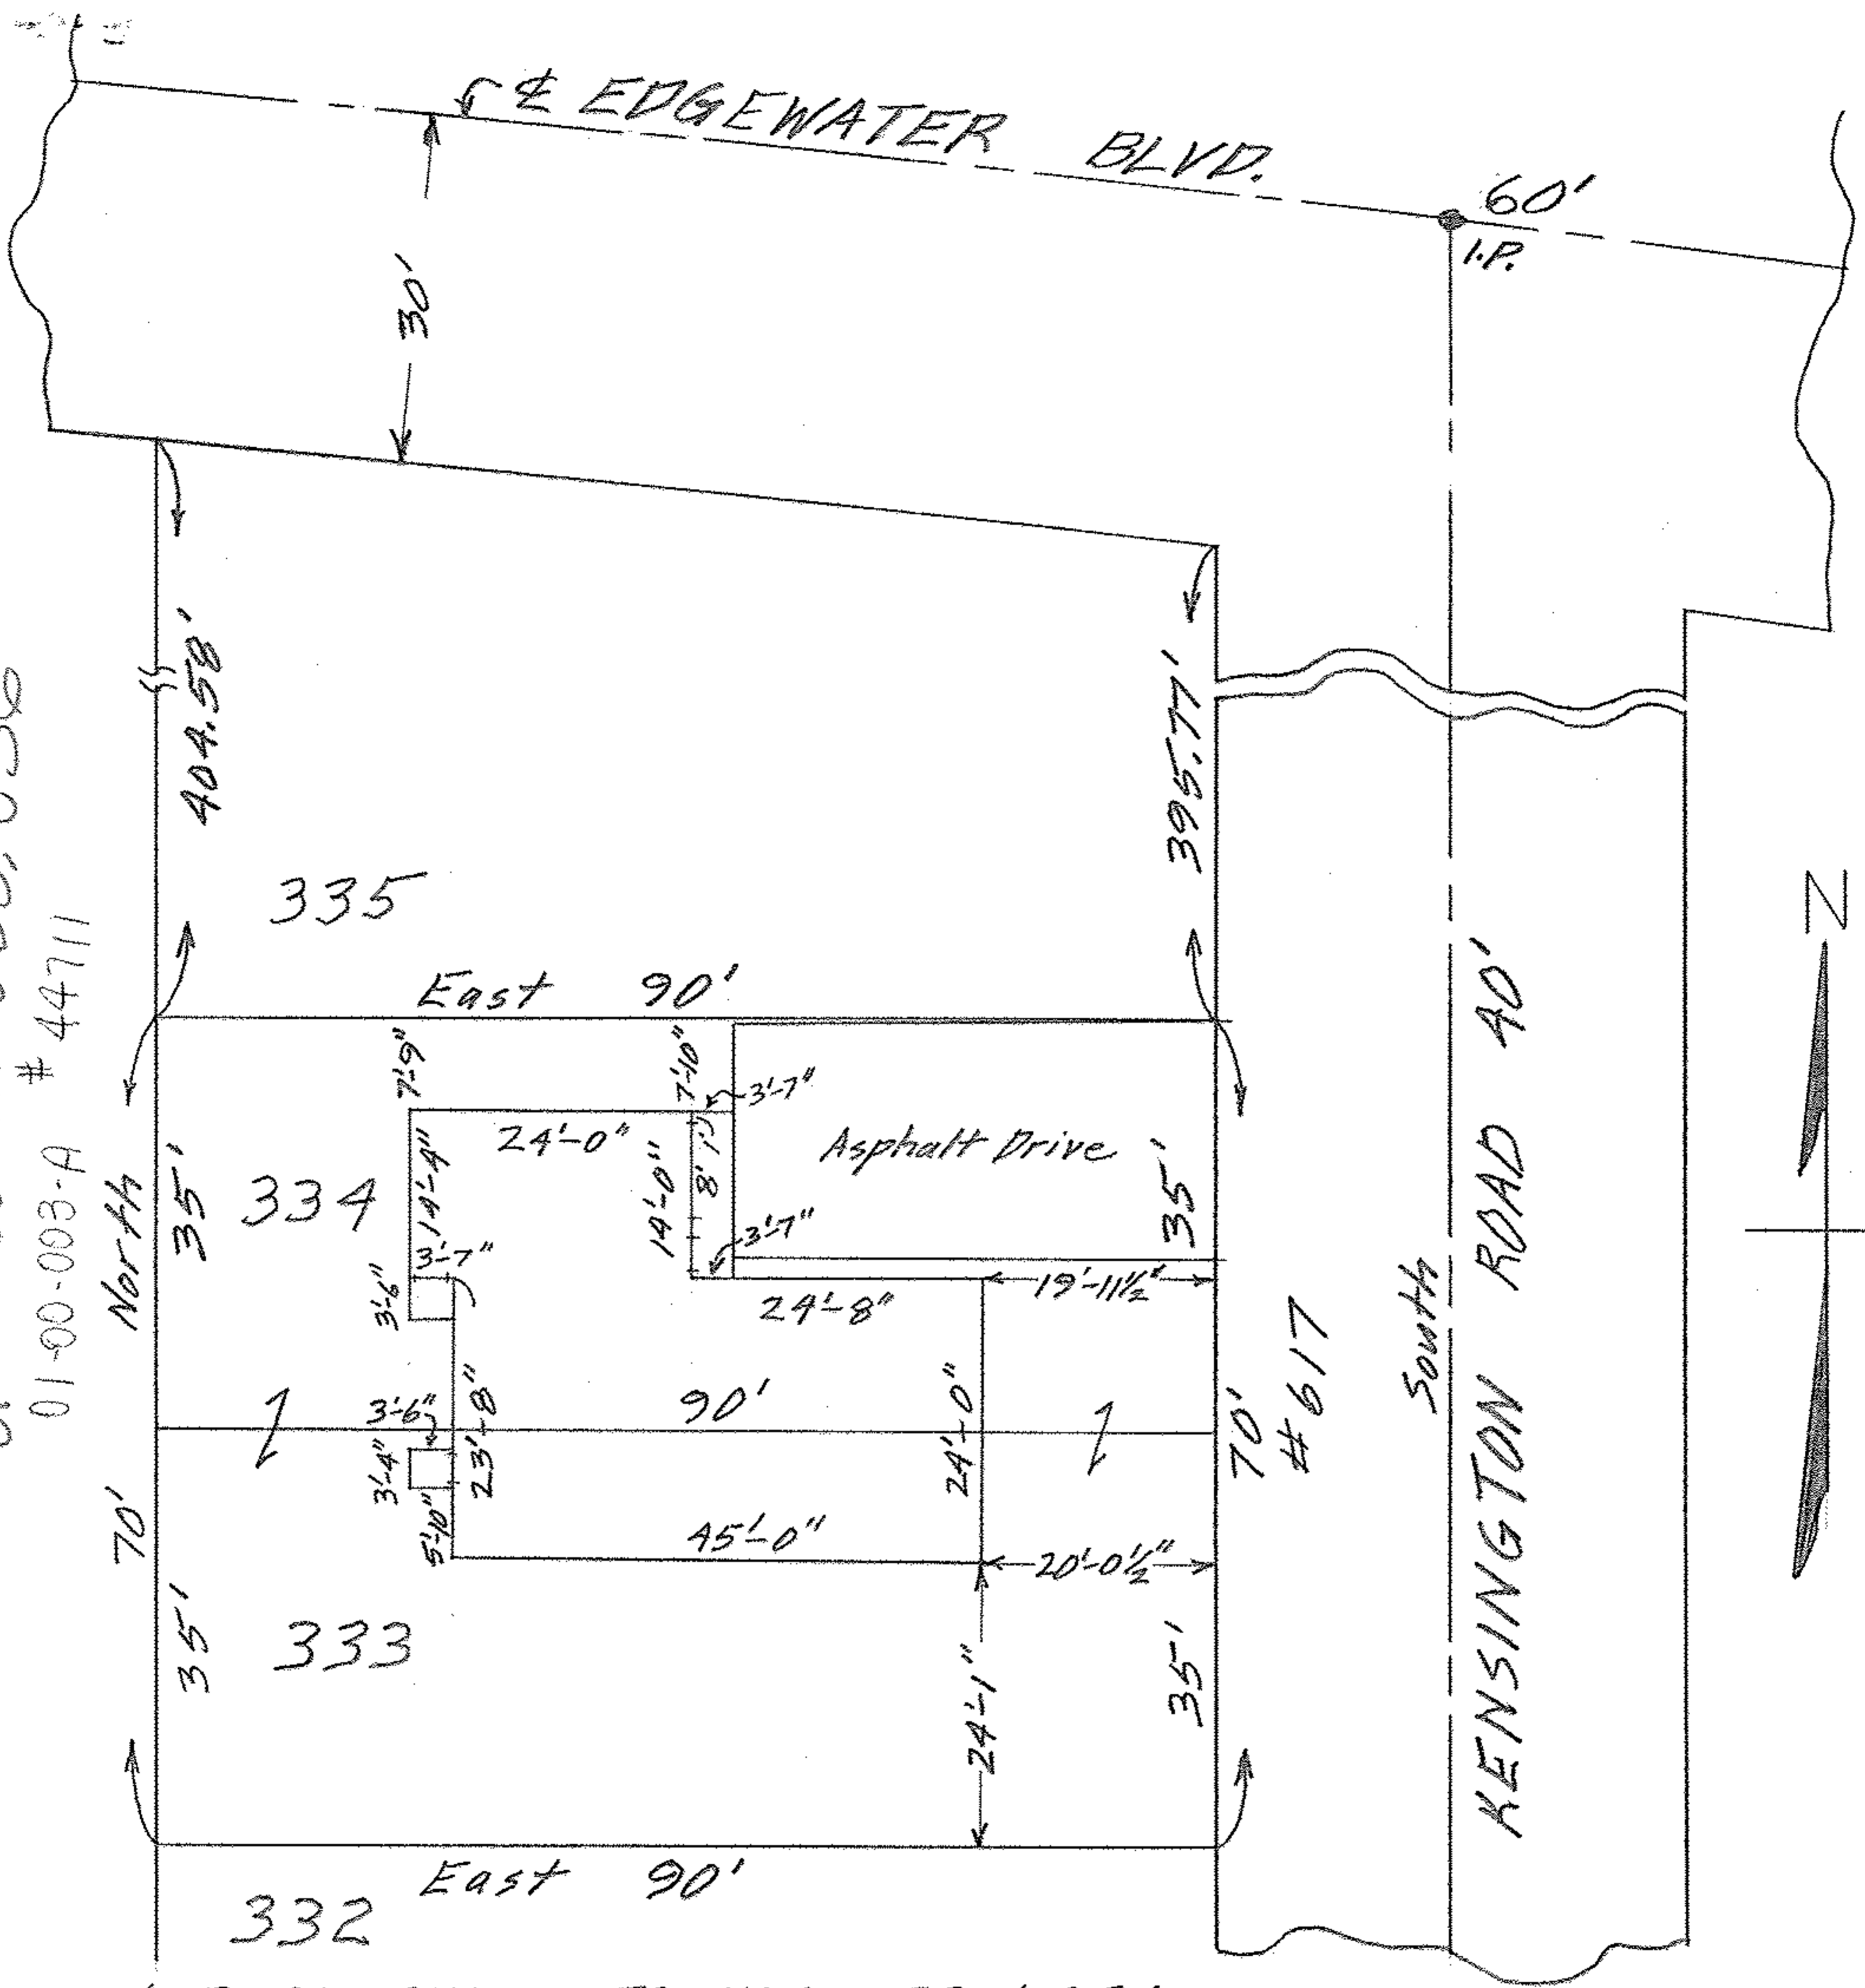

MAP OF SUB-LOTS NOS. 333 & 334  
 VERMILION-ON-THE-LAKE SUB'N. NO. 1 Vol. 16 Pgs 32 & 33  
 ORIG. LOT 3 - BROWNHELM TWP. - VERMILION CITY  
 LORAIN COUNTY OHIO  
 SCALE: 1" = 20' OCT. 28 - 1964 5:30 P.M.  
 Gary E. Penfound REG. SURVEYOR  
 Howard E. & Brenda J. Hughes

BH