


01-00-003-110-035, 036
 # 44712
 # 01-00-003-A

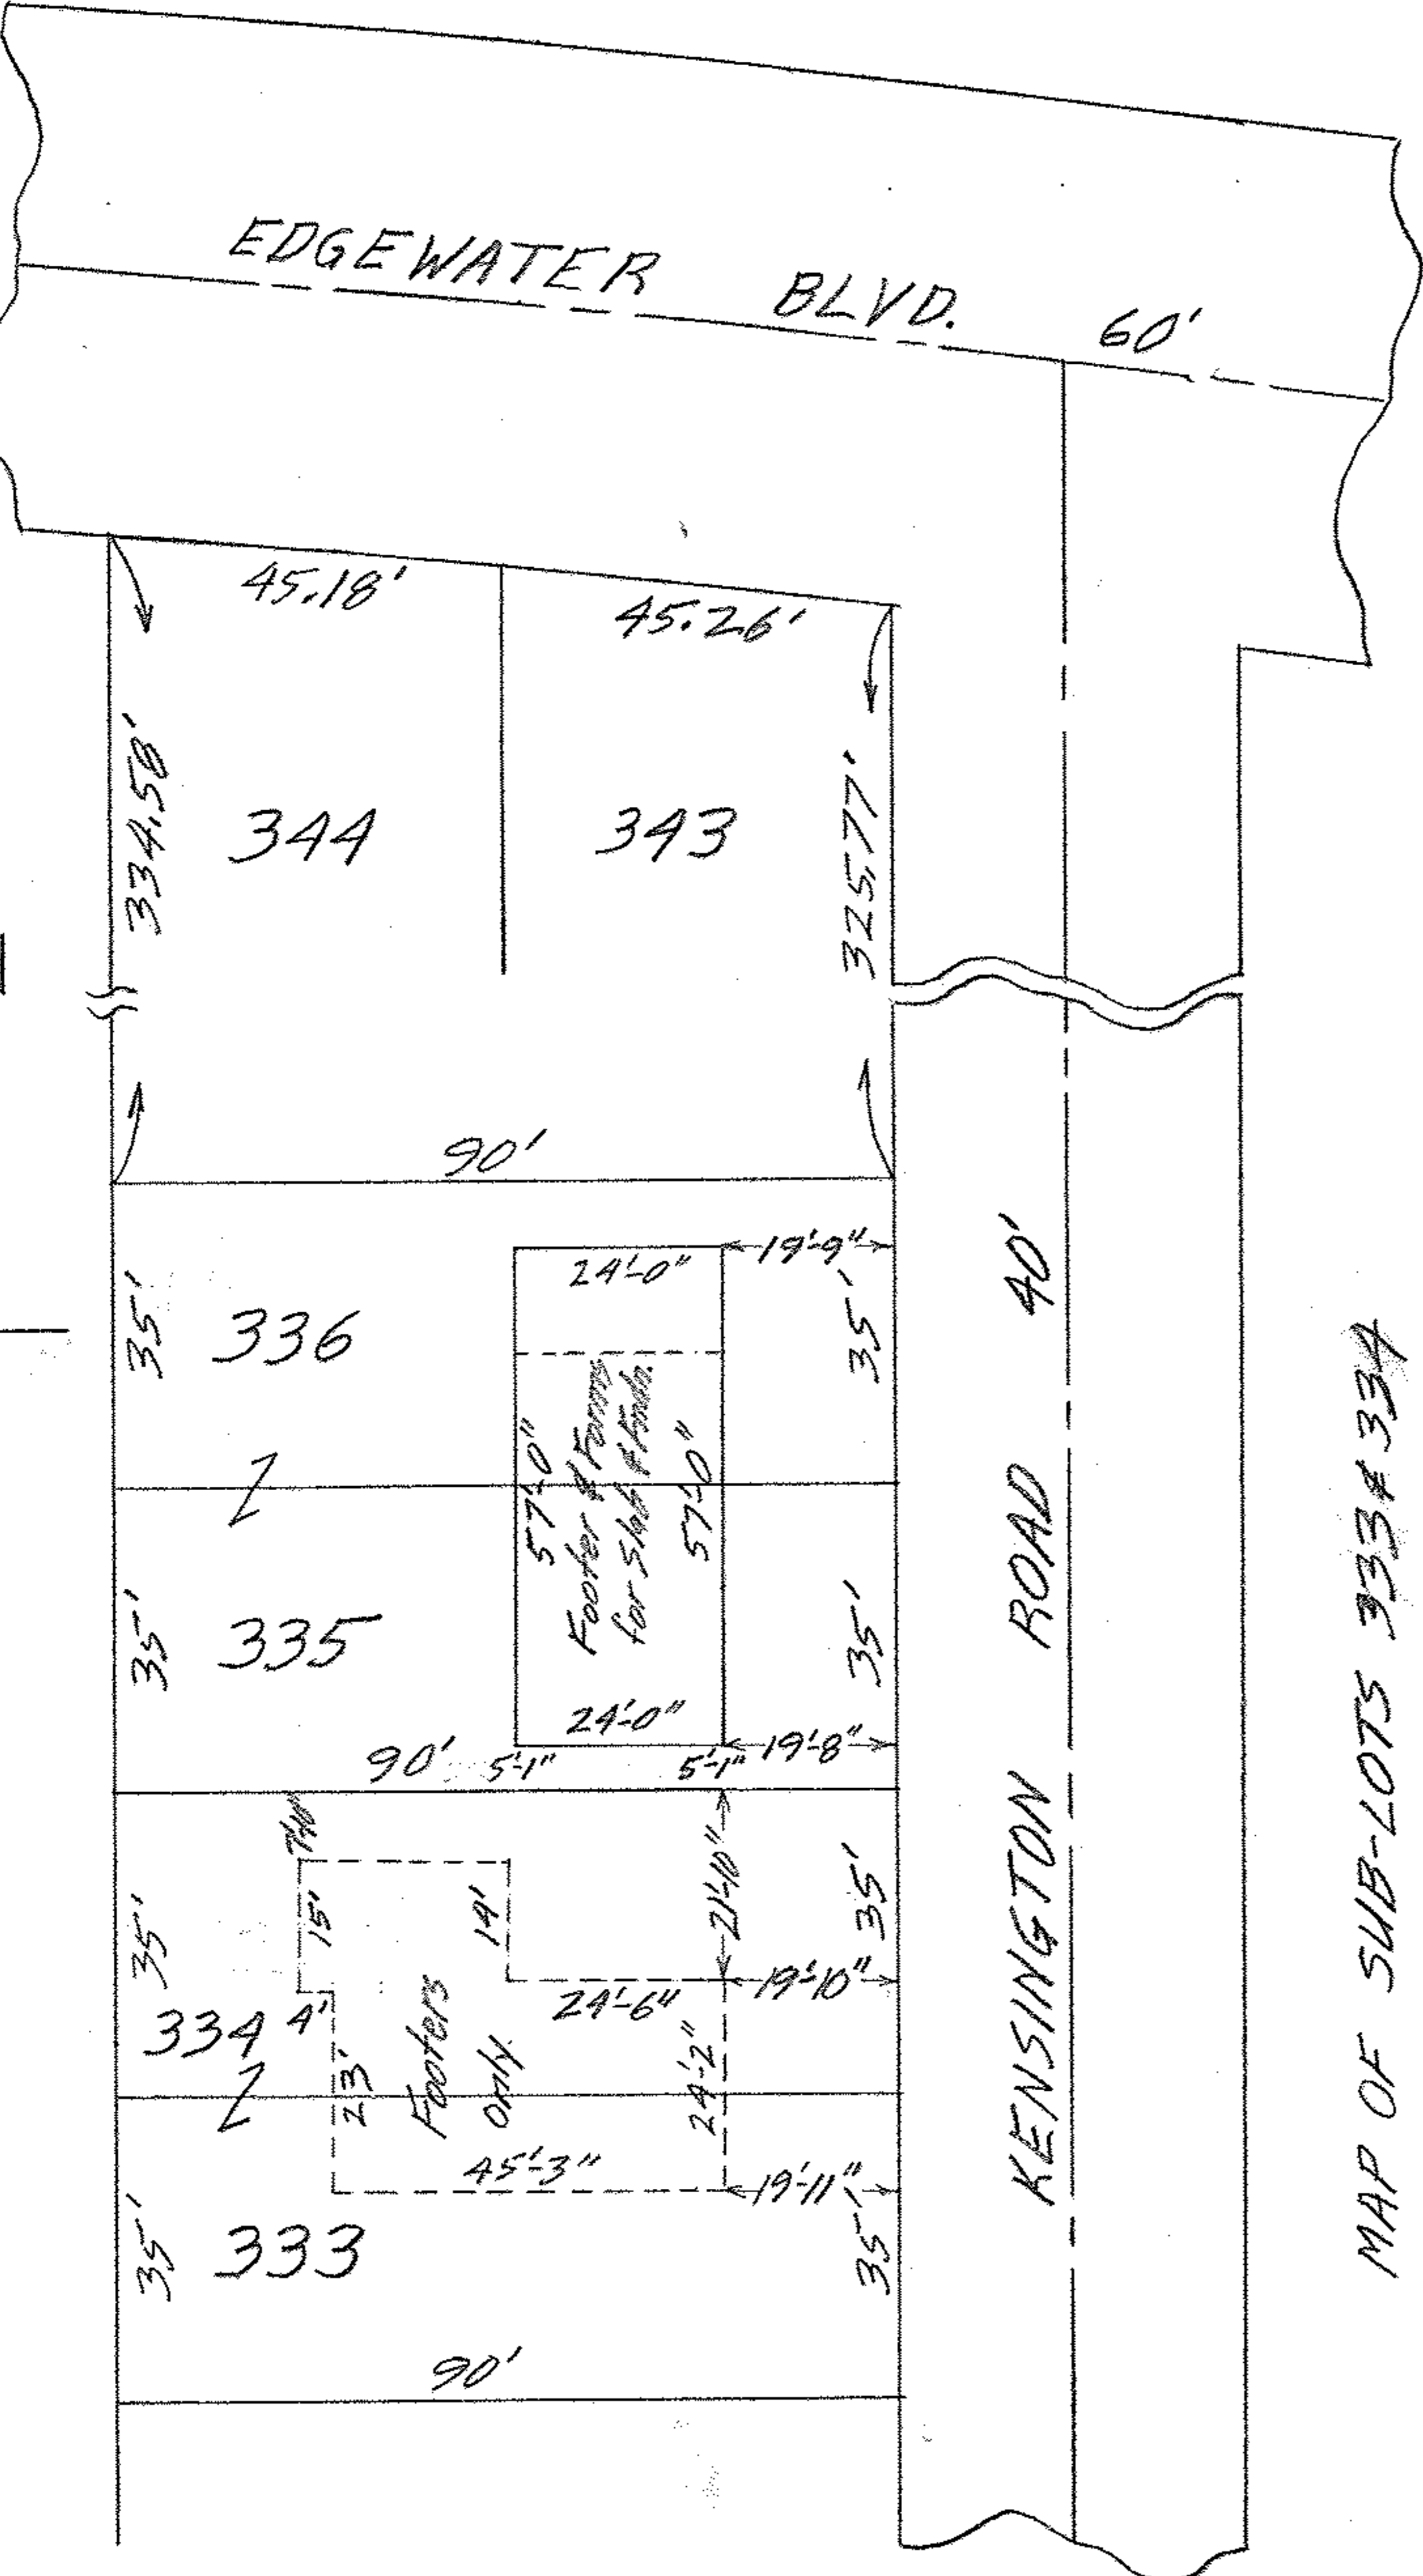

MAP OF SUB-LOTS 333 & 334
 VERMILION - ON-THE-LAKE SUB'D. NO. 1
 VOL. 10 Pgs. 18 & 19 AND VOL. 16 Pgs. 32 & 33 PLATS
 ORIG. LOTS 2 & 3 BROWNHELM TWP.
 VERMILION - ON-THE-LAKE VILLAGE
 LORAIN COUNTY OHIO
 SCALE: 1" = 30' FEB. 22-1961 2:30 P.M.
 Mary E. Penfound REG. SURVEYORS
 for C. E. Penfound

CH-8288 John A. & Marie Rader