


01-00-004-124-023, 024
 # 44719
 01-00-004-C

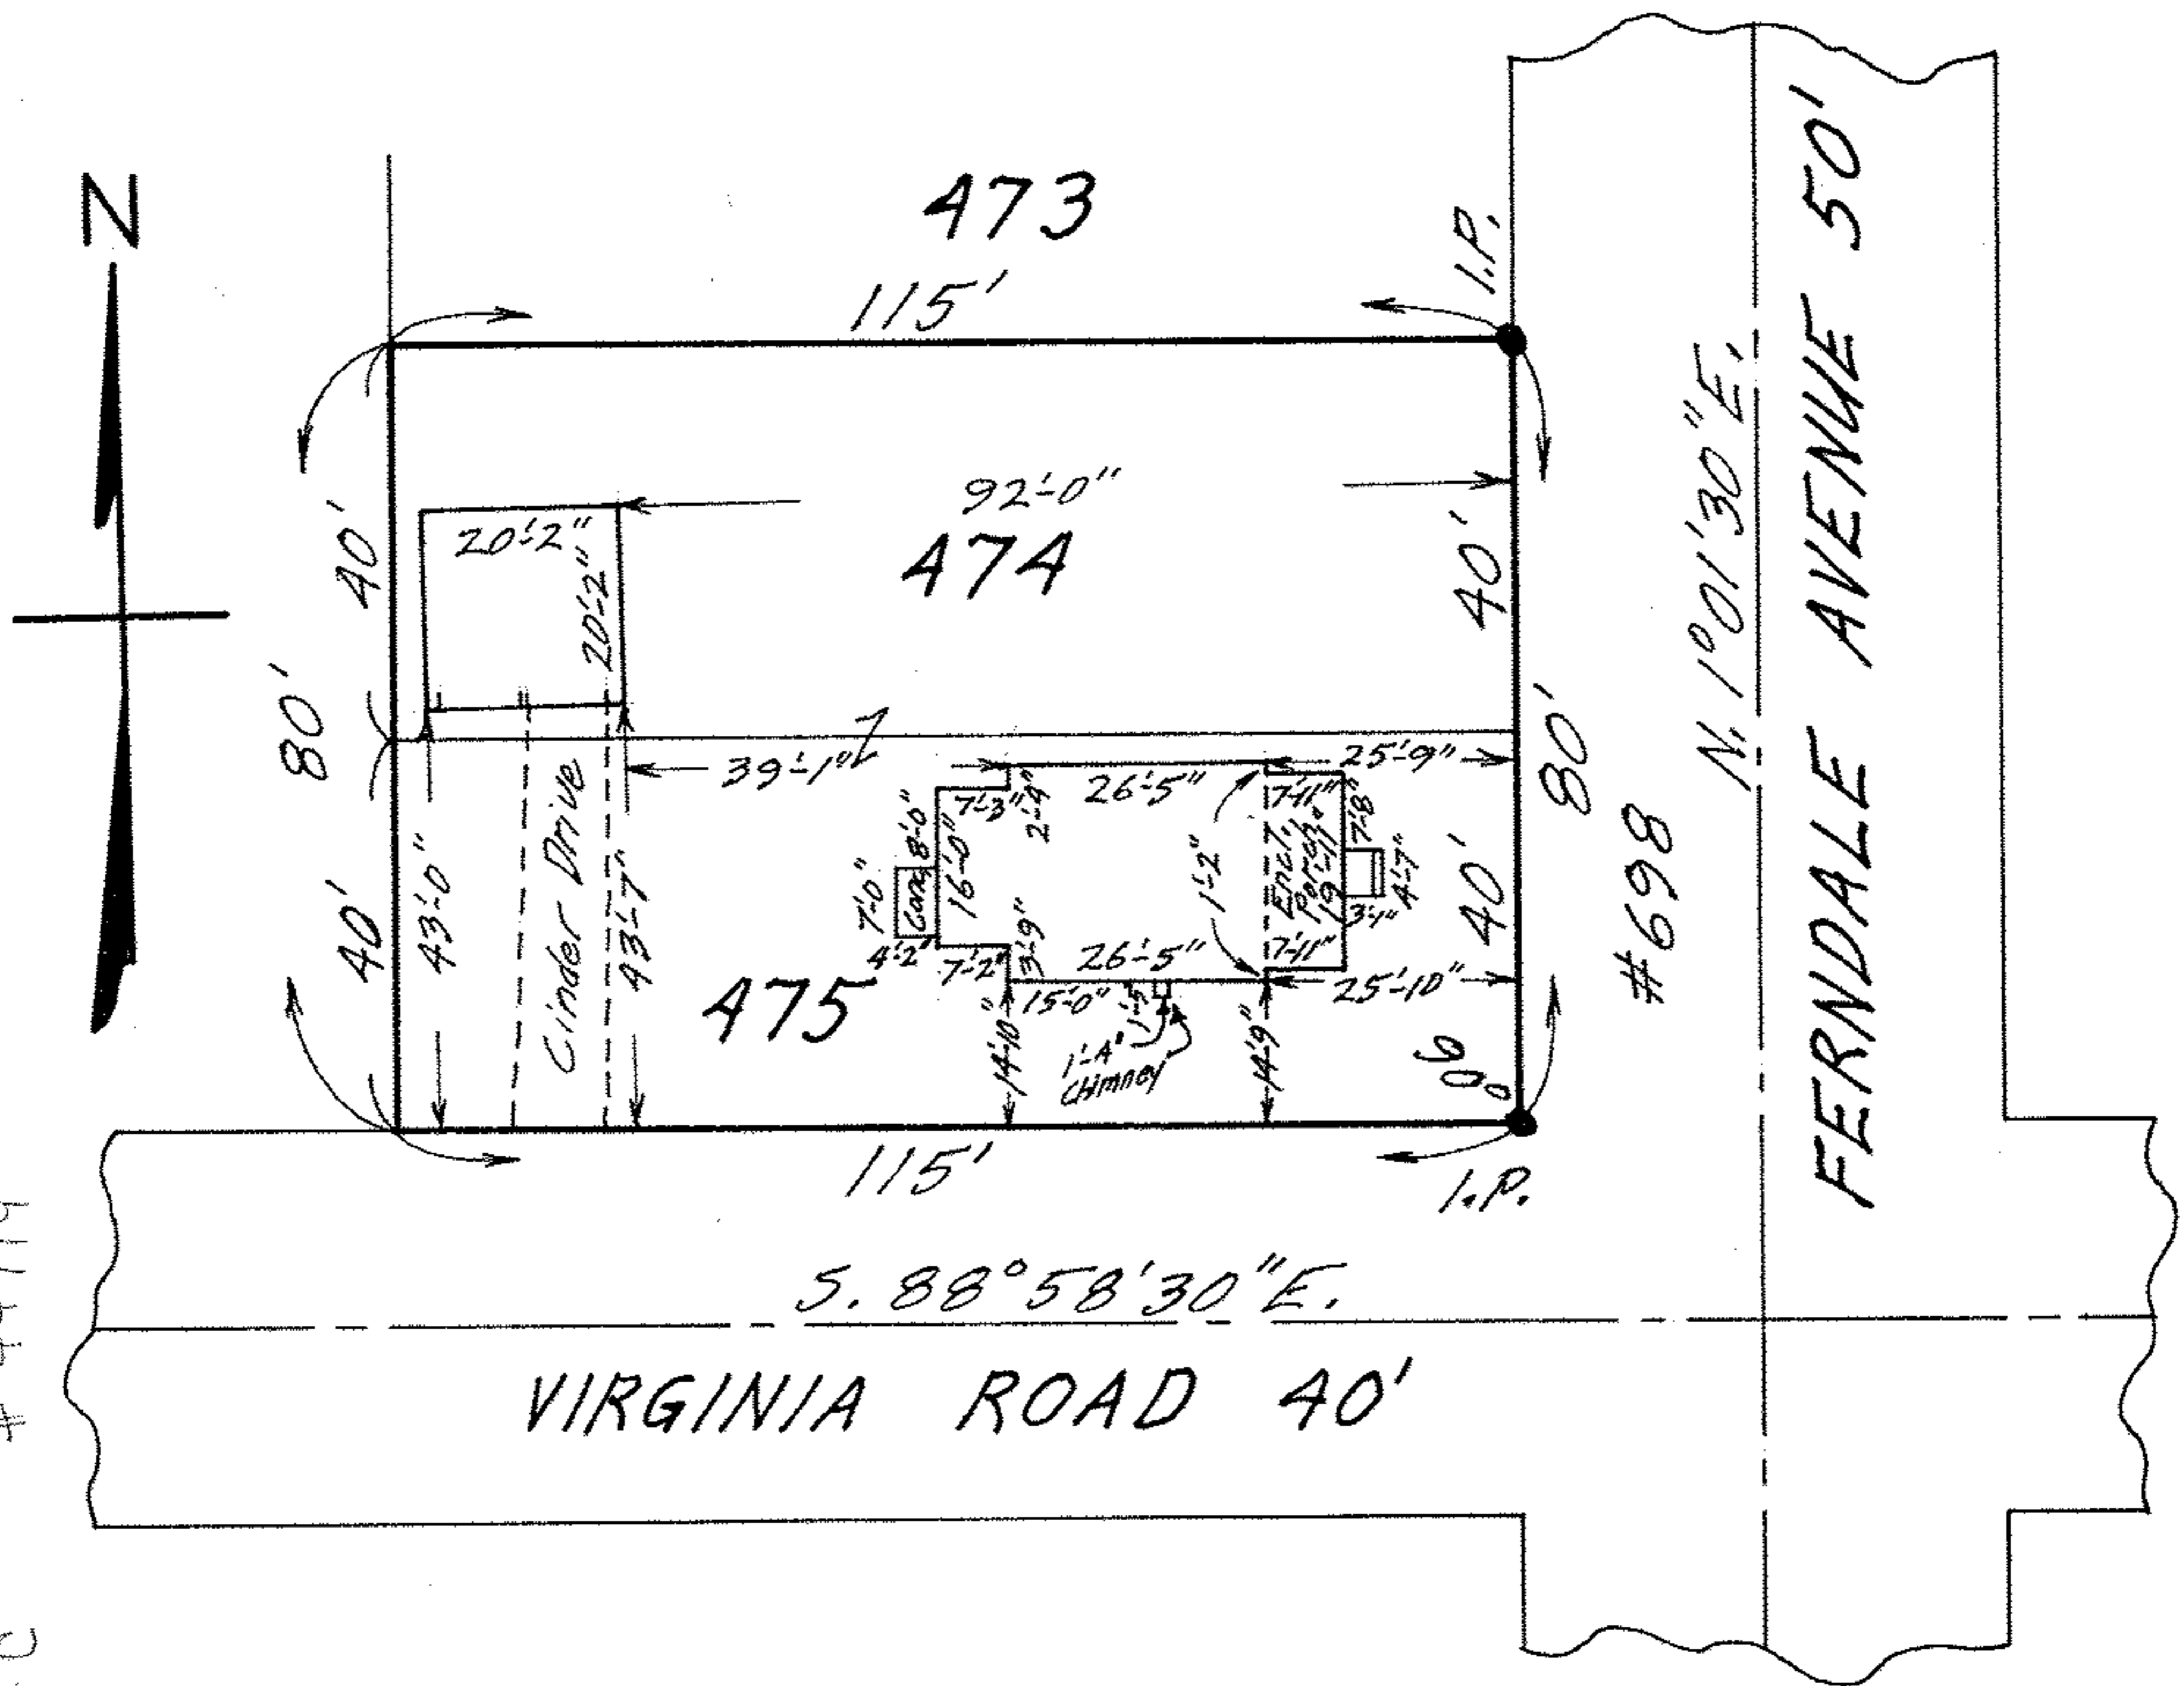

MAP OF SUB-LOTS NOS. 474 & 475
 THE ROCKPORT REALTY COMPANY'S
 SUNNYSIDE BEACH SUB'N. VOL. 12 PG. 20
 ORIG. LOT A BROWNHELM TWP.
 VERMILION CITY - LORAIN COUNTY - OHIO
 SCALE: 1" = 30' SEPT. 23-1970 3:00 P.M.
 NOTE: There are no encroachments on this property.
 Gary E. Penfound REG. SURVEYOR NO. 4457

CITY TITLE Co. Order No. E-1307
 Lallathin to Reed