

#44112

03-00-108-108-018




LAUNDON • SIMON • CAHL & ASSOC., INC.  
CONSULTING ENGINEERS & SURVEYORS  
110 MIDDLE AVE., ELYRIA, O. 44035

SURVEY FOR: 03-00-108-A

PATRICIA F. ECHKO

Orig. Lot 108	City of	Date March 1995	Scale 1" = 40'
Orig. Sec	Village of	Dwn. by RC	Chkd. by RS
Tract	County of Lorain	Job No. 95-2712	F.B. 235 P.17
Township of Sheffield	State of Ohio	Printed	

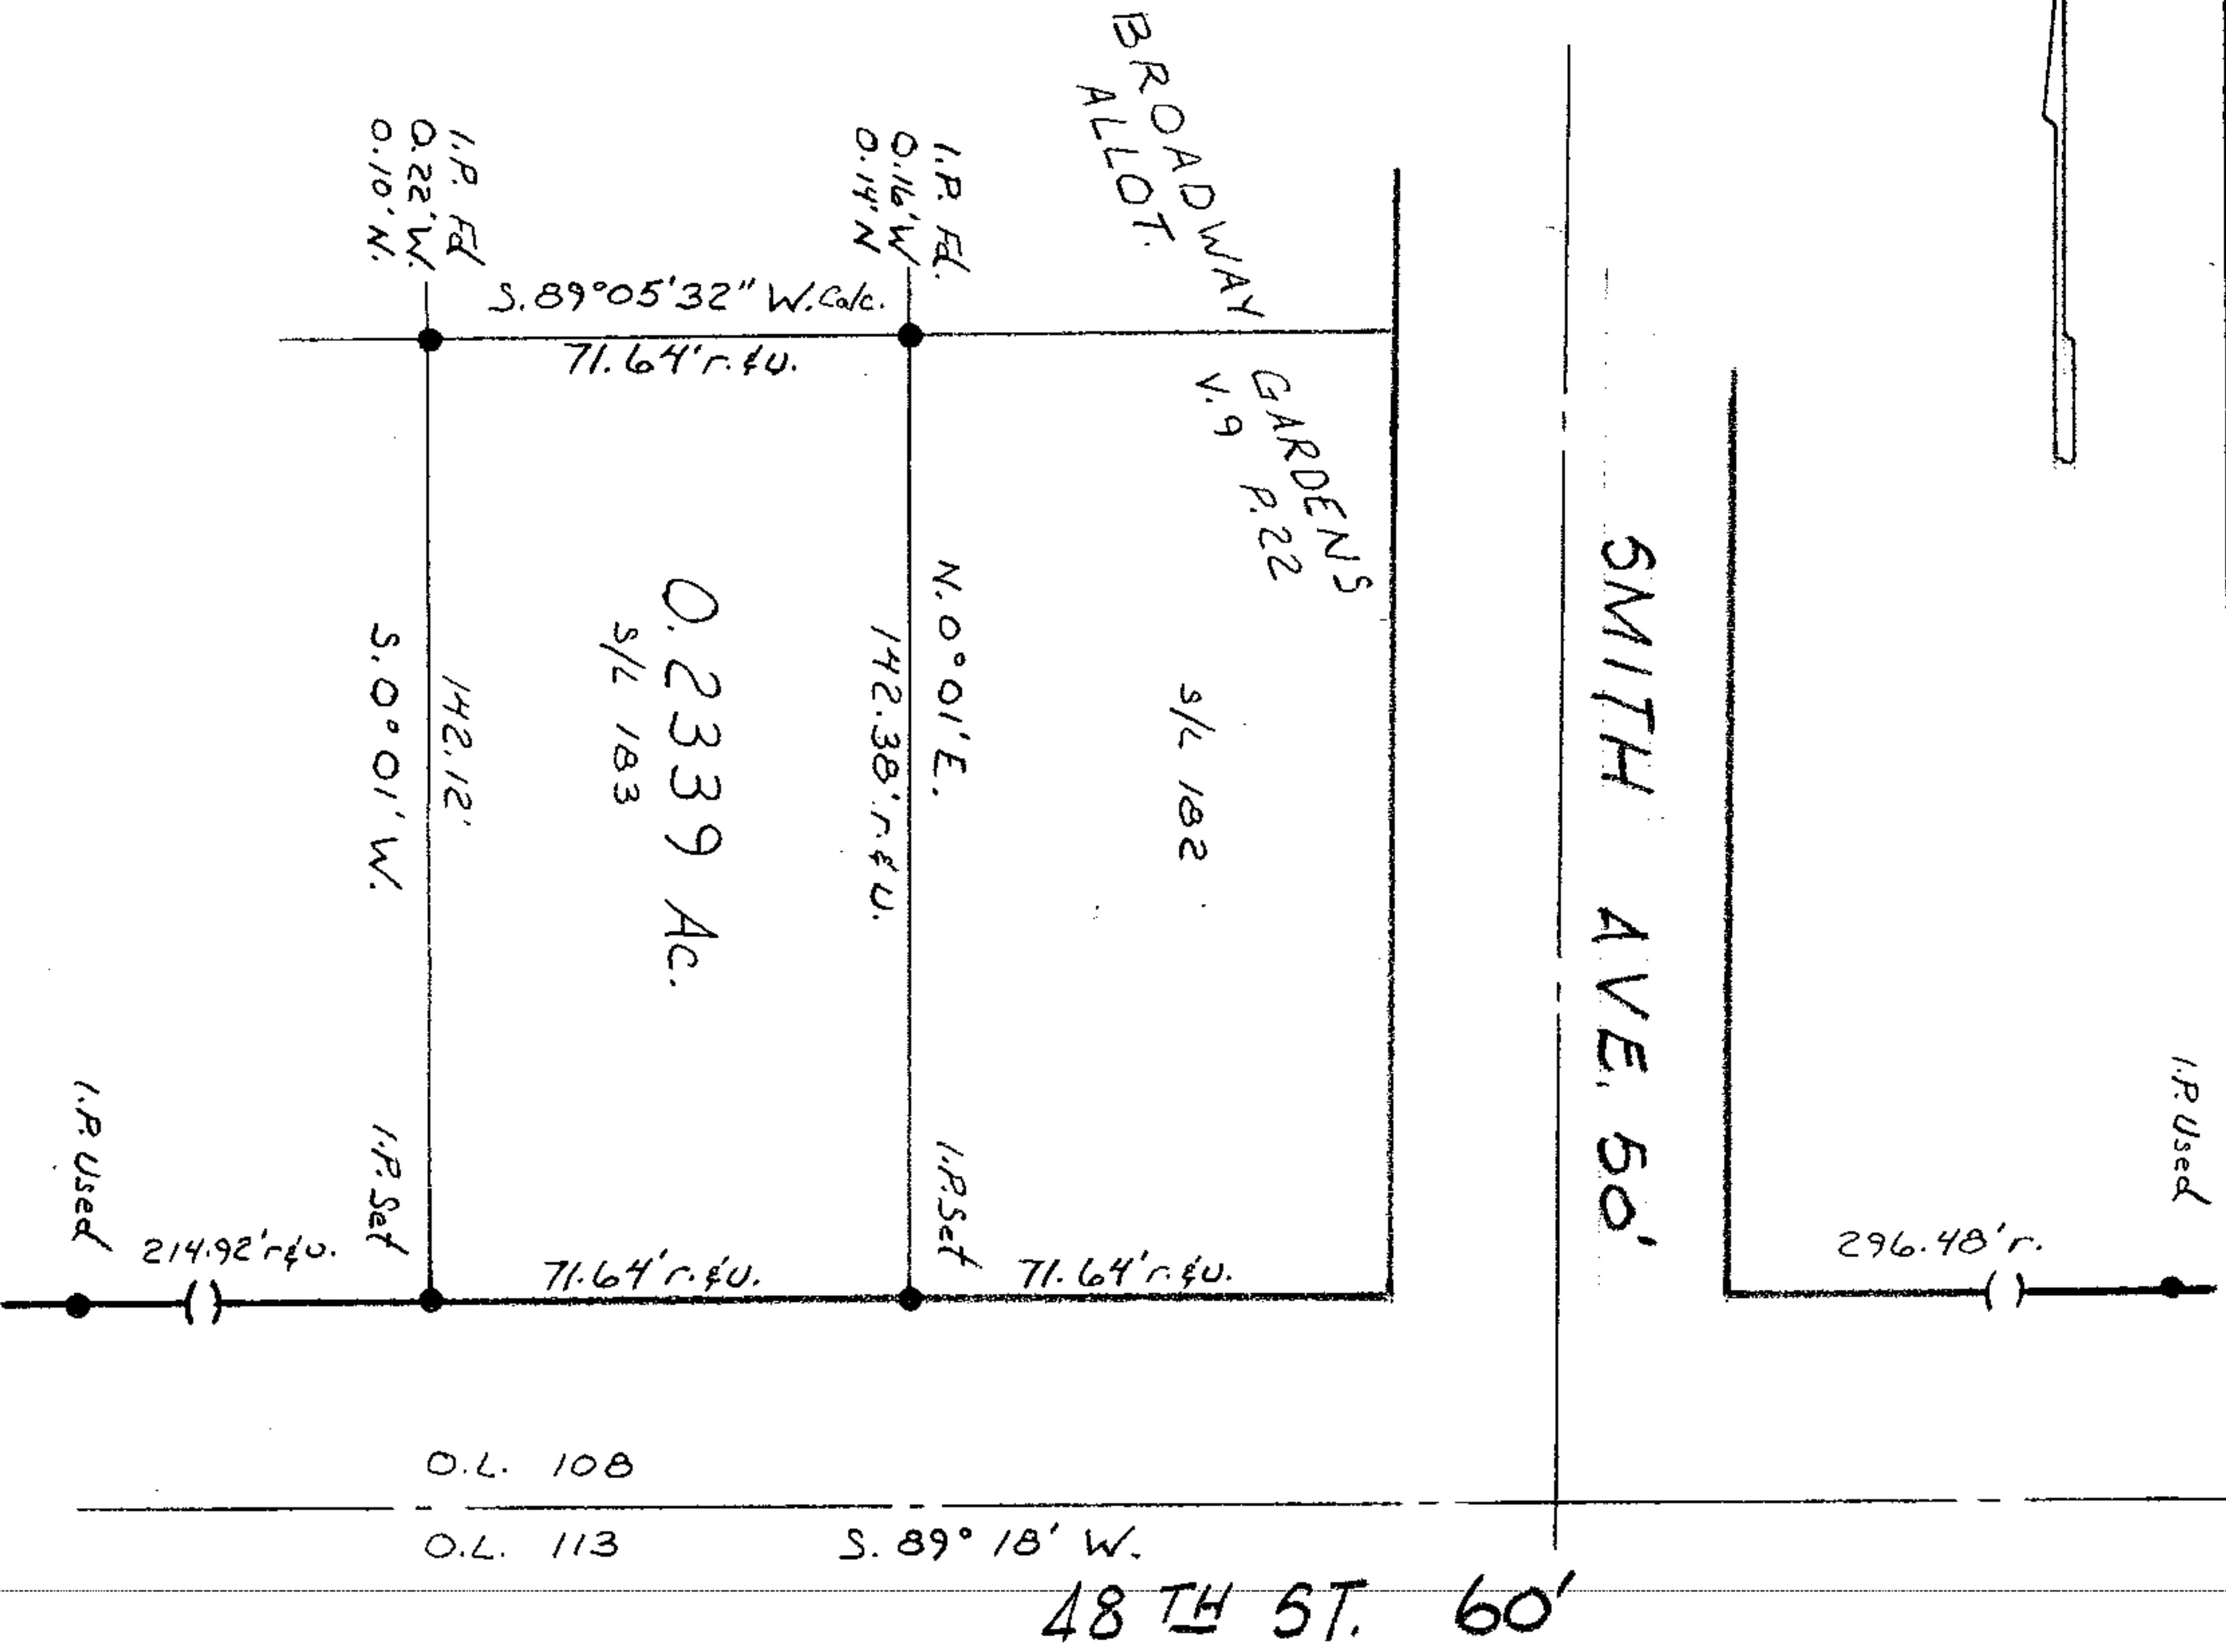

O.L. 108

O.L. 113