

44777

15-00-040-101-172
15-00-046 B 143




LAUNDON • SIMON • CAHL & ASSOC., INC.
CONSULTING ENGINEERS & SURVEYORS
110 MIDDLE AVE., ELYRIA, O. 44035

SURVEY FOR:

TOM BARNIAK

Orig. Lot 16	City of	Date NOV. 15, '94 Scale 1"=50'
Orig. Sec	Village of LAGRANGE	Dwn. by R.G.S. Chkd. by R.C.
Tract	County of LORAIN	Job No. 94-2668 F.B. 233/71
Township of LAGRANGE	State of OHIO	Printed

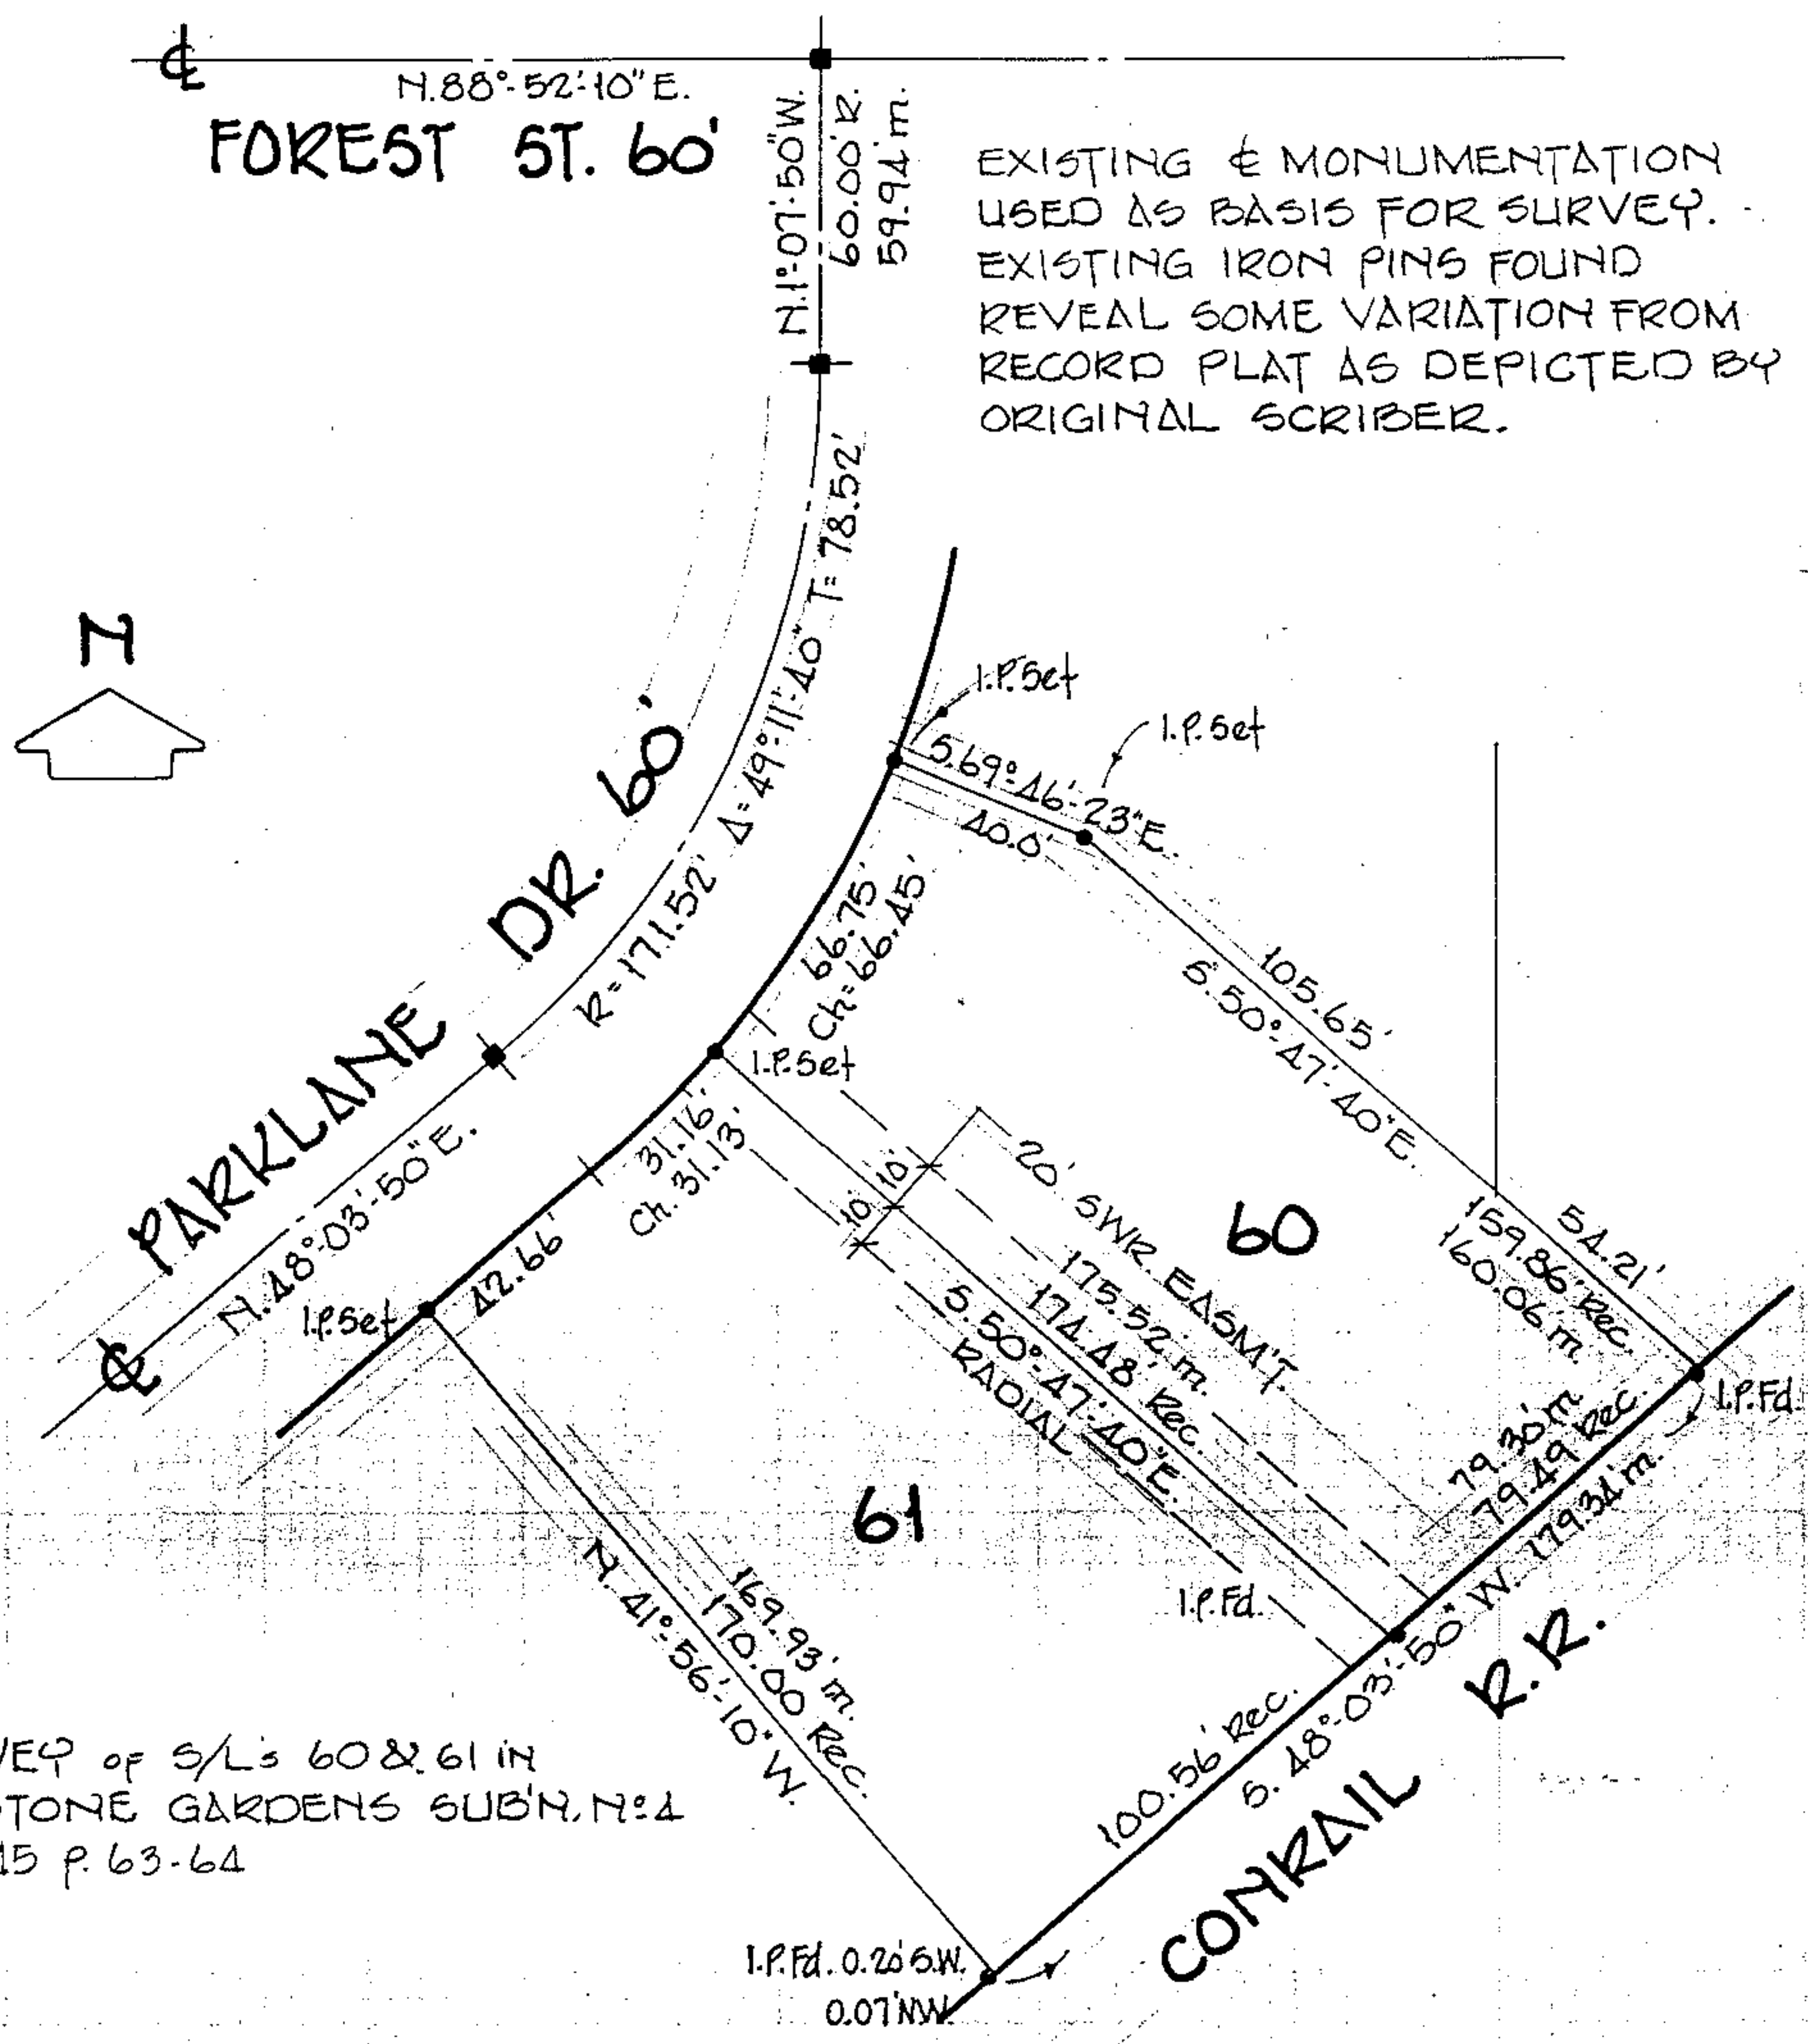

SURVEY of S/L's 60 & 61 IN
KEYSTONE GARDENS SUB'D, N:4
P.V. 45 P. 63-64