

#44780

00-21-005-104-V16, 017
028



LAUNDON • SIMON • CAHL & ASSOC., INC.
CONSULTING ENGINEERS & SURVEYORS
110 MIDDLE AVE. ELYRIA, O. 44035


SURVEY FOR: 6-5

H. LEFF ELECTRIC COMPANY

Orig. Lot	City of	Date March 1995 Scale 1" = 50'
Orig. Sec	Village of	Dwn. by RC Chkd. by RS
Tract	County of	Job No. 95-2706 F.B. 235 P.12
Township of	State of	Printed

N. RIDGE RD.

N. 89° 46' 15" E.

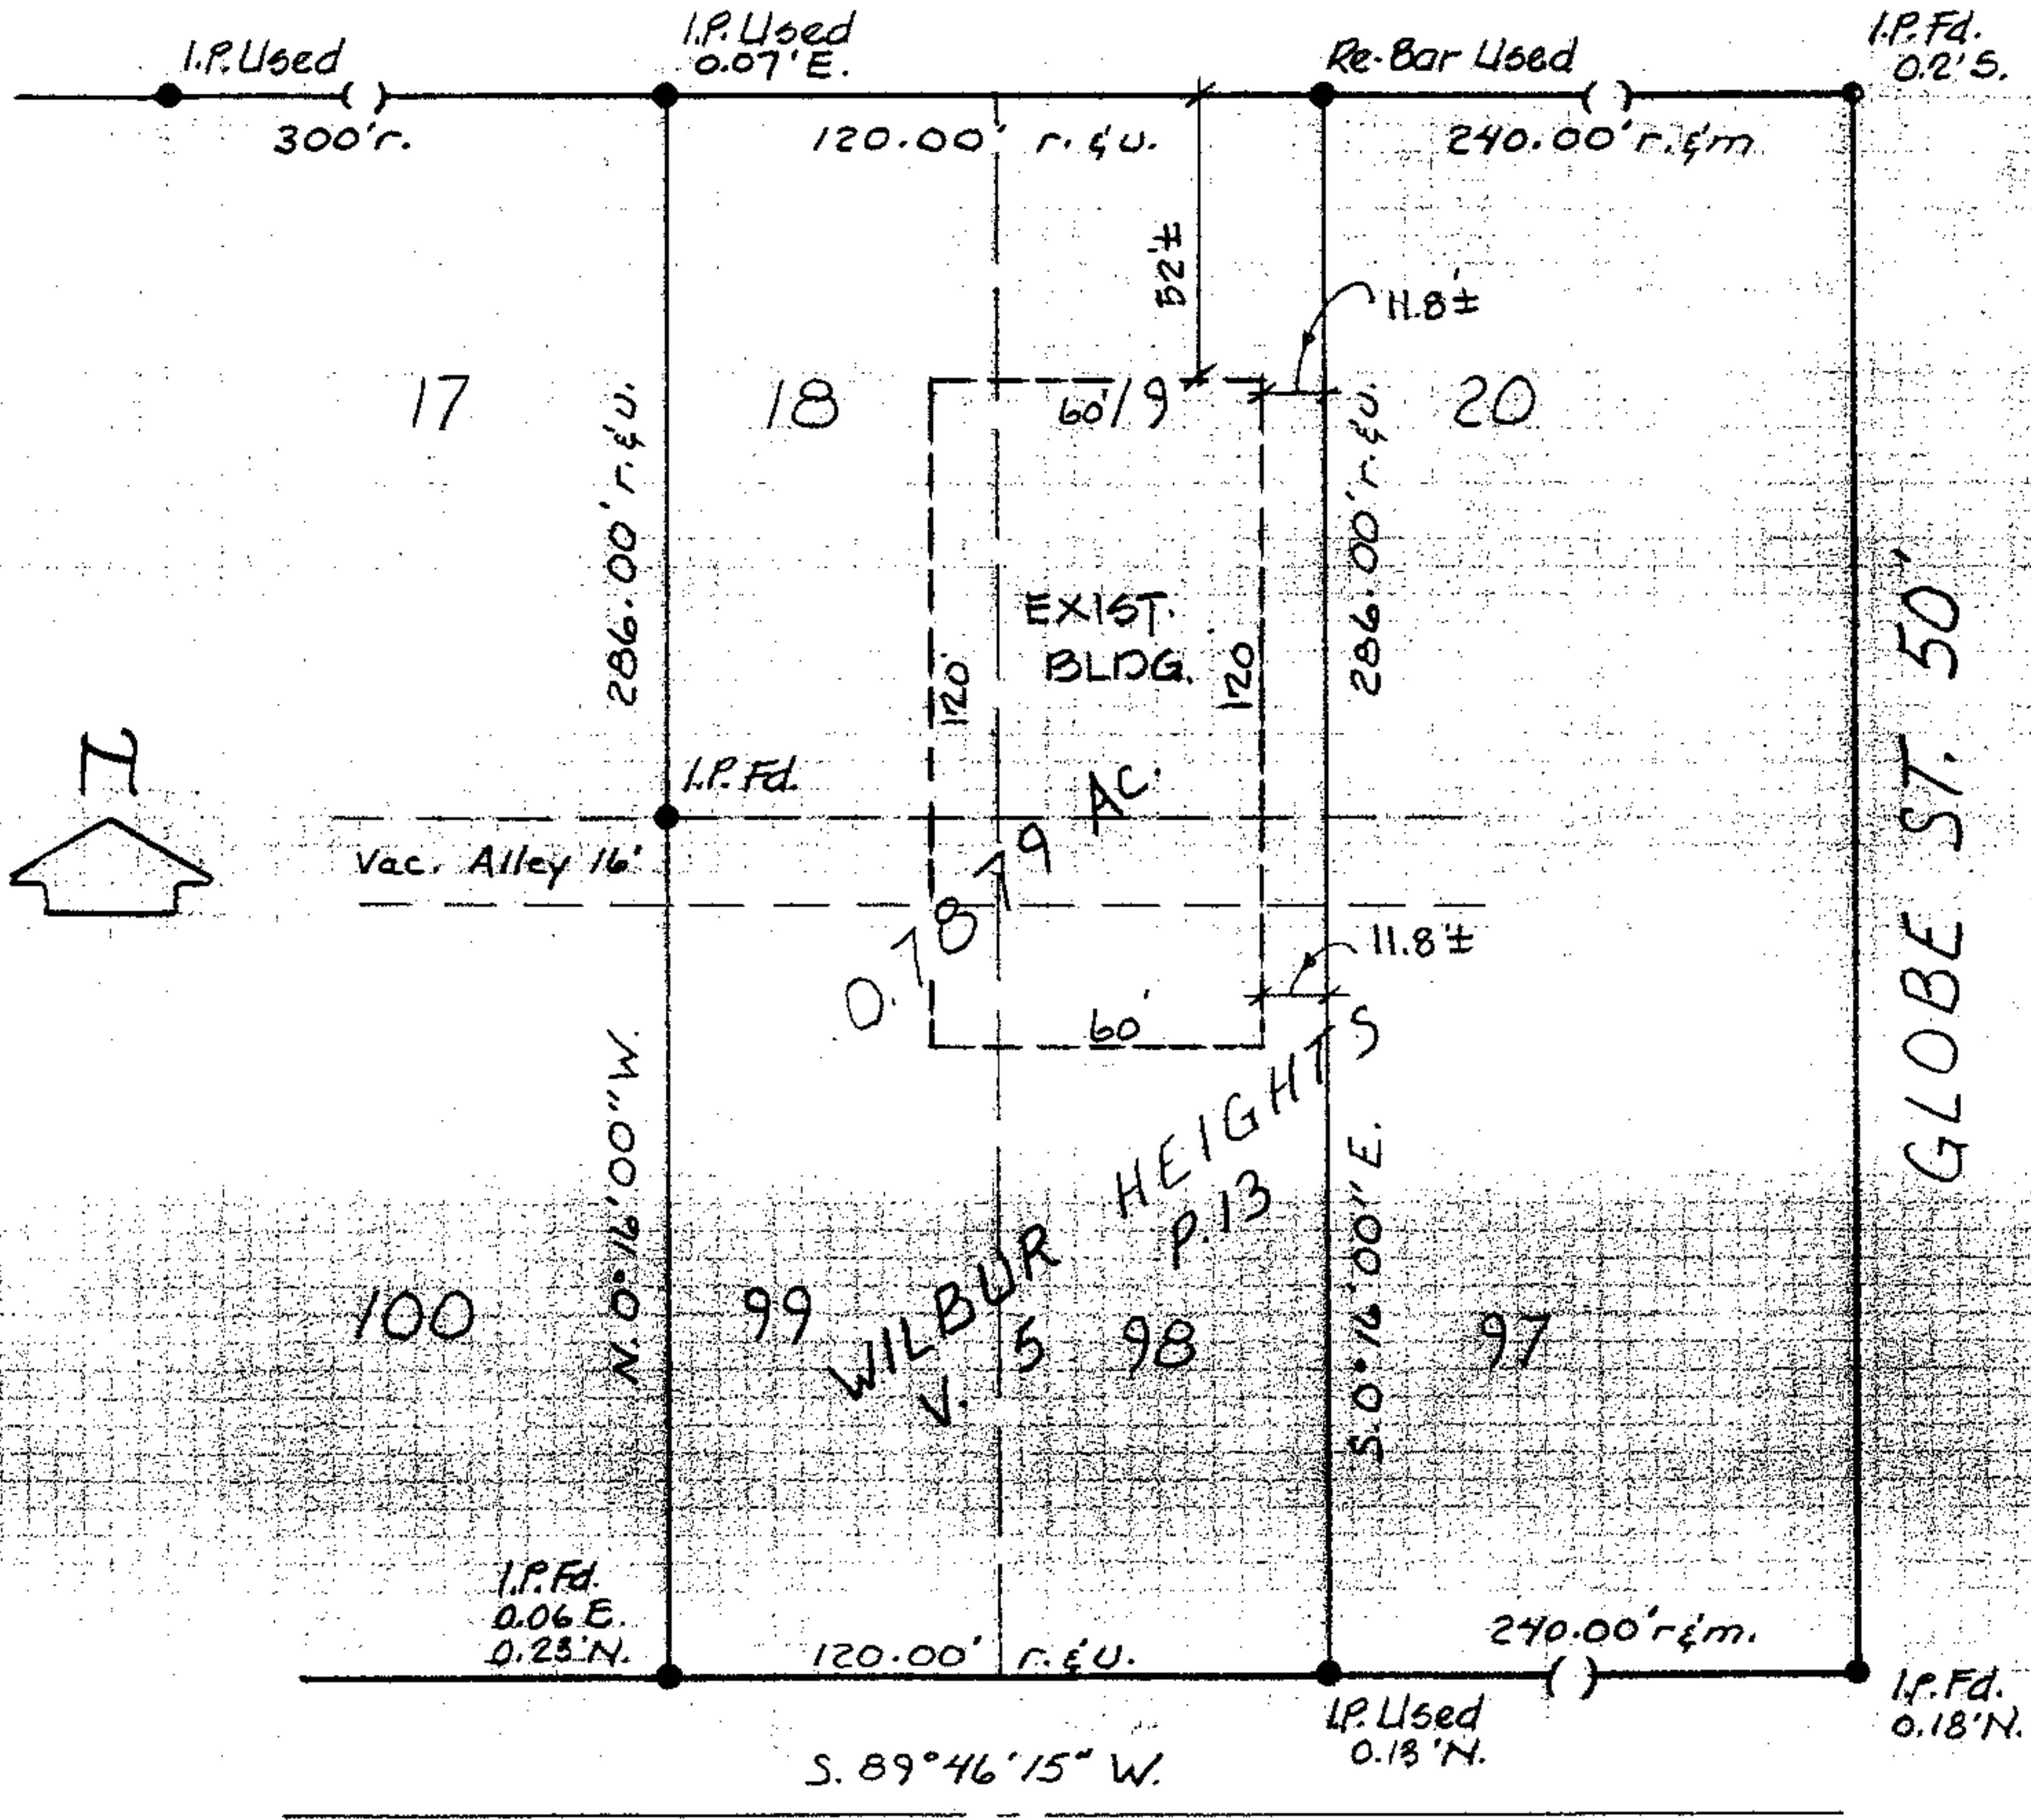

WILBUR AVE. 50'